
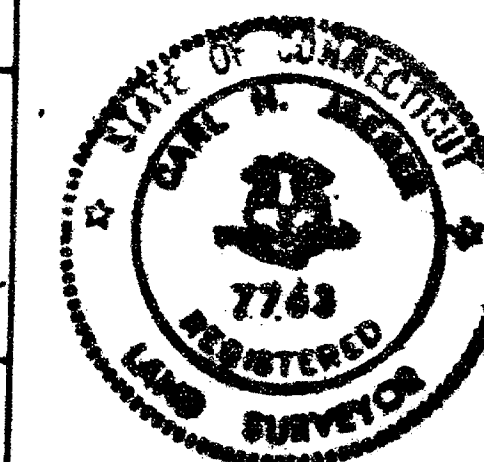


RECEIVED BY
William H. Harty

JUN 7 12 55 PM '89

TOWN & CITY CLERK
 HARTFORD

VOL. _____ PAGE _____

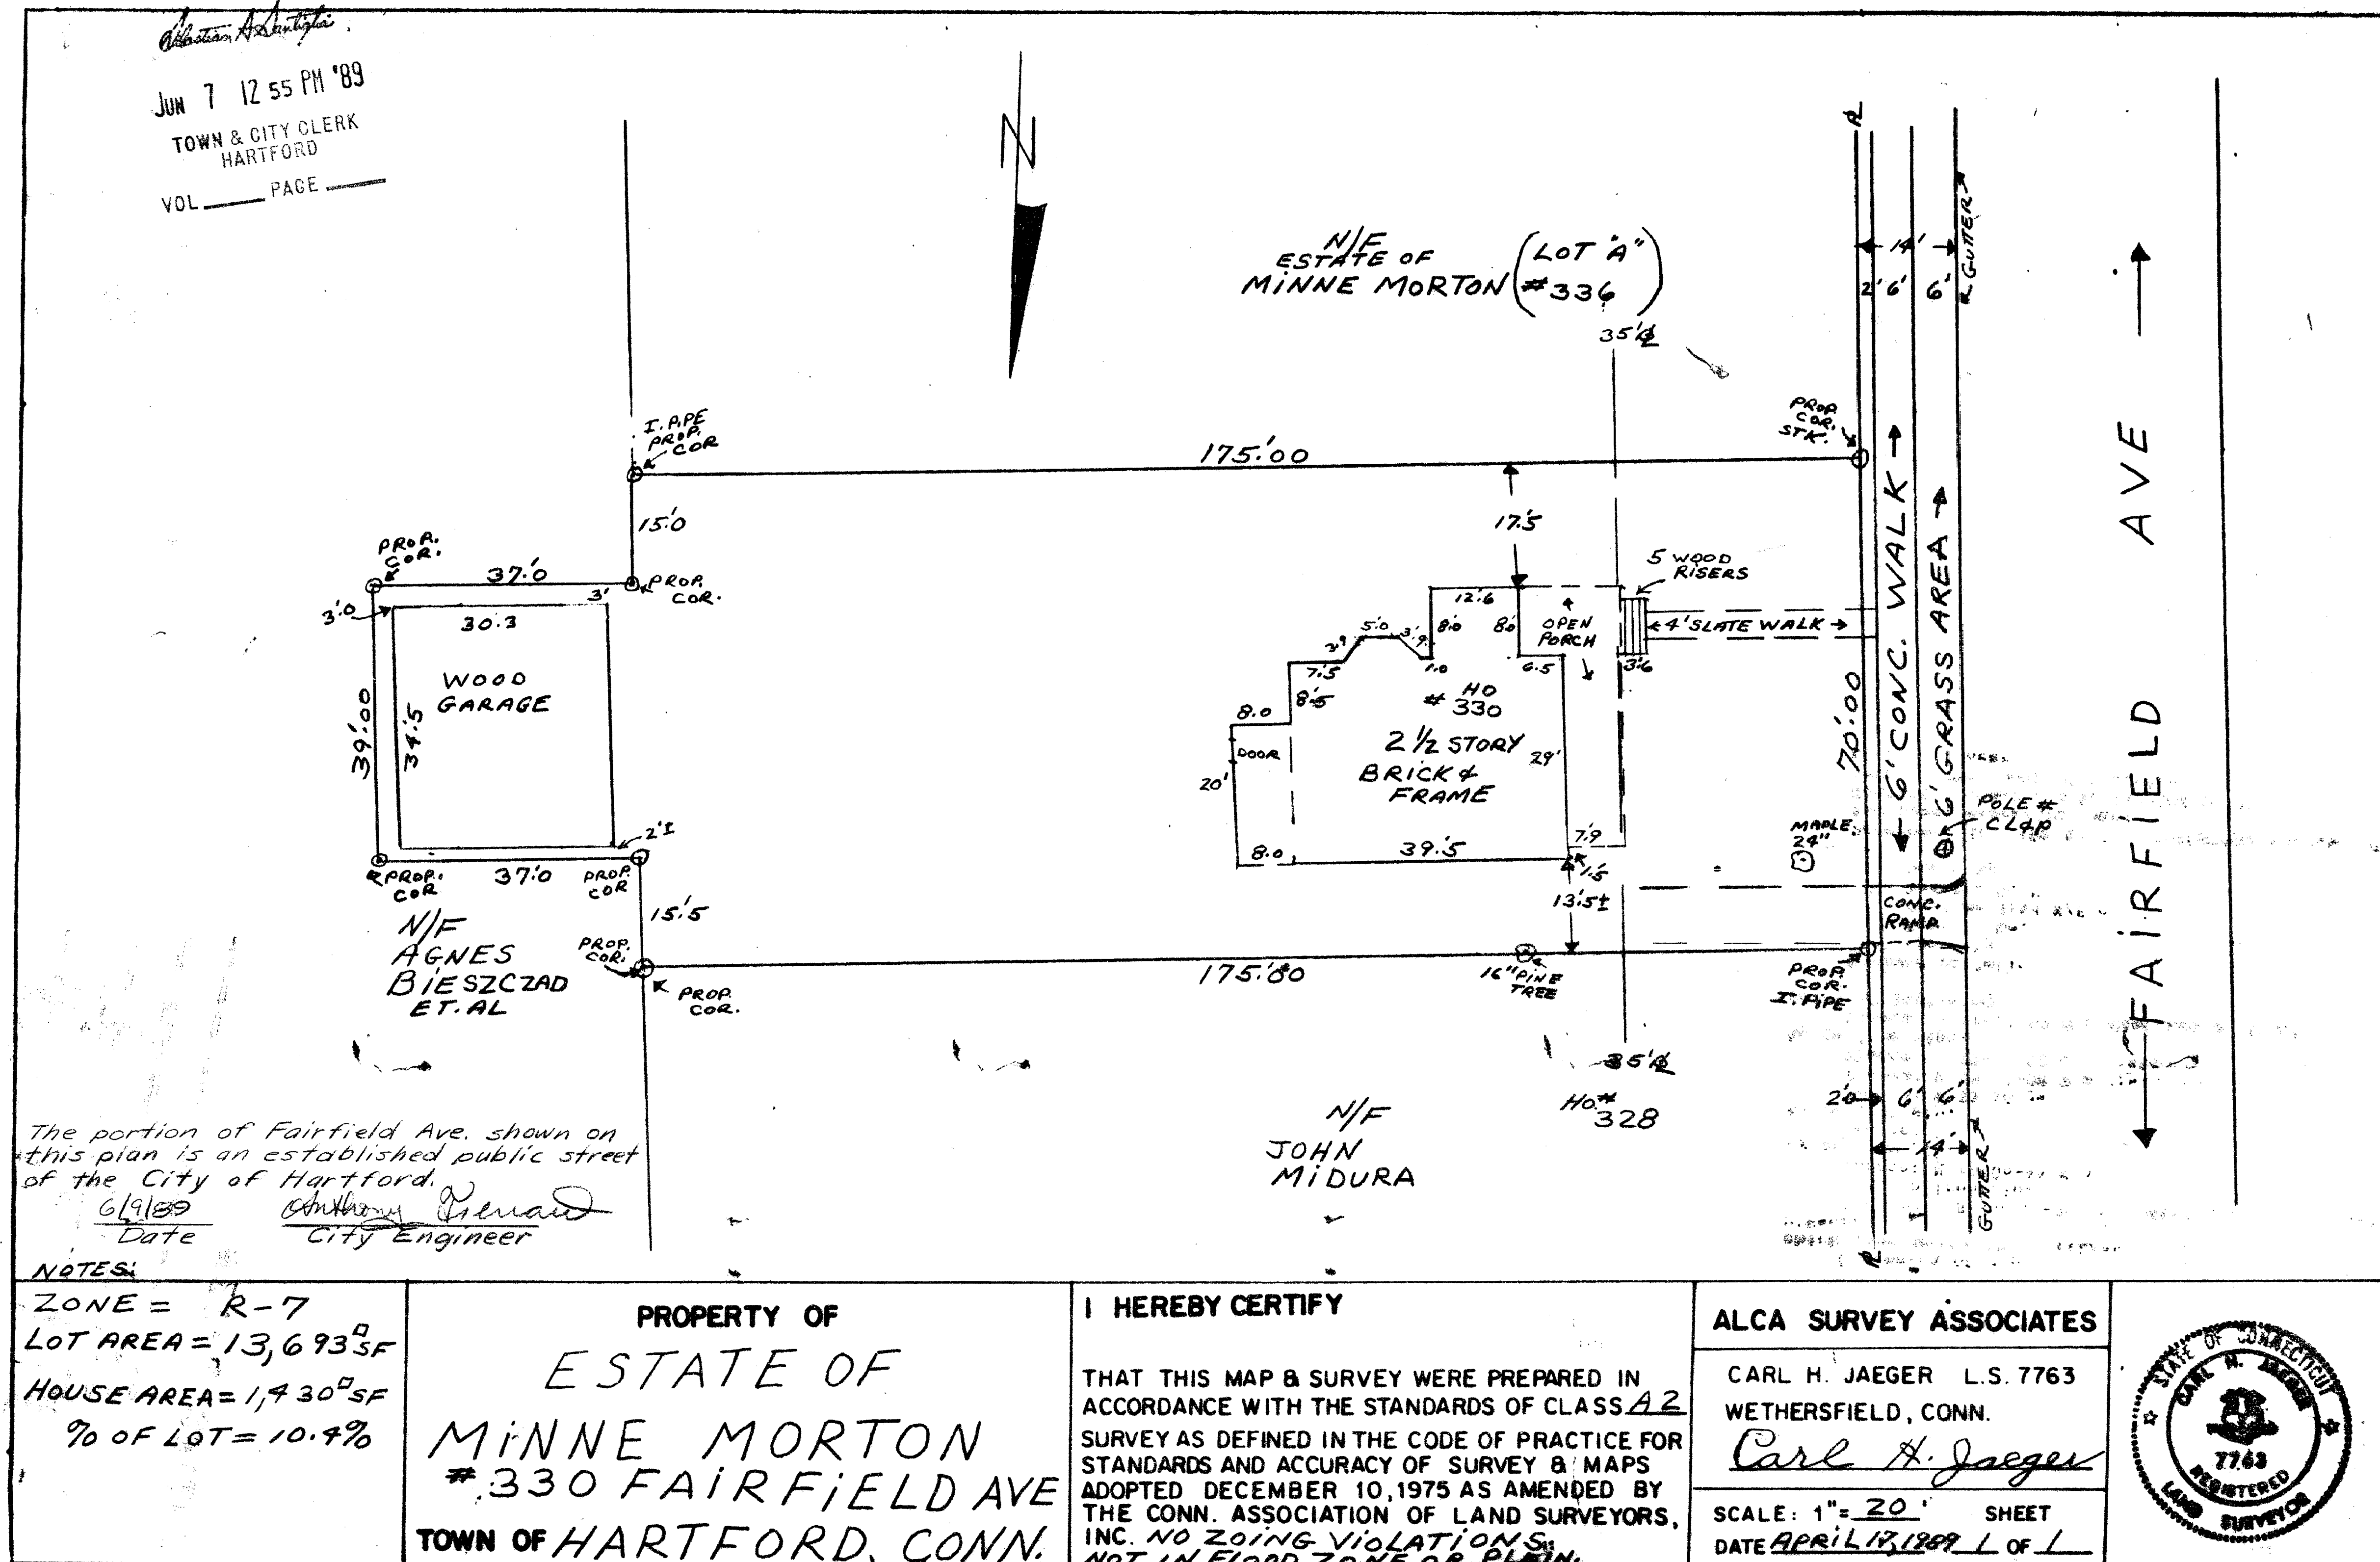

0 INCHES 1 2 3 4