

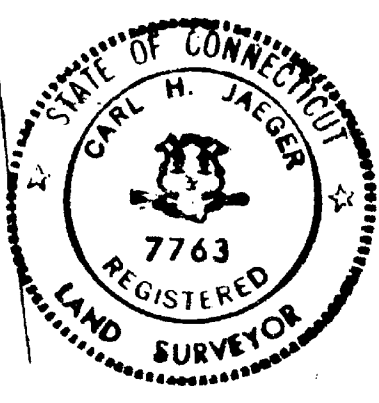


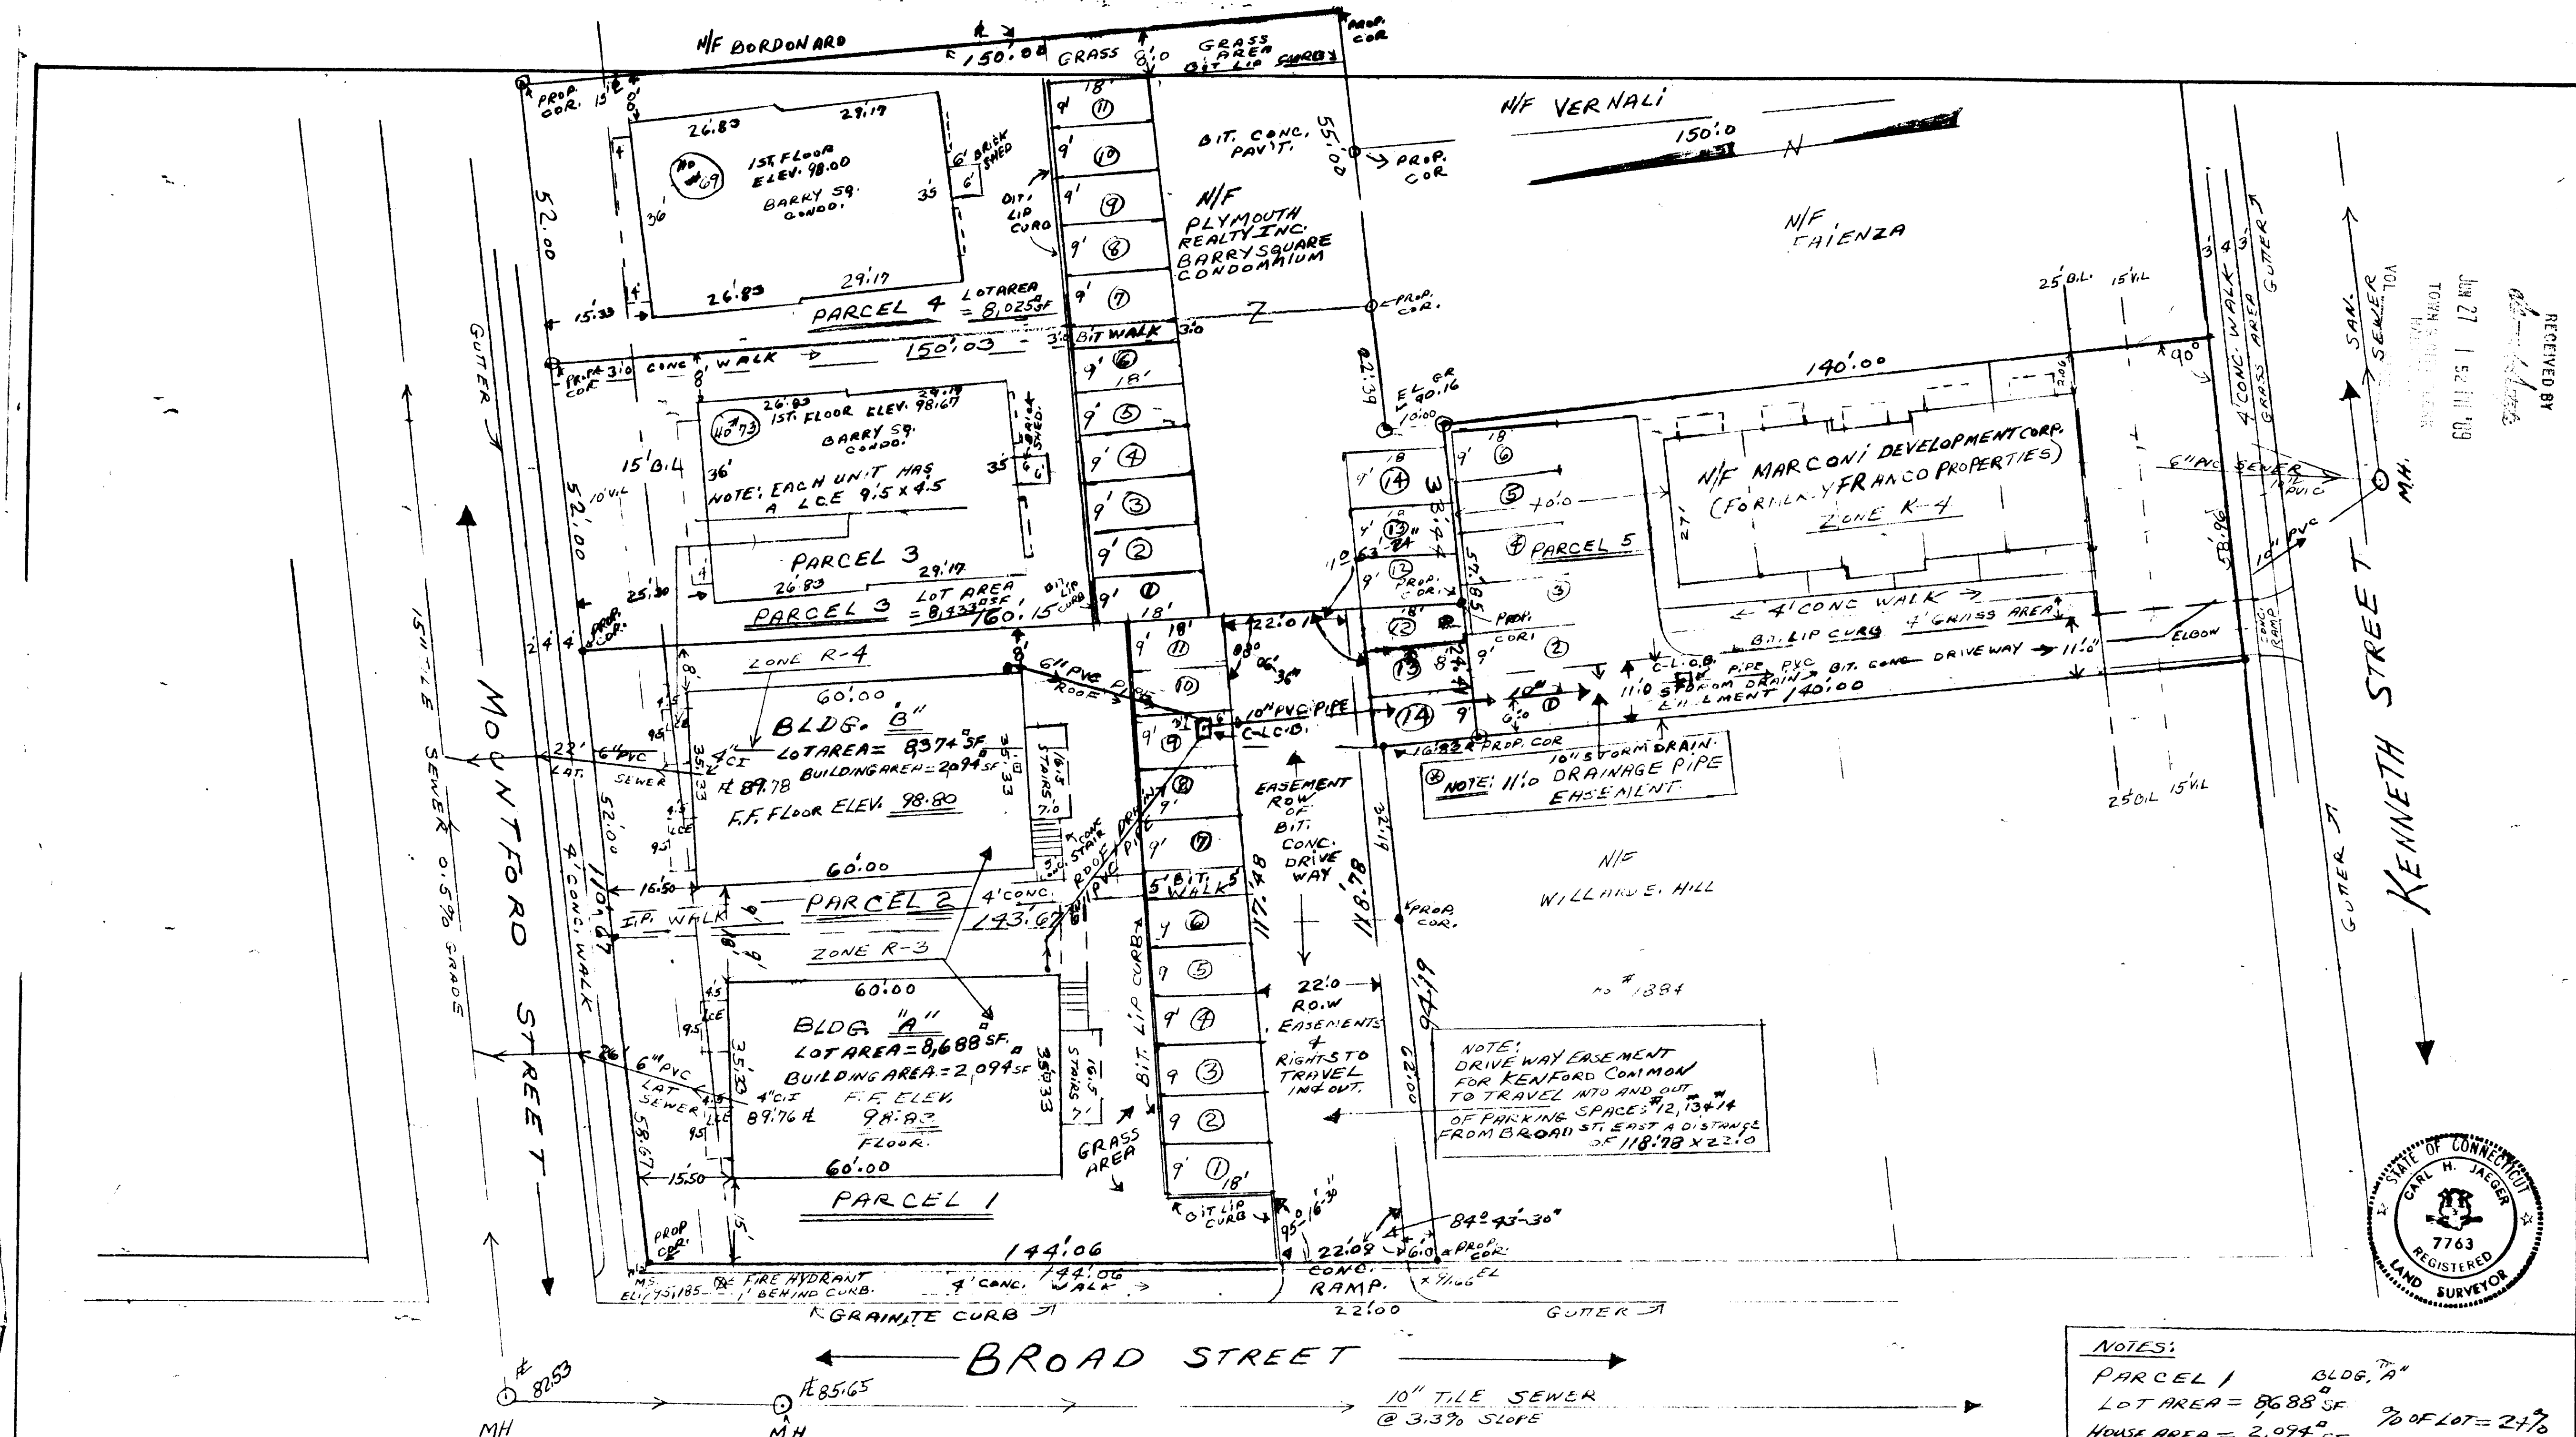

NOTES:
PARCEL 1 BLDG. "A"
PARCEL 2 BLDG. "B"
LOT AREA = 8,374 SF 70% OF LOT = 25%
HOUSE AREA = 2,074 SF

The portions of Mountford St., Broad St. and Kenneth St. shown on this plan are established public streets of the City of Hartford.
7/3/89 Date
City Engineer

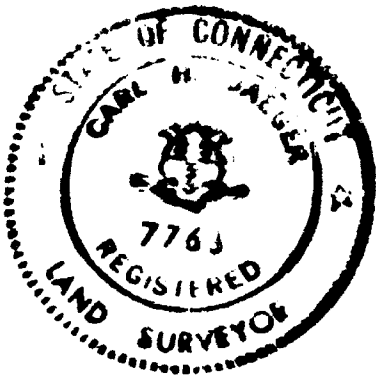

I HEREBY CERTIFY THAT THIS SURVEY CONTAINS ALL OF THE INFORMATION REQUIRED BY SUBSECTION 547-228 (a)(1) AND (4) OF THE COMMON INTEREST OWNERSHIP ACT.
Carl H. Jaeger #7763
REGISTERED LAND SURVEYOR CONN.
12/26/1987

PROPERTY OF
MARCONI DEVELOPMENT CORPORATION
KENFORD COMMON # BARRY SQUARE CONDO
SHOWING PARCELS 1, 2, 3, 4, 5 WITH EASEMENT
FOR DRIVEWAY AND DRAINAGE
MOUNTFORD & BROAD STREET
AND KENNETH STREET
TOWN OF HARTFORD, CONN.

I HEREBY CERTIFY
THAT THIS MAP & SURVEY WERE PREPARED IN ACCORDANCE WITH THE STANDARDS OF CLASS A-2 SURVEY AS DEFINED IN THE CODE OF PRACTICE FOR STANDARDS AND ACCURACY OF SURVEY & MAPS ADOPTED DECEMBER 10, 1975 AS AMENDED BY THE CONN. ASSOCIATION OF LAND SURVEYORS, INC. ZONE R-4 & R-3

(DECLARATION SCHEDULE A-3)
SURVEY UP DATE 12/26/1987

ALCA SURVEY ASSOCIATES
CARL H. JAEGER L.S. 7763
WETHERFIELD, CONN.
Carl H. Jaeger L.S. 7763
SCALE: 1" = 20' SHEET
DATE: 6/30/85 1 OF 1



1861 41

EASEMENT - UPDATED 12/26/1987

