
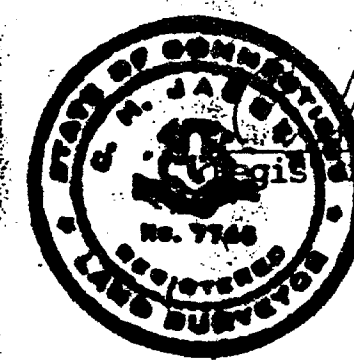


RECEIVED BY
JUL 14 3 33 PM '89
TOWN ENGINEER
VOL. 1867

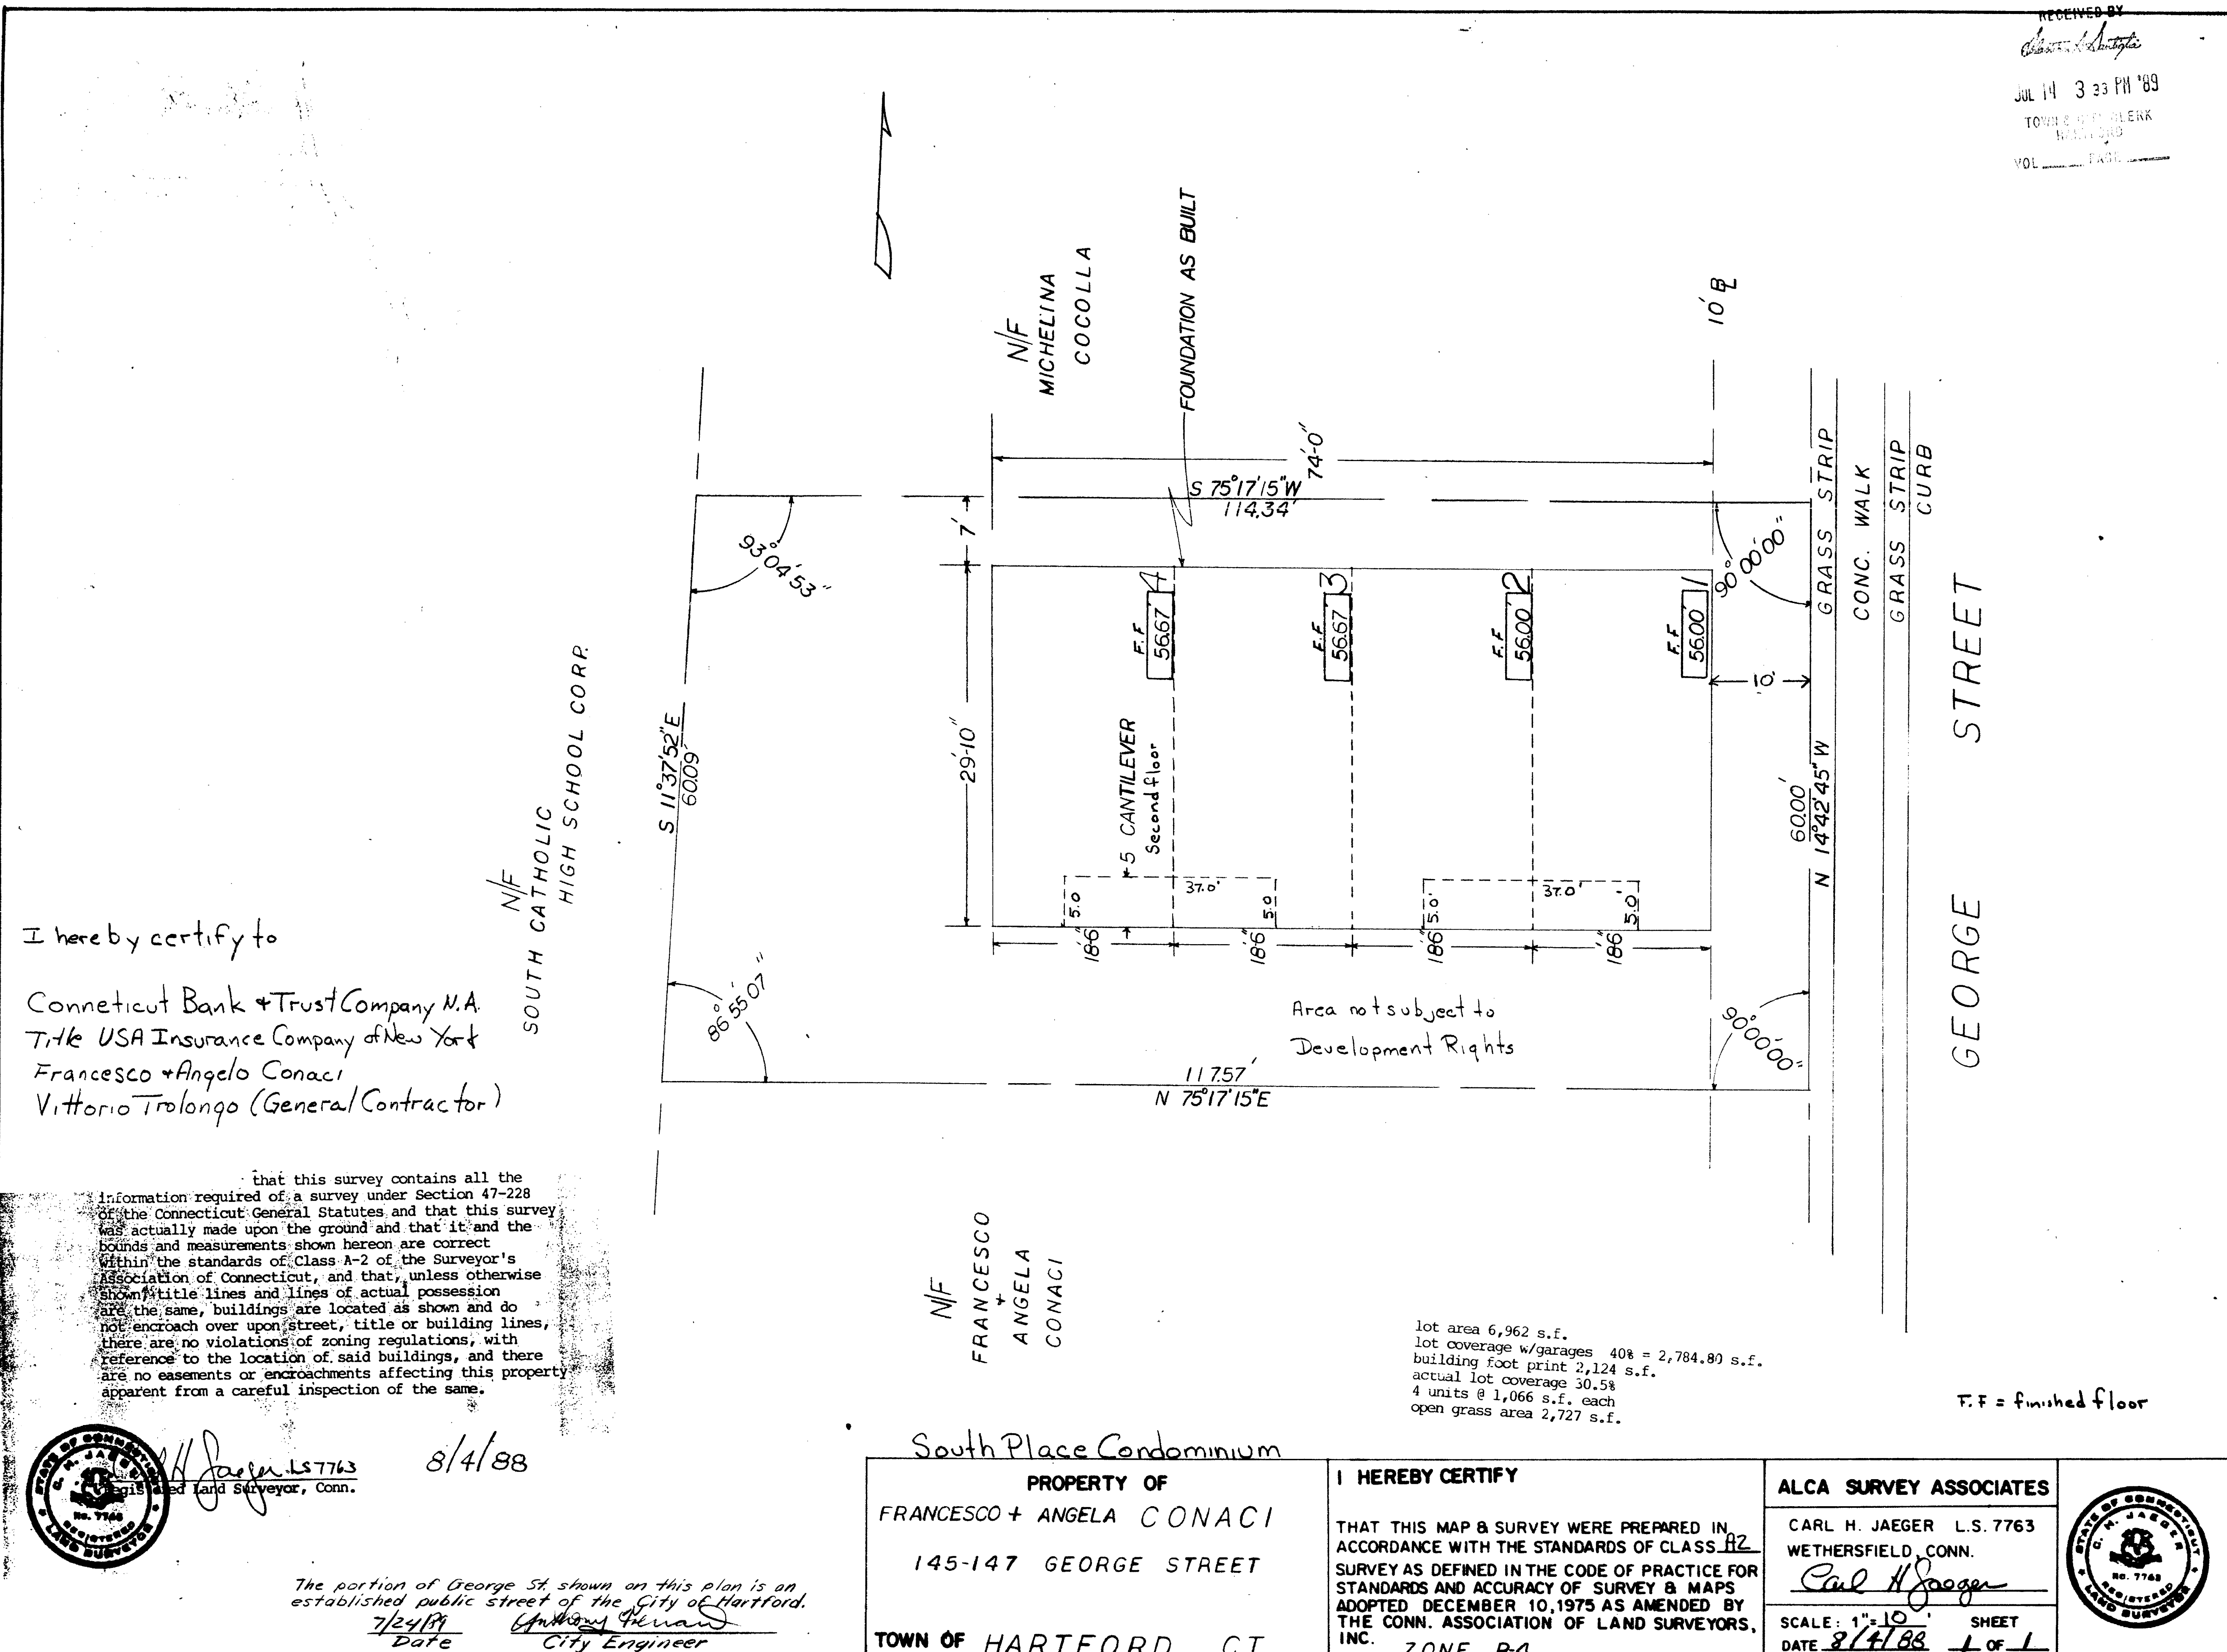

Carl H. Jaeger L.S. 7763
Registered Land Surveyor, Conn.

8/4/88

The portion of George St. shown on this plan is an established public street of the City of Hartford.
7/24/89 Date City Engineer

