


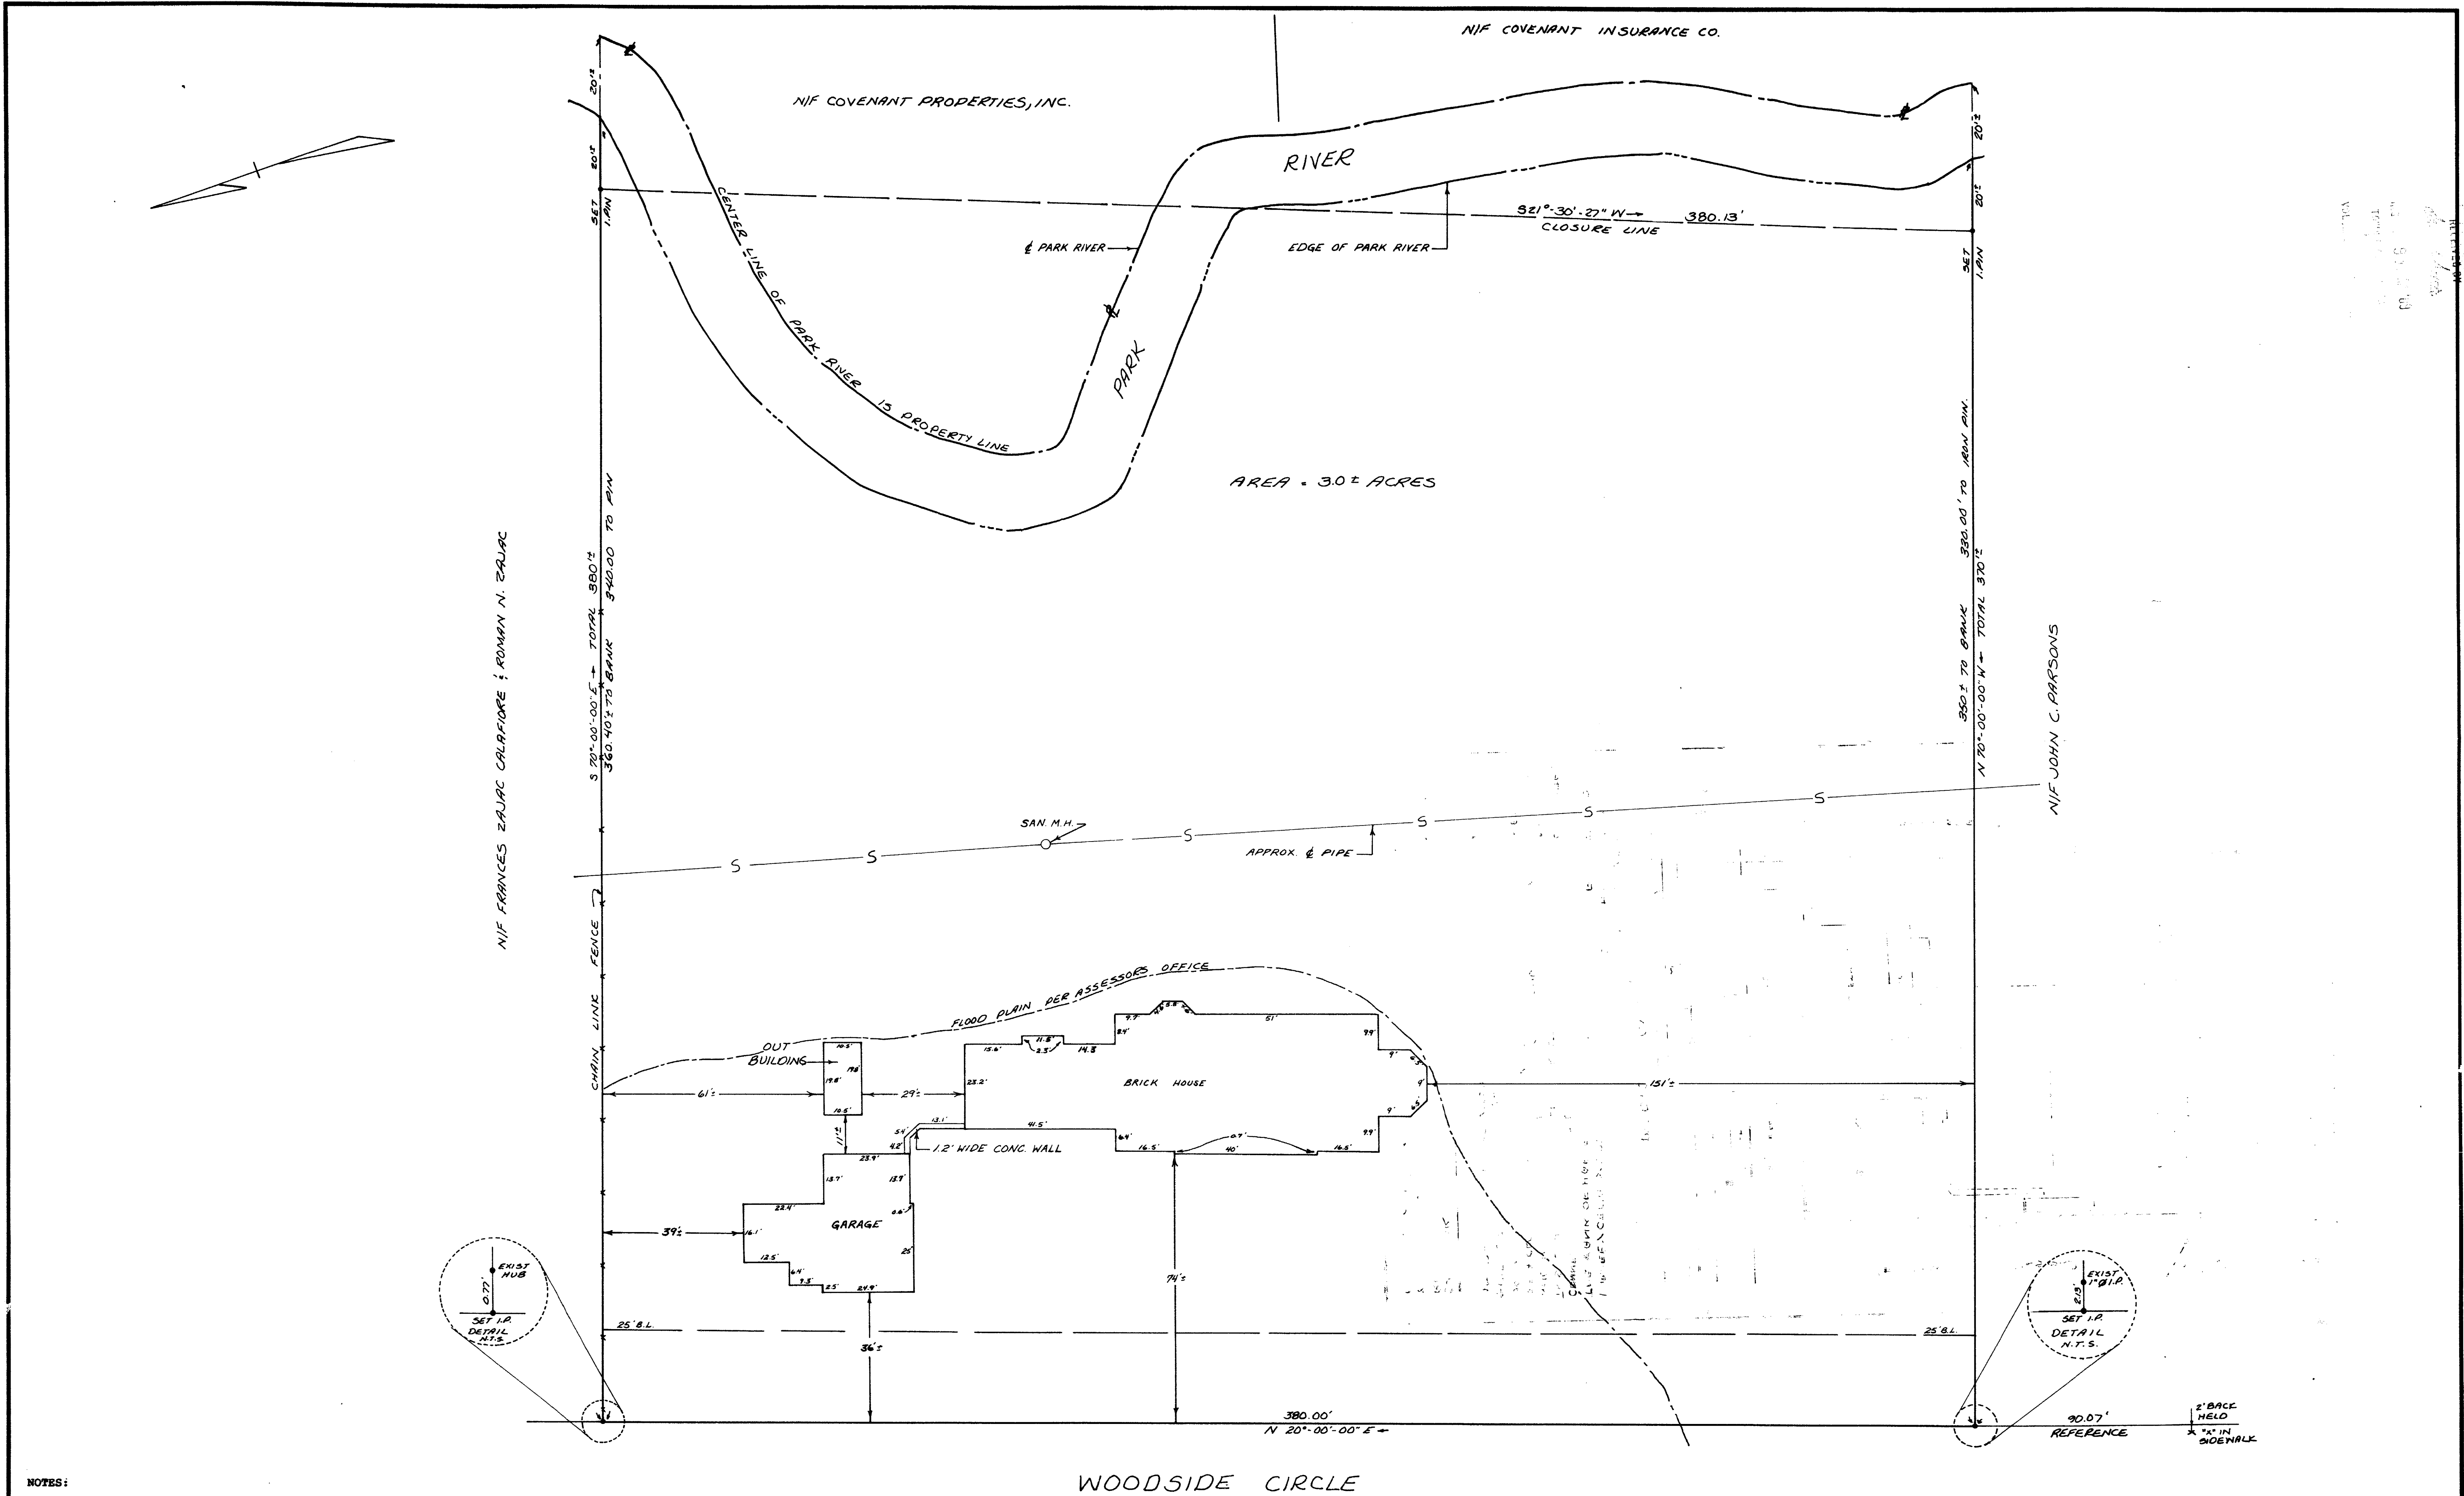

- NOTES:
- BOUNDARY INFORMATION TAKEN, IN PART, FROM A PLAN TITLED "WOODSIDE CIRCLE PROPERTY OF W.L. J.L. & P. GOODWIN HARTFORD, CT SCALE 1" = 40' AUG. 1923 BUCK & SHELDON, C.E. HARTFORD, CT."
 - DEED REFERENCE IS TO VOLUME 1334, PAGE 53 OF THE HARTFORD LAND RECORDS.
 - HOUSE, GARAGE AND OUTBUILDING LOCATED AS SHOWN, NO ZONING VIOLATIONS WITH RESPECT TO THEIR LOCATION.
 - SANITARY SEWER SUBJECT TO RIGHT AS OUTLINED IN VOLUME 1334 PAGE 53 OF THE HARTFORD LAND RECORDS.

The portion of Woodside Circle shown on this plan is an established public street of the City of Hartford.

Date 8/1/89 City Engineer Anthony Peter & Janice B. Parrotta

CERTIFIED TO CHARLES B. MILLIKEN AND THE CONNECTICUT BANK AND TRUST COMPANY, N.A., CO-TRUSTEES U/A GENEVIEVE H. GOODWIN DATED JANUARY 5, 1972, AS AMENDED, BLACKWORTH INTEREST, ANTHONY P. PARROTTA AND JANICE B. PARROTTA AND TICOR VELA INSURANCE COMPANY.



DATE	REVISION
7-19-89	CERTIFICATION
7-19-89	CLOSURE LINE

ed
and associates

BOUNDARY PLAN
PREPARED FOR
ANTHONY PETER & JANICE B. PARROTTA
10 & 12 WOODSIDE CIRCLE
HARTFORD, CONNECTICUT

