
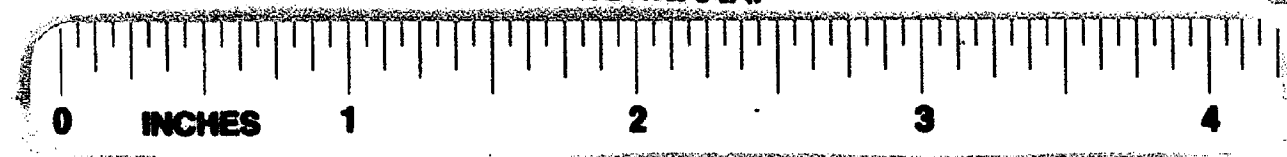


1870

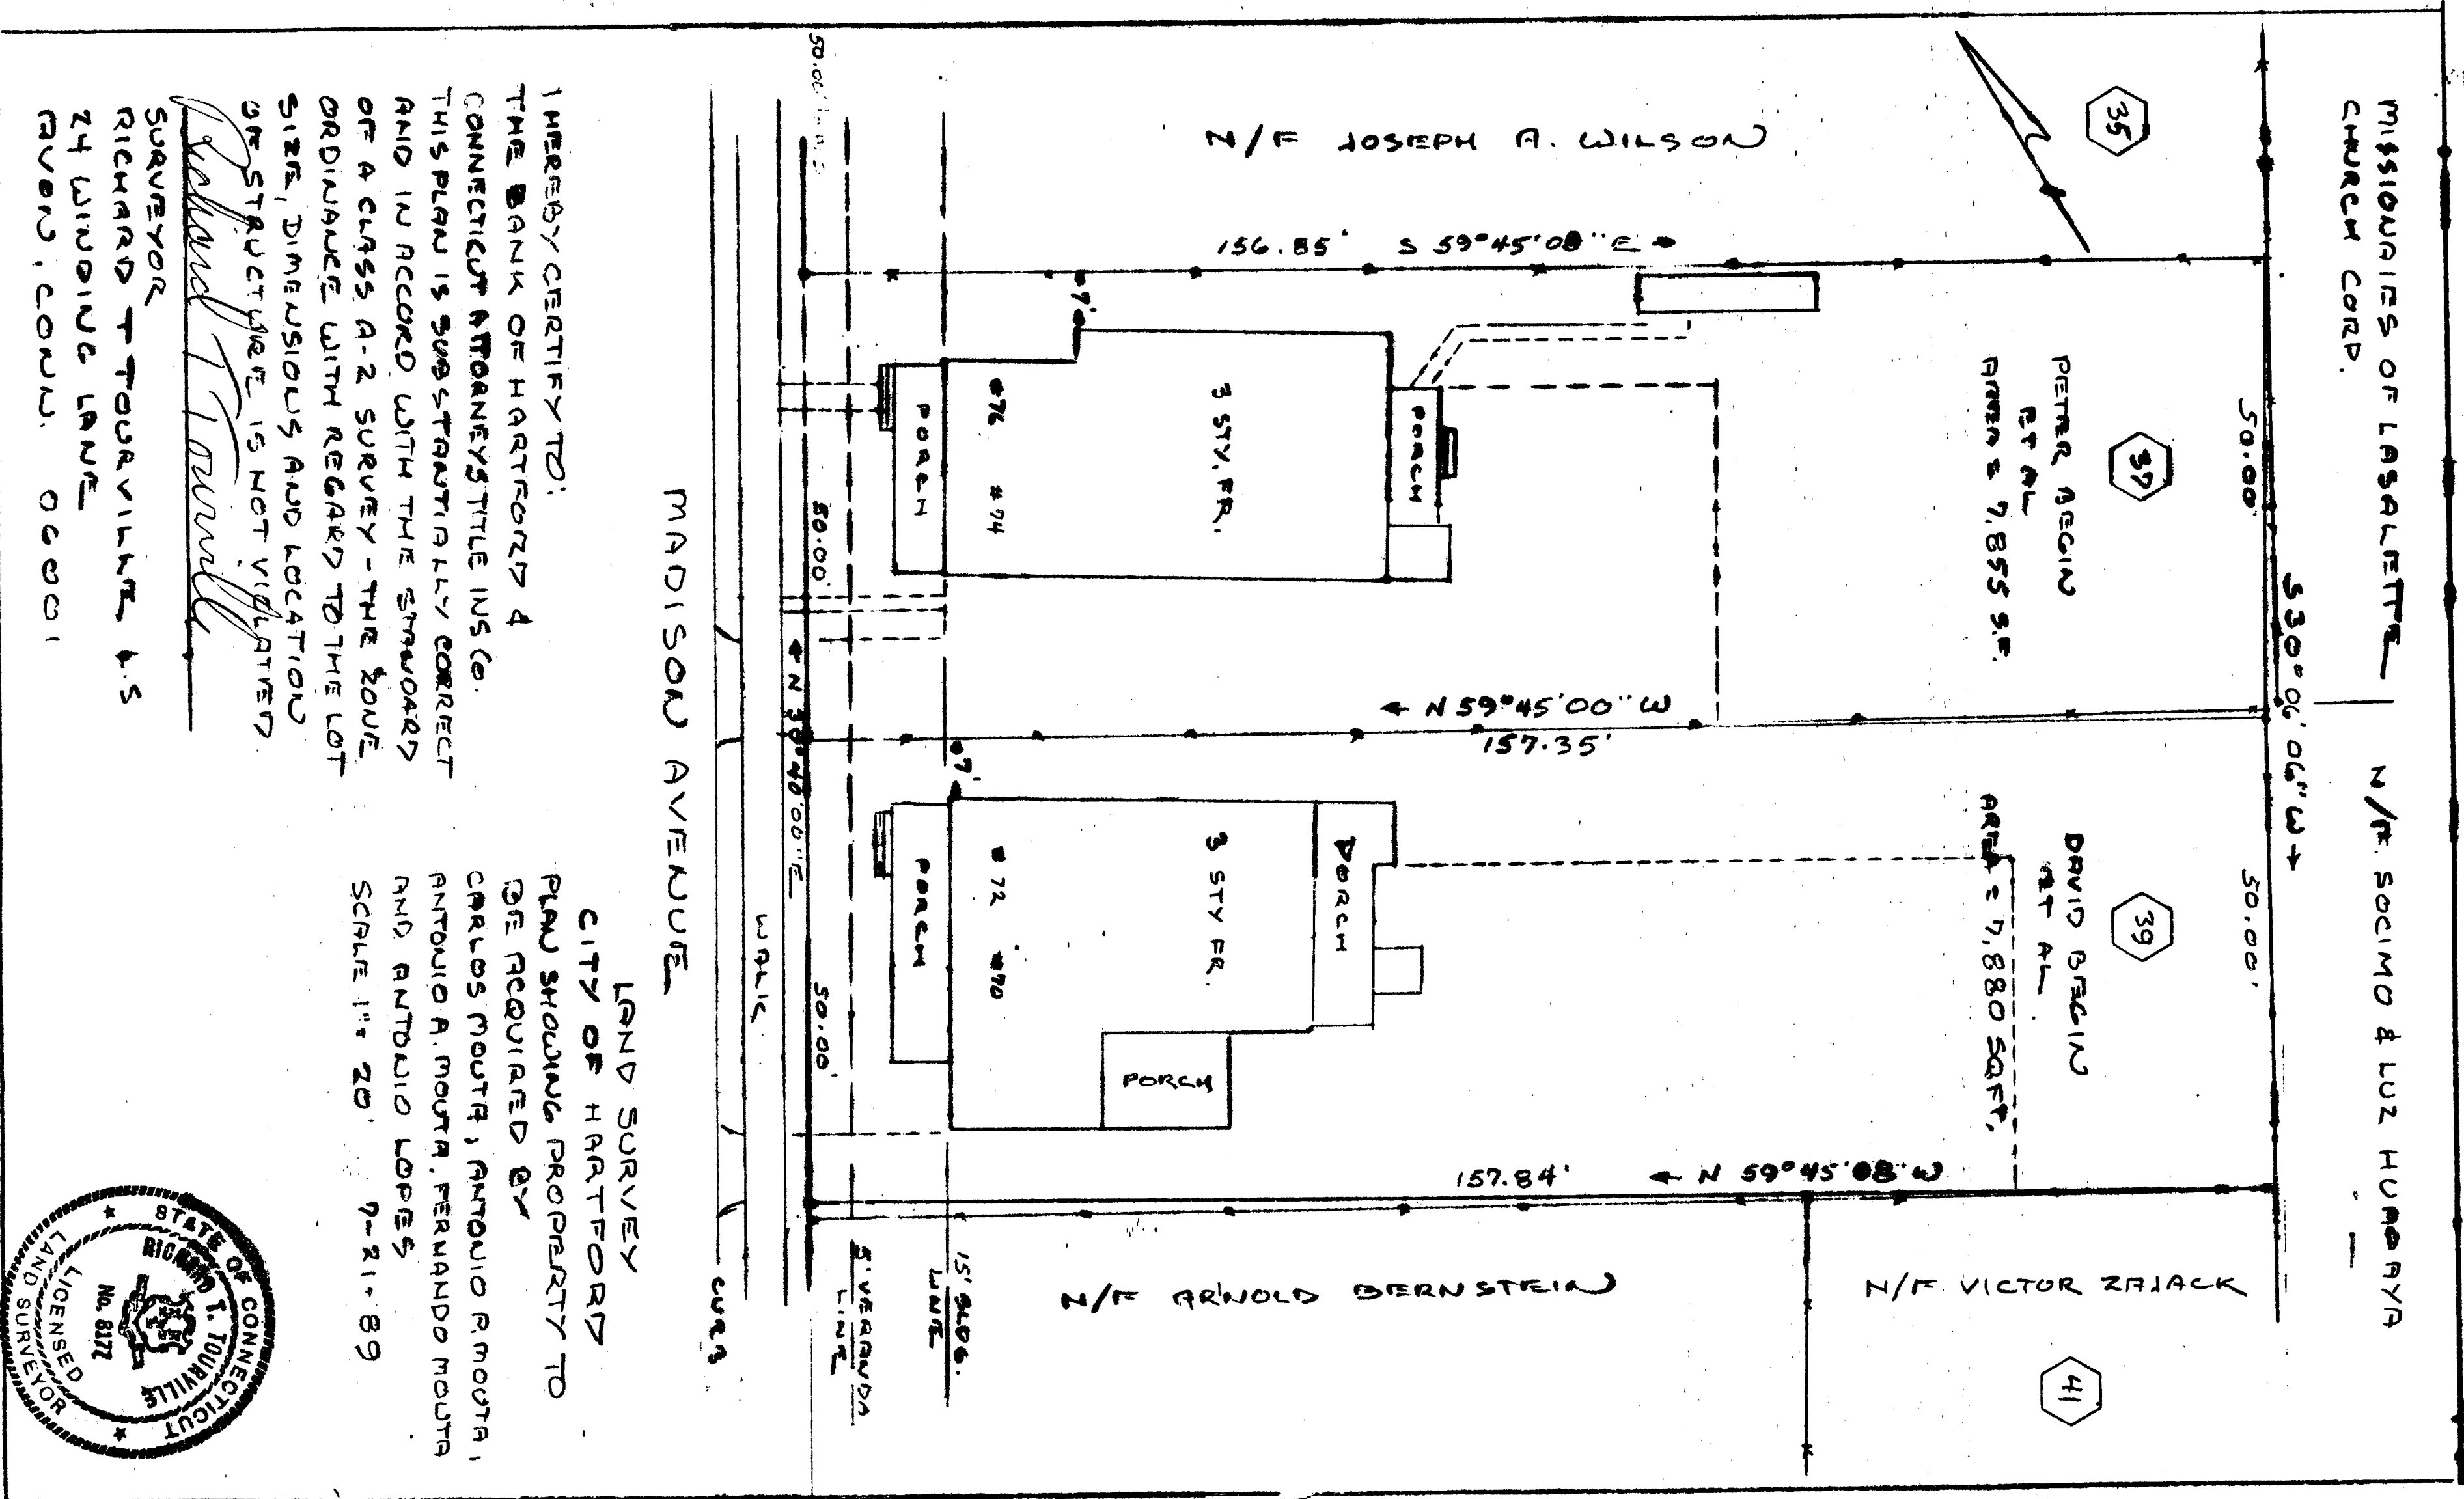

RECEIVED BY
TOWN & CITY OF HEN
AUG 22 2 47 PM '89

1870