


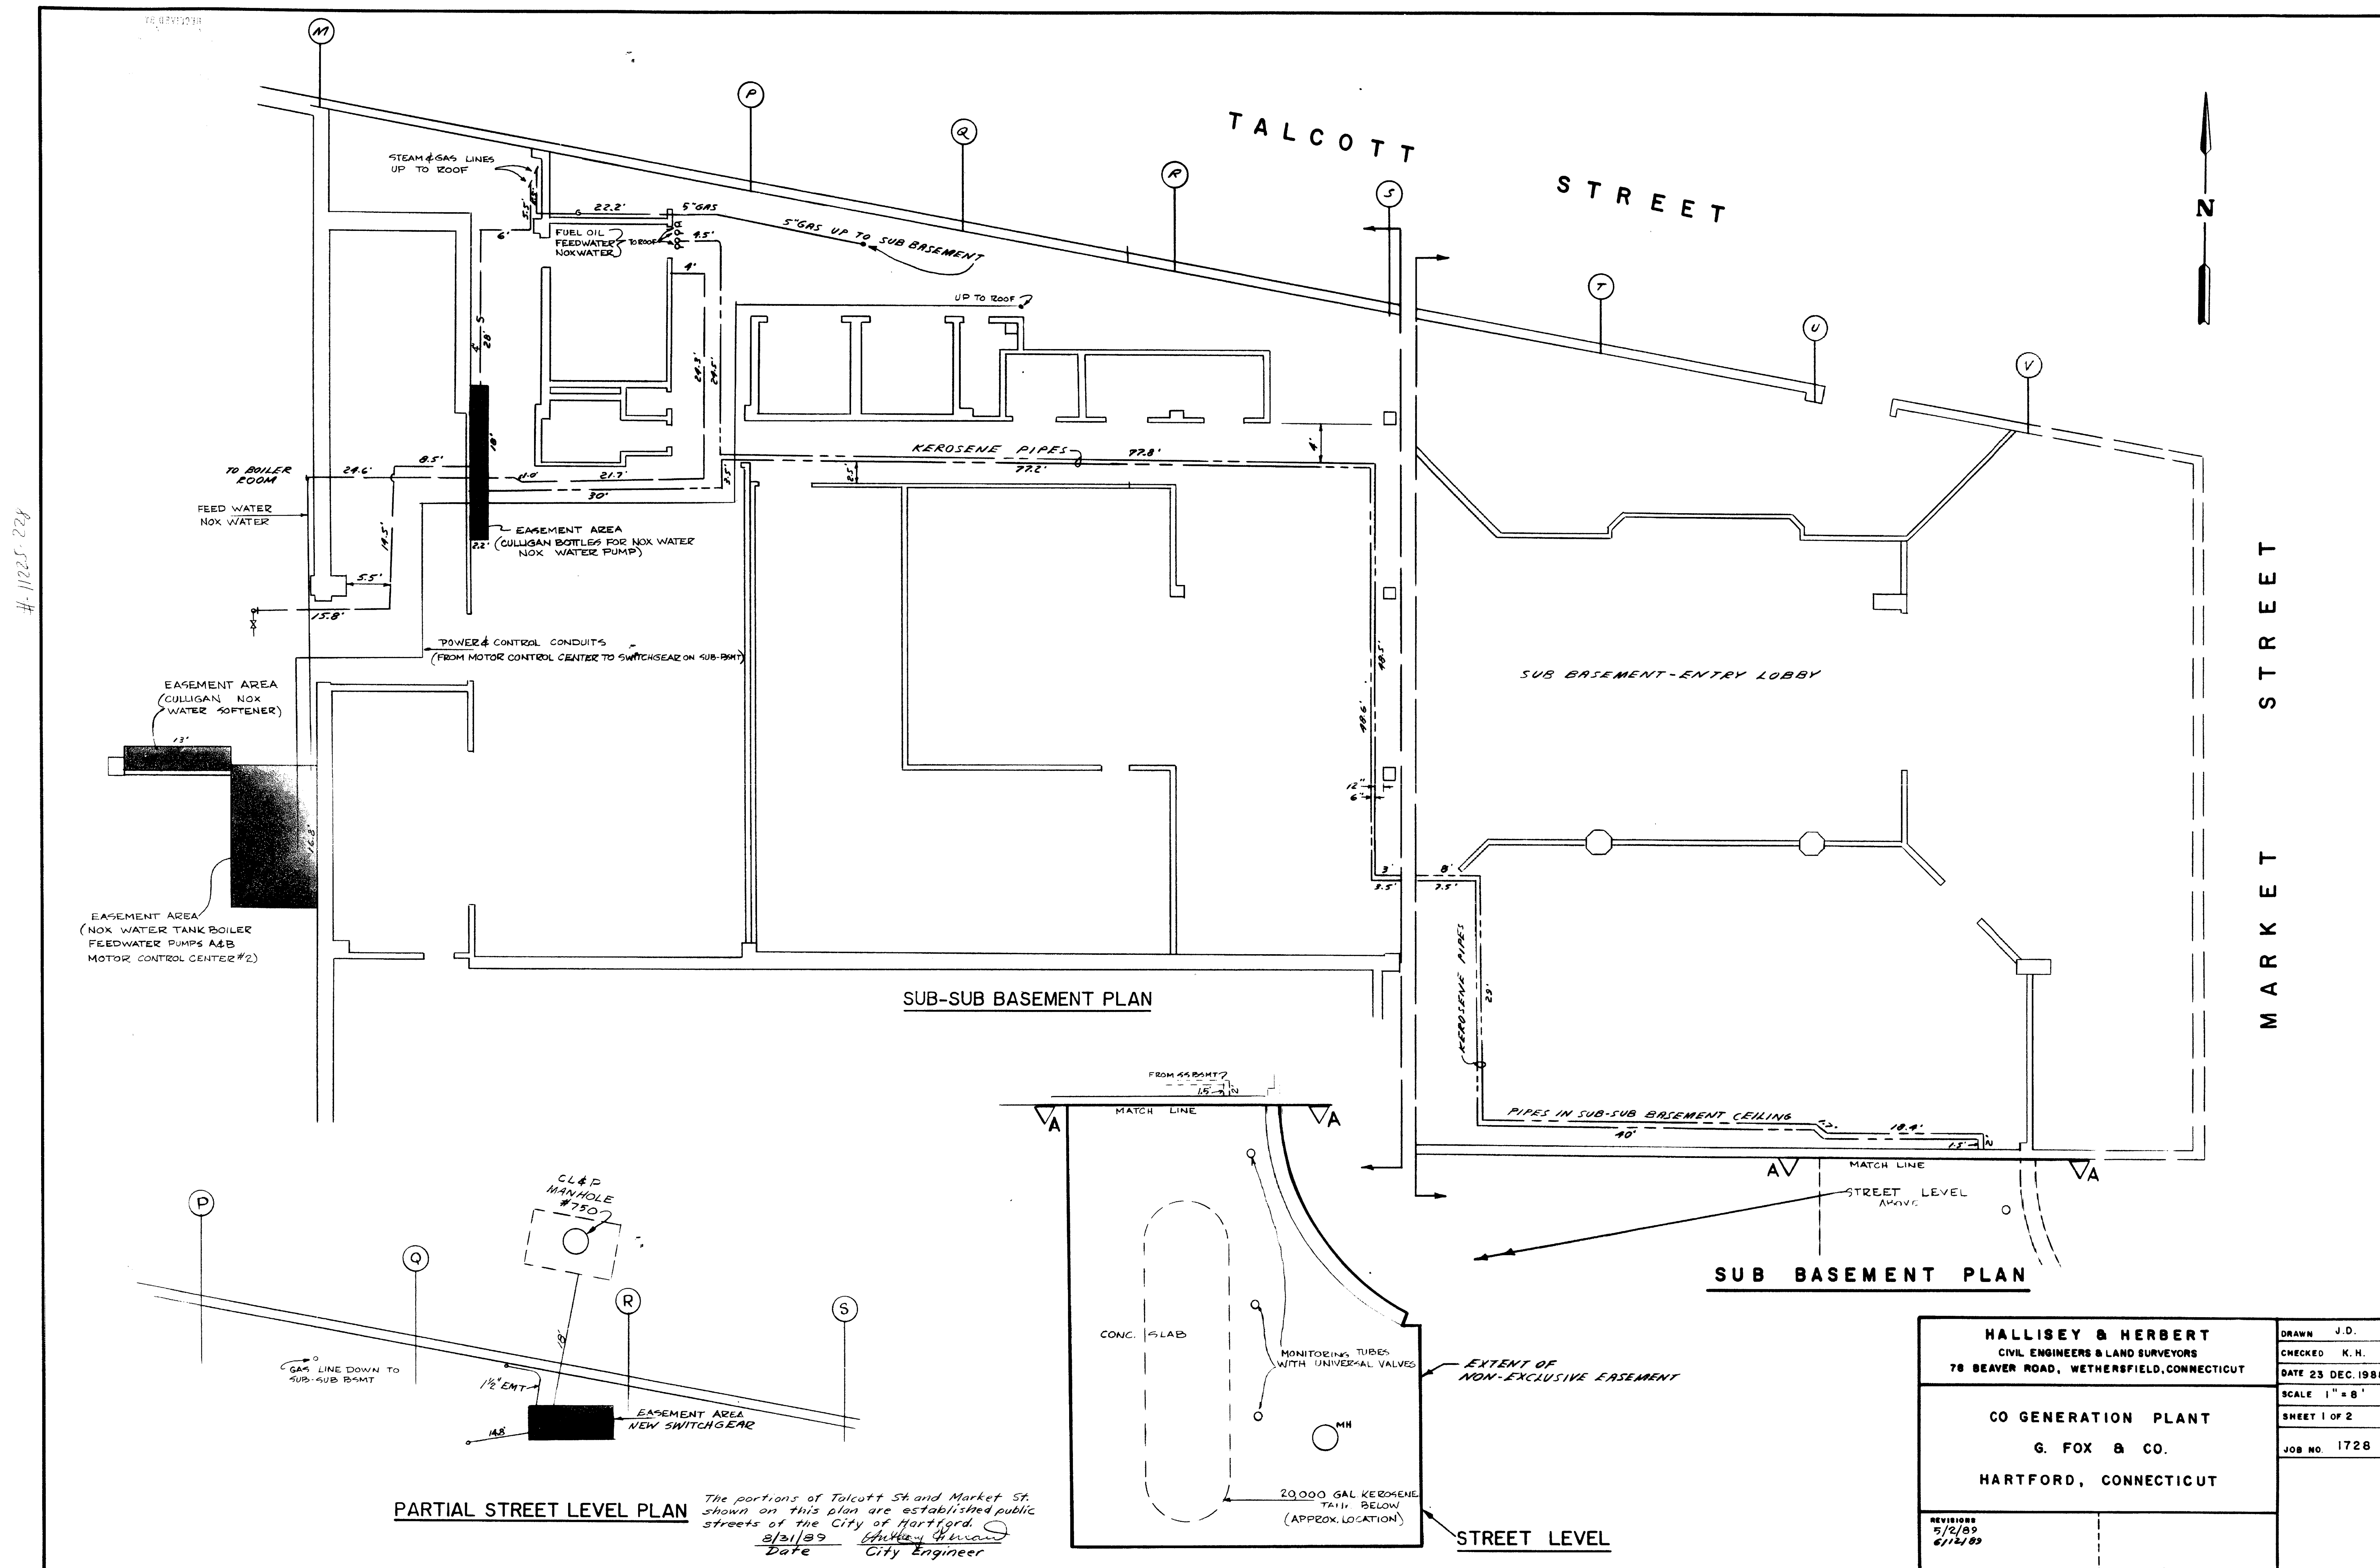

HALLISEY & HERBERT CIVIL ENGINEERS & LAND SURVEYORS 78 BEAVER ROAD, WETHERSFIELD, CONNECTICUT	DRAWN J.D.
	CHECKED K.H.
	DATE 23 DEC. 1988
	SCALE 1" = 8'
CO GENERATION PLANT G. FOX & CO. HARTFORD, CONNECTICUT	SHEET 1 OF 2
	JOB NO. 1728
REVISIONS 5/12/89 6/14/89	

