


1882-3

11225-22f

10 03113334
6 10 10 10 10

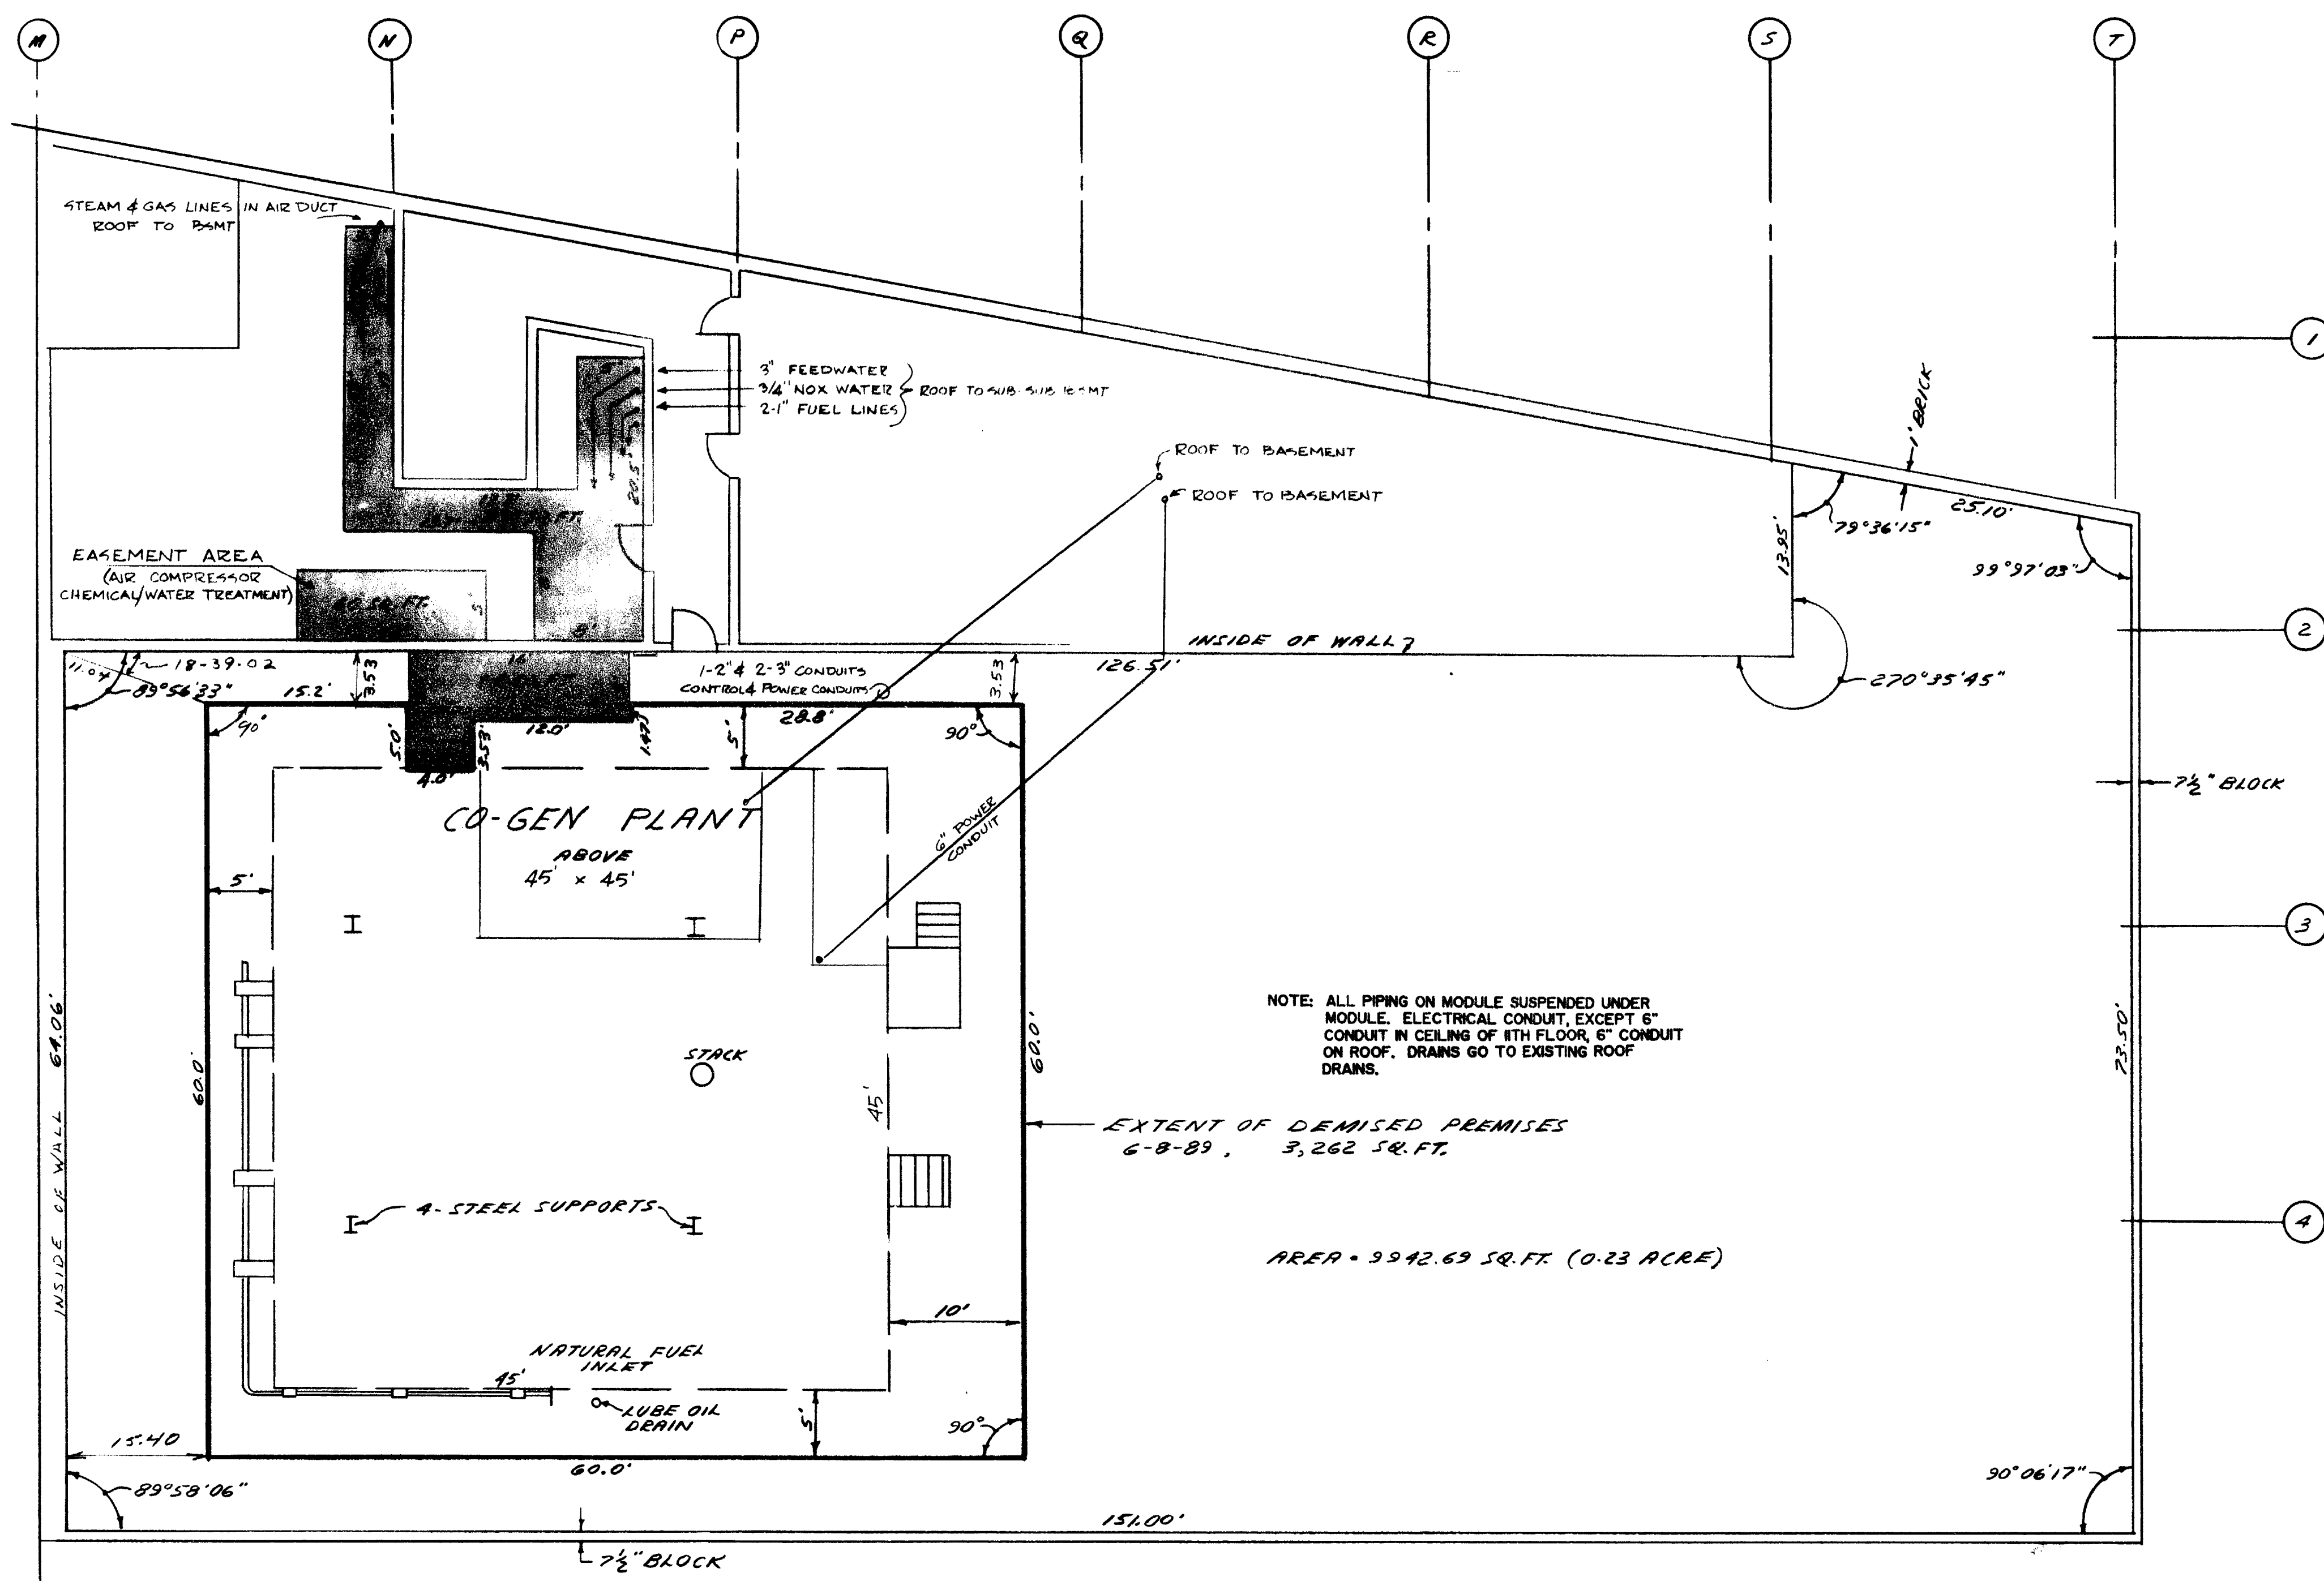

ROOF PLAN

INDEPENDENT ENERGY OPERATIONS, INC.
WESTINGHOUSE CREDIT CORP.
I HEREBY DECLARE TO QUALIFY AS A SURVEYOR
THAT THIS MAP & SURVEY WERE PREPARED IN
ACCORDANCE WITH THE STANDARDS OF A CLASS A-2
SURVEY AS DEFINED IN THE CODE OF PRACTICE FOR
STANDARDS OF ACCURACY OF SURVEYS AND MAPS,
ADOPTED DECEMBER 10, 1976 AS AMENDED BY THE
CONNECTICUT ASSOCIATION OF LAND SURVEYORS, INC.
BY: Kenneth Herbert 6/12/89
DECLARATION VALID ONLY ON MAPS
BEARING EMBOSSED SURVEYOR'S SEAL.

HALLISEY & HERBERT CIVIL ENGINEERS & LAND SURVEYORS 78 BEAVER ROAD, WETHERFIELD, CONNECTICUT	DRAWN J.D.
	CHECKED K.H.
CO GENERATION PLANT G. FOX & CO. HARTFORD, CONNECTICUT	DATE 23 DEC, 1988
	SCALE 1" = 8'
	SHEET 2 OF 2
	JOB NO. 1728
REVISIONS 5/2/89 6/12/89	

1882-62 3100A
0 INCHES 1 2 3 4

1882
10 10 10 10 10
10 10 10 10 10
10 10 10 10 10
10 10 10 10 10