


1887

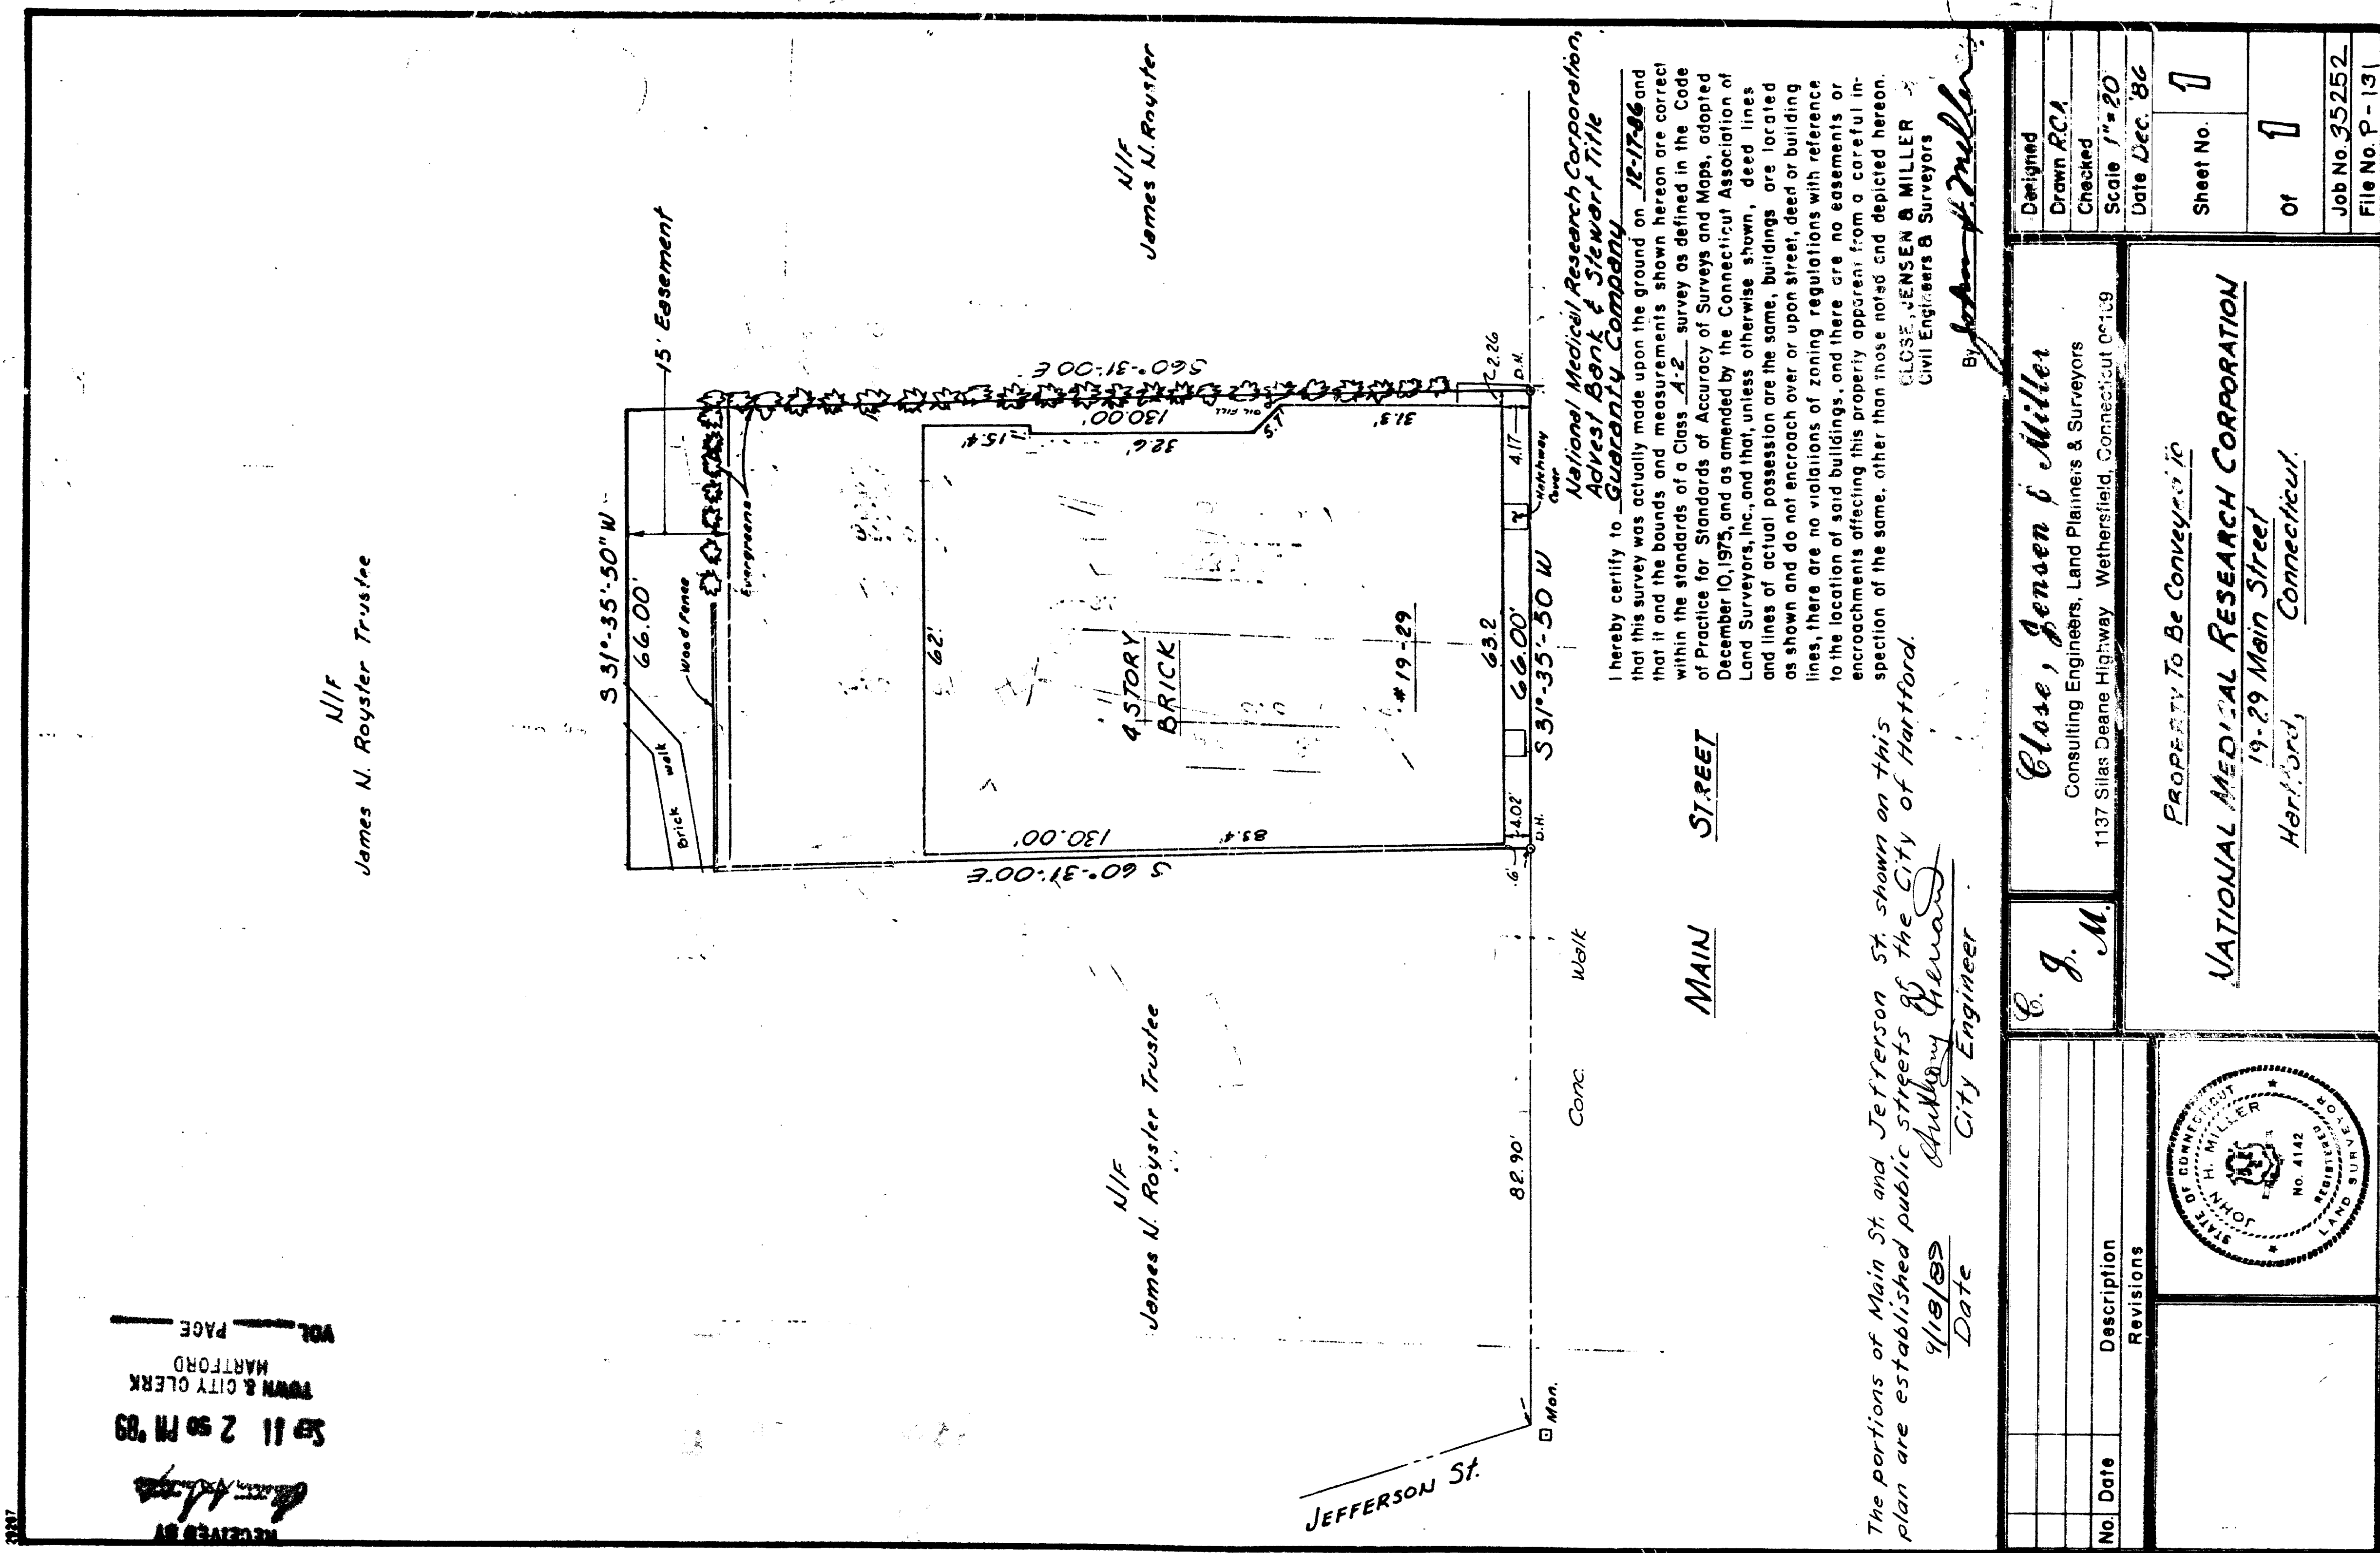

P-131

