


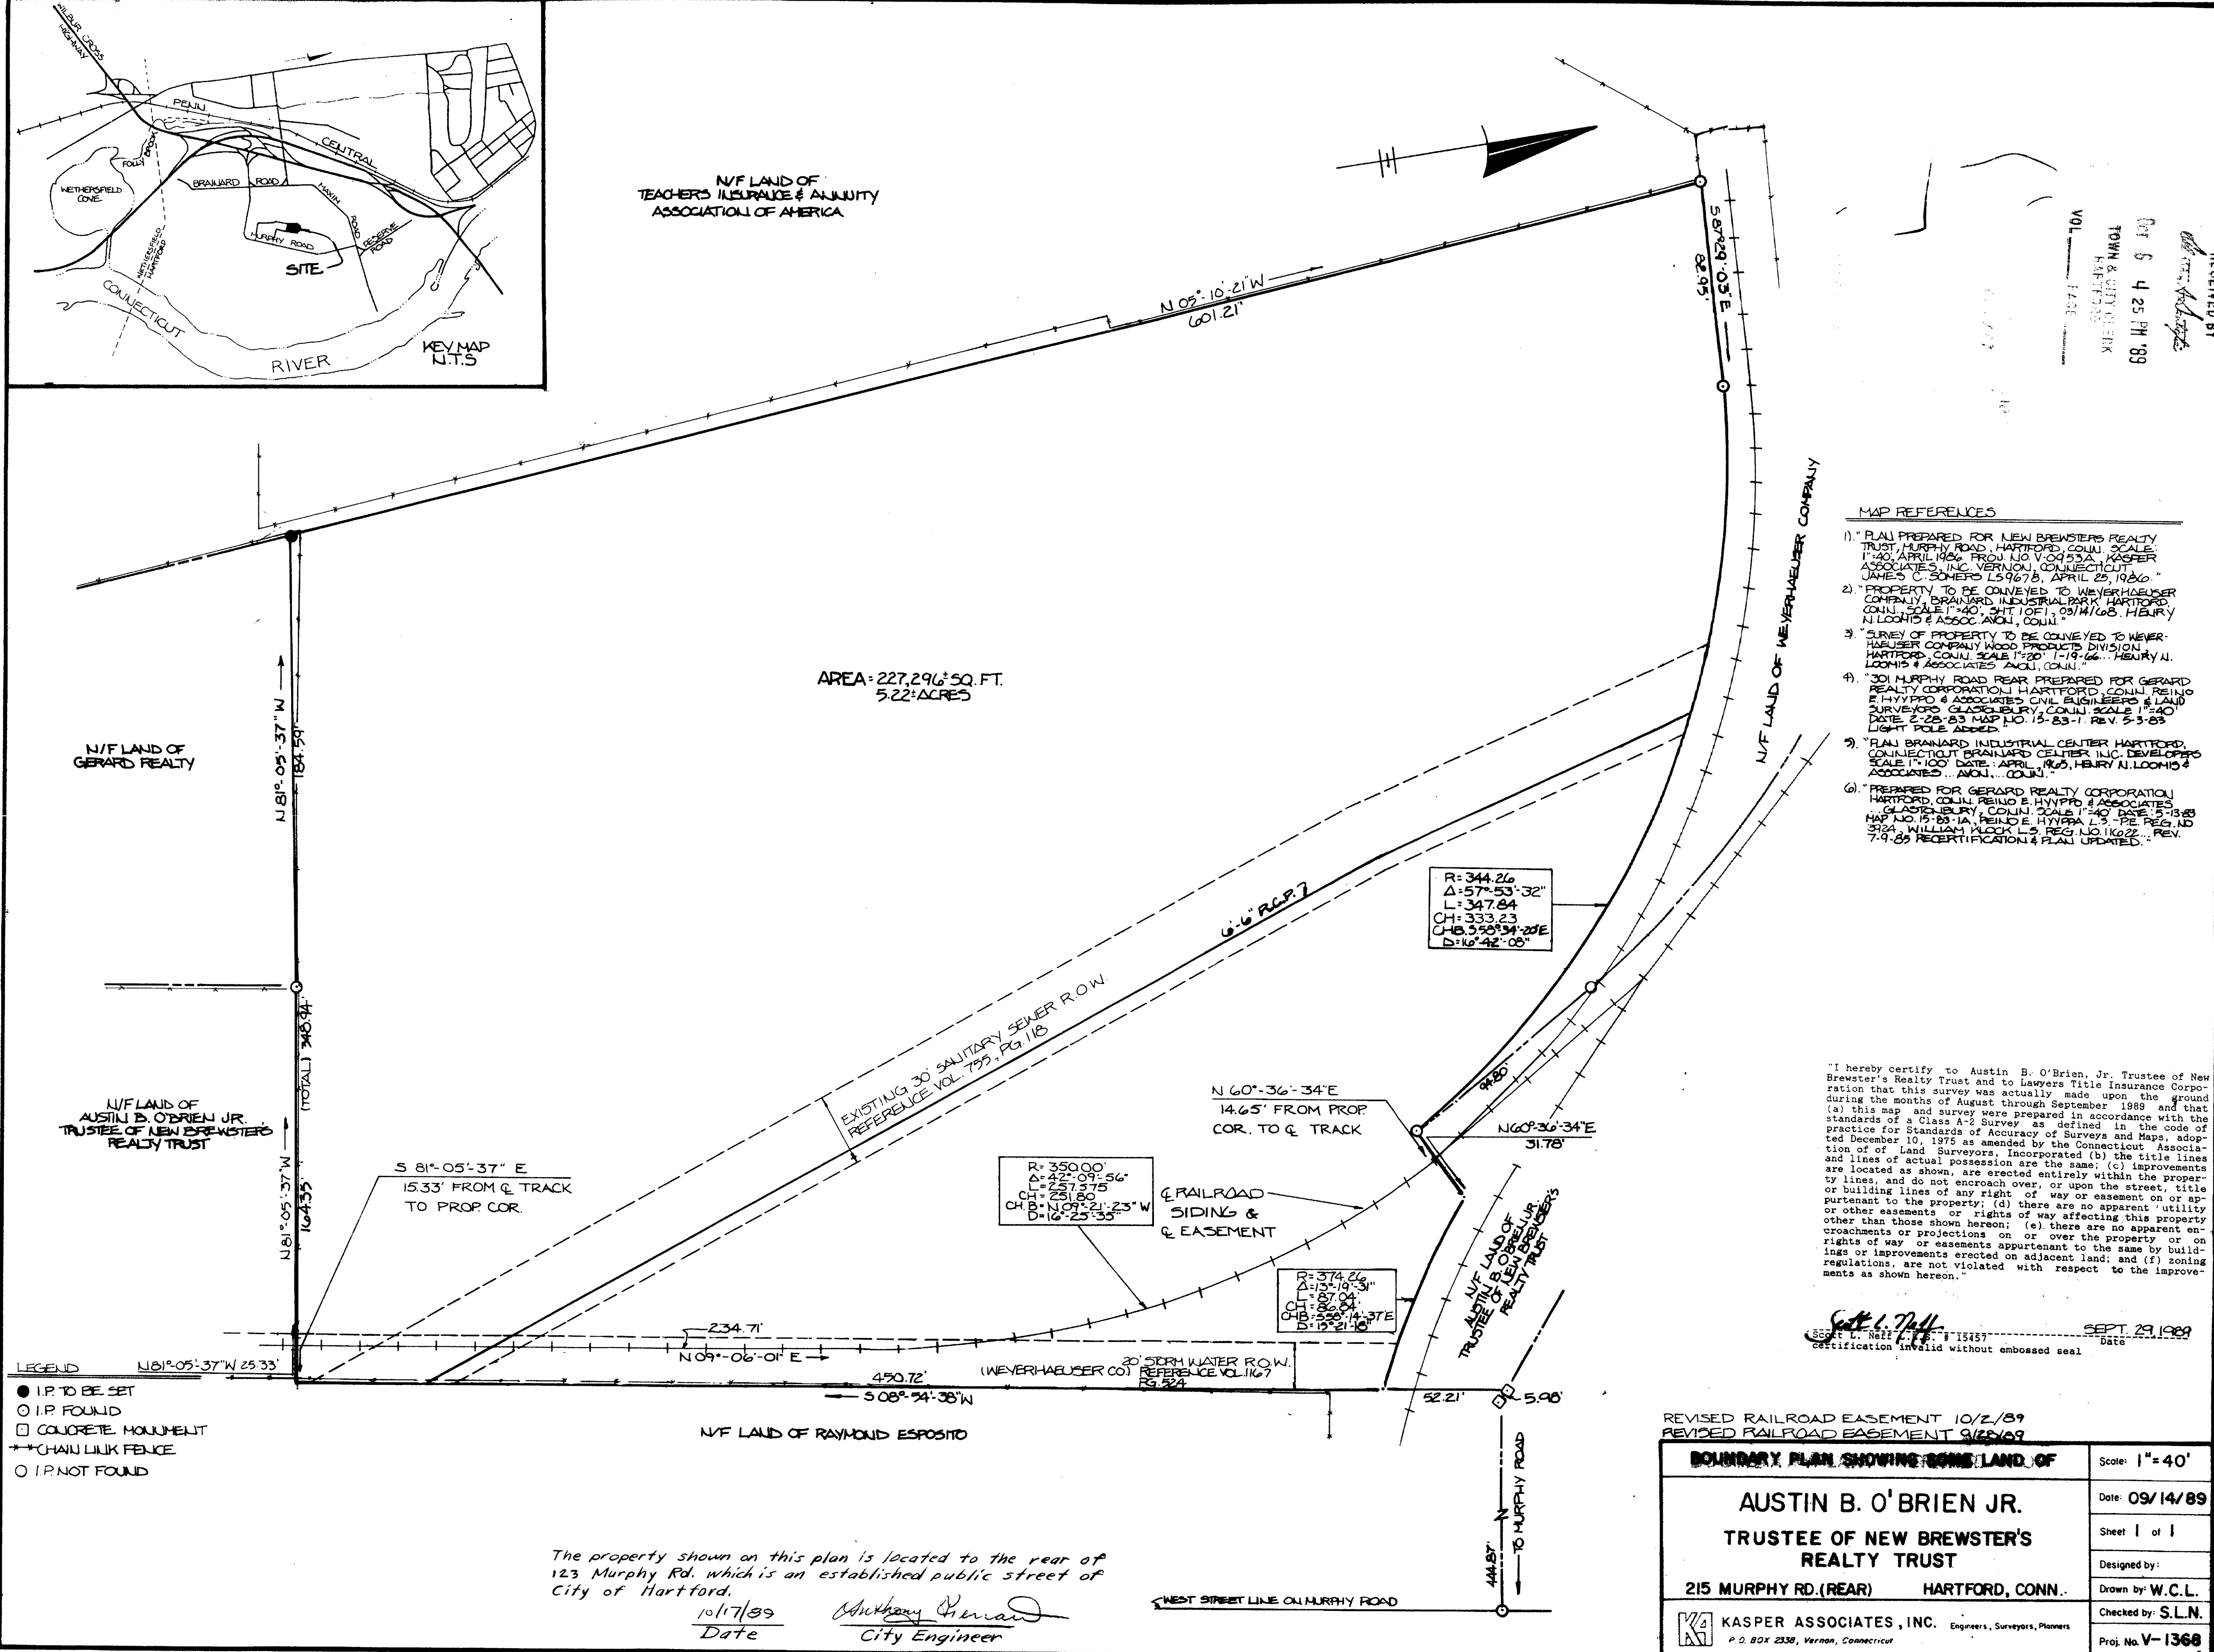

The property shown on this plan is located to the rear of 123 Murphy Rd. which is an established public street of City of Hartford.

10/17/89
Date
City Engineer

REVISED RAILROAD EASEMENT 10/2/89
REVISED RAILROAD EASEMENT 9/26/09

BOUNDARY PLAN SHOWING SOME LAND OF

AUSTIN B. O'BRIEN JR.
TRUSTEE OF NEW BREWSTER'S
REALTY TRUST

215 MURPHY RD. (REAR) HARTFORD, CONN.

KASPER ASSOCIATES, INC. Engineers, Surveyors, Planners
P.O. BOX 2338, Vernon, Connecticut

Scale: 1"=40'

Date: 09/14/89

Sheet 1 of 1

Designed by:

Drawn by: W.C.L.

Checked by: S.L.N.

Proj. No. V-1368