


PROPERTY OF
DOMINIC BENDZINSKI, WENDI LANK, & BERNARD & REGLA DIEGO
2 - 4 NEPAUG STREET
SEPT. 20, 1989 HARTFORD, CONNECTICUT
SCALE 1" = 20'

RECEIVED BY
OCT 23 10 42 AM '89
TOWN & CITY CLERK
HARTFORD
VOL PAGE

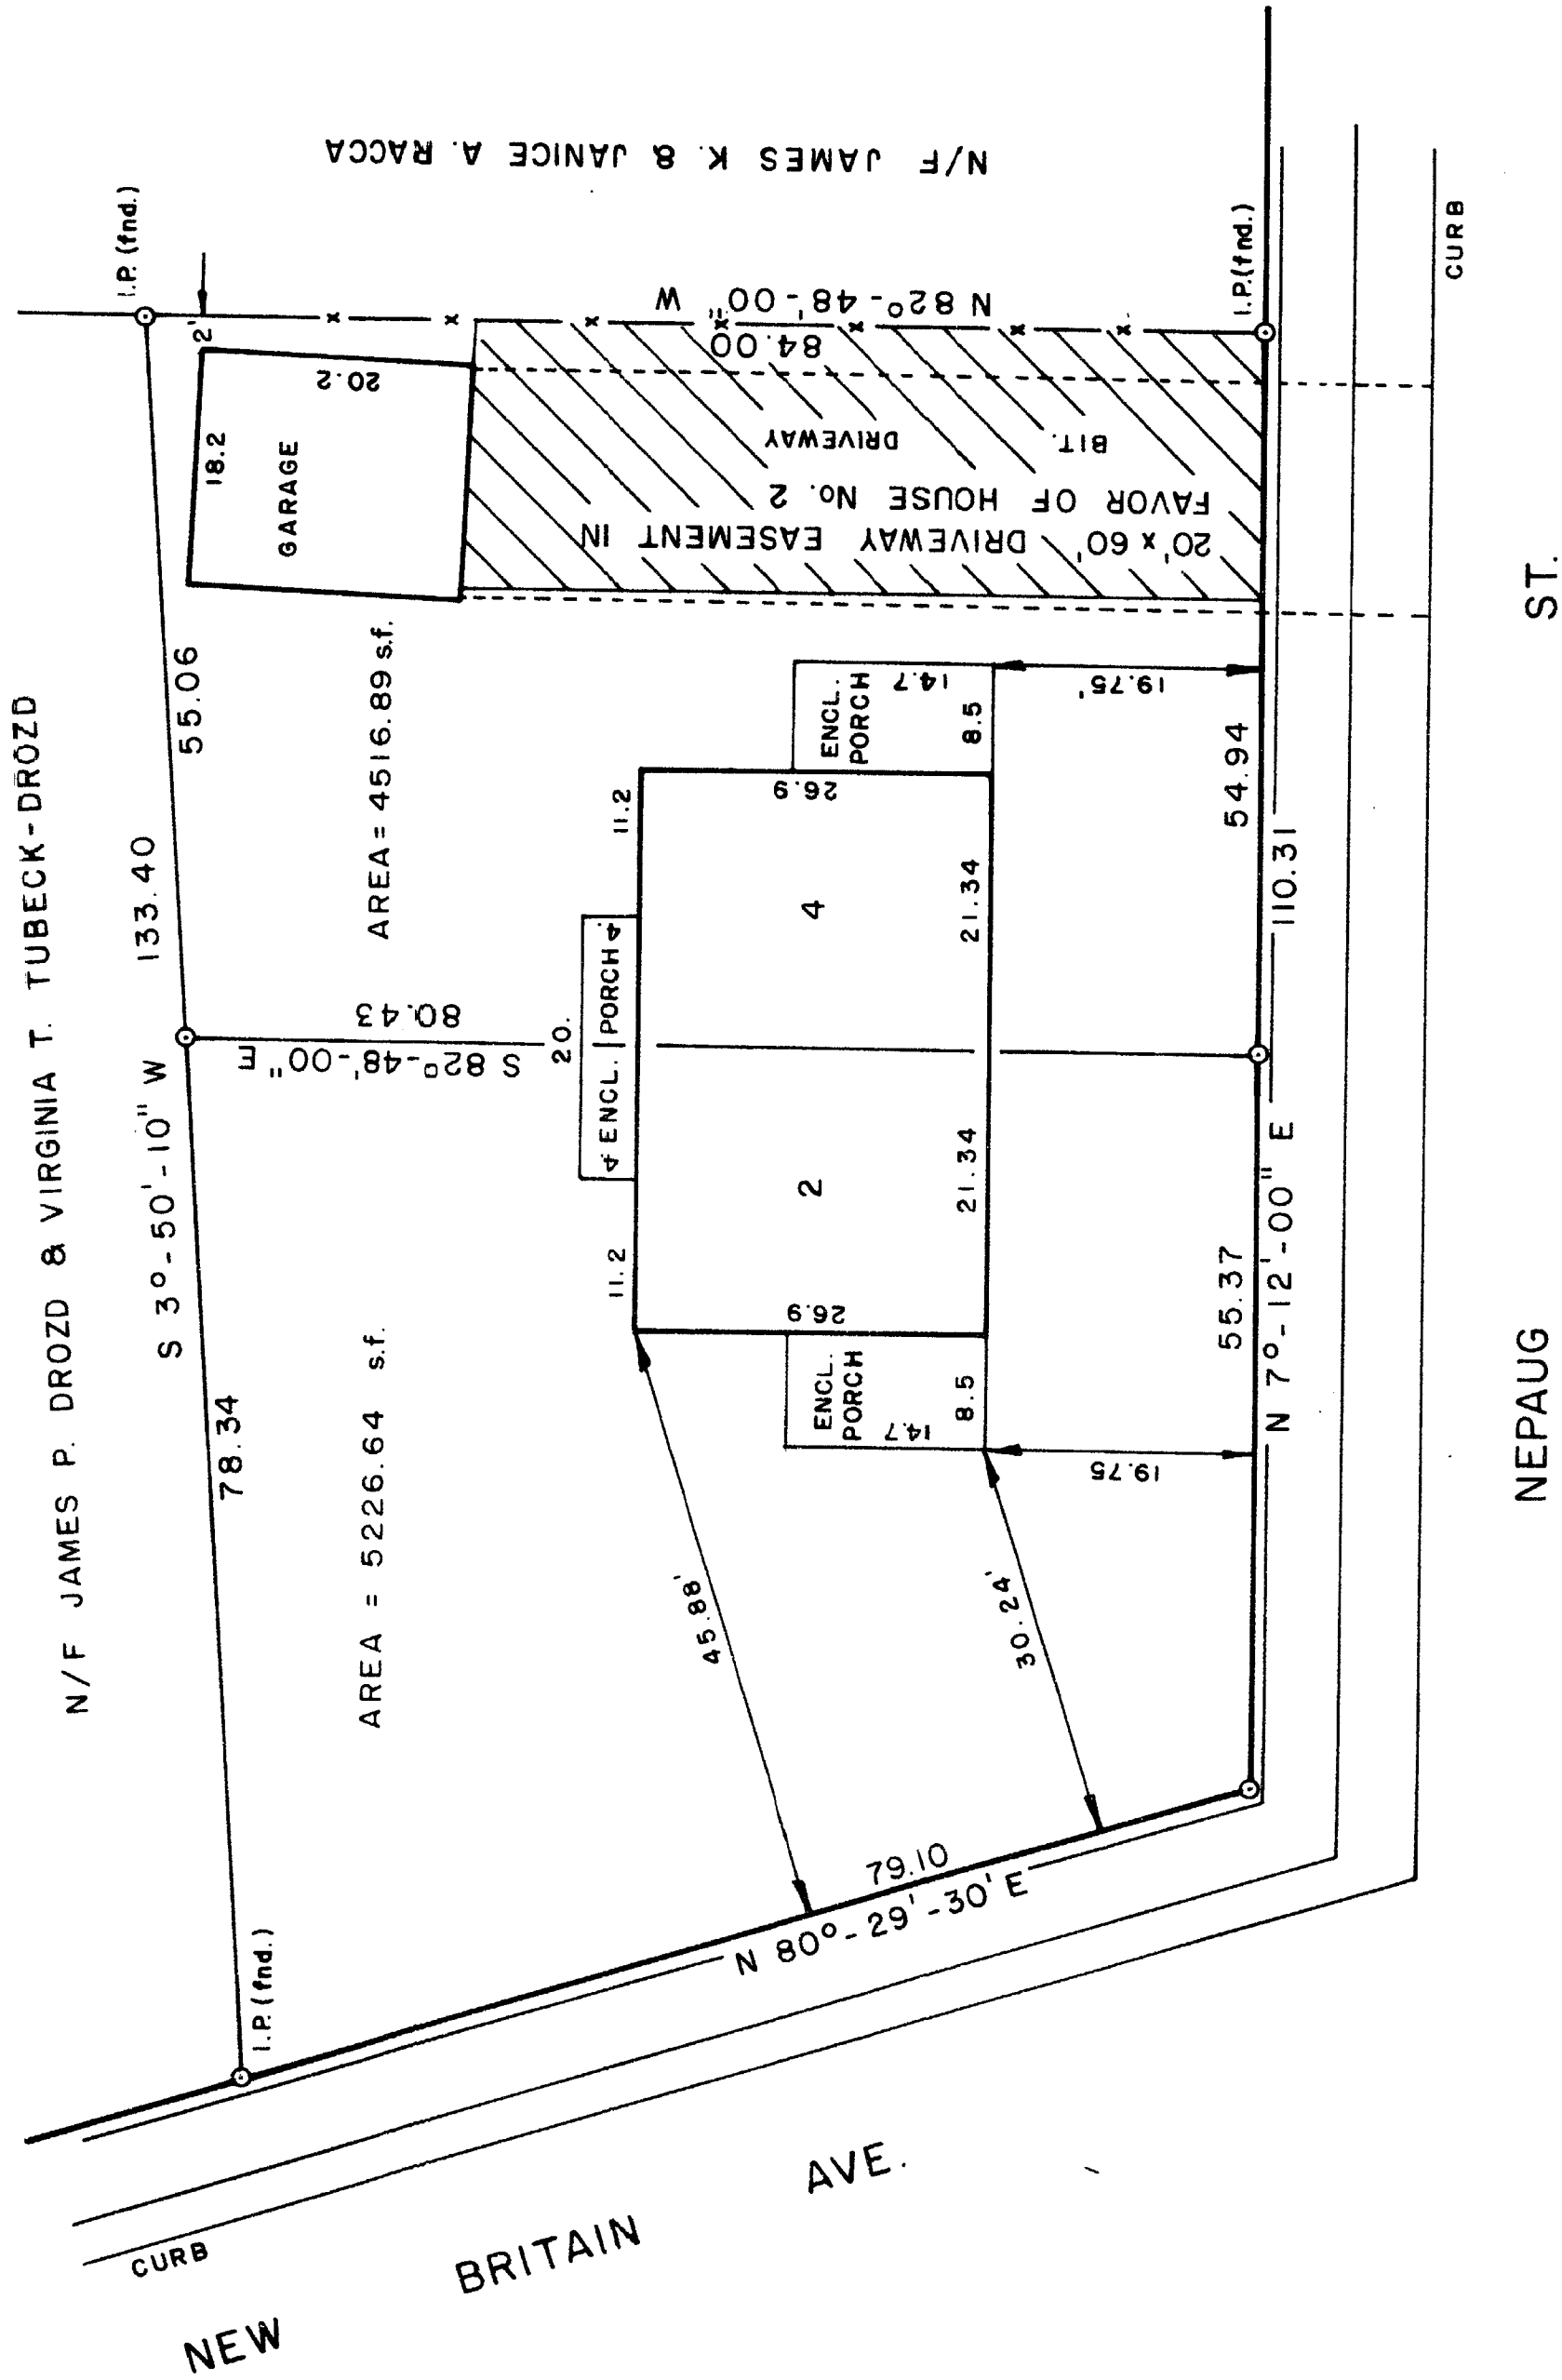

MAP REF: MAP OF ATWOODS CORNER PLOT, THE HARTFORD HOME CO.
HARTFORD, CT. SCALE 1" = 50' APRIL 1921, L. E. ZACHER,
PRES. EDGAR T. DUNCAN, C.E. (See map No. 7)

ZONE = R/5
B.L. = 19' NEPAUG ST.
S.Y. = 30' N.B. AVE.
R.Y. = 30'



I HEREBY DECLARE THIS MAP TO BE SUBSTANTIALLY
CORRECT AND SURVEY WAS PREPARED IN ACCORDANCE
WITH THE ACTS OF THE CONN. ASSOCIATION OF
LAND SURVEYORS, INC.

Russell J. Carlo
RUSSELL J. CARLO, REG. L.S. No. 8156

The portions of New Britain Ave and
Nepaug St shown on this plan are
established public streets of the
City of Hartford.
10/26/89
Date City Engineer



1893 73