
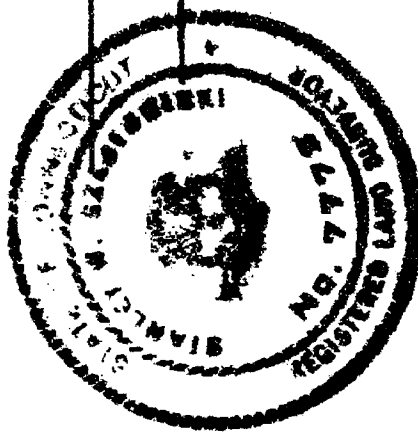


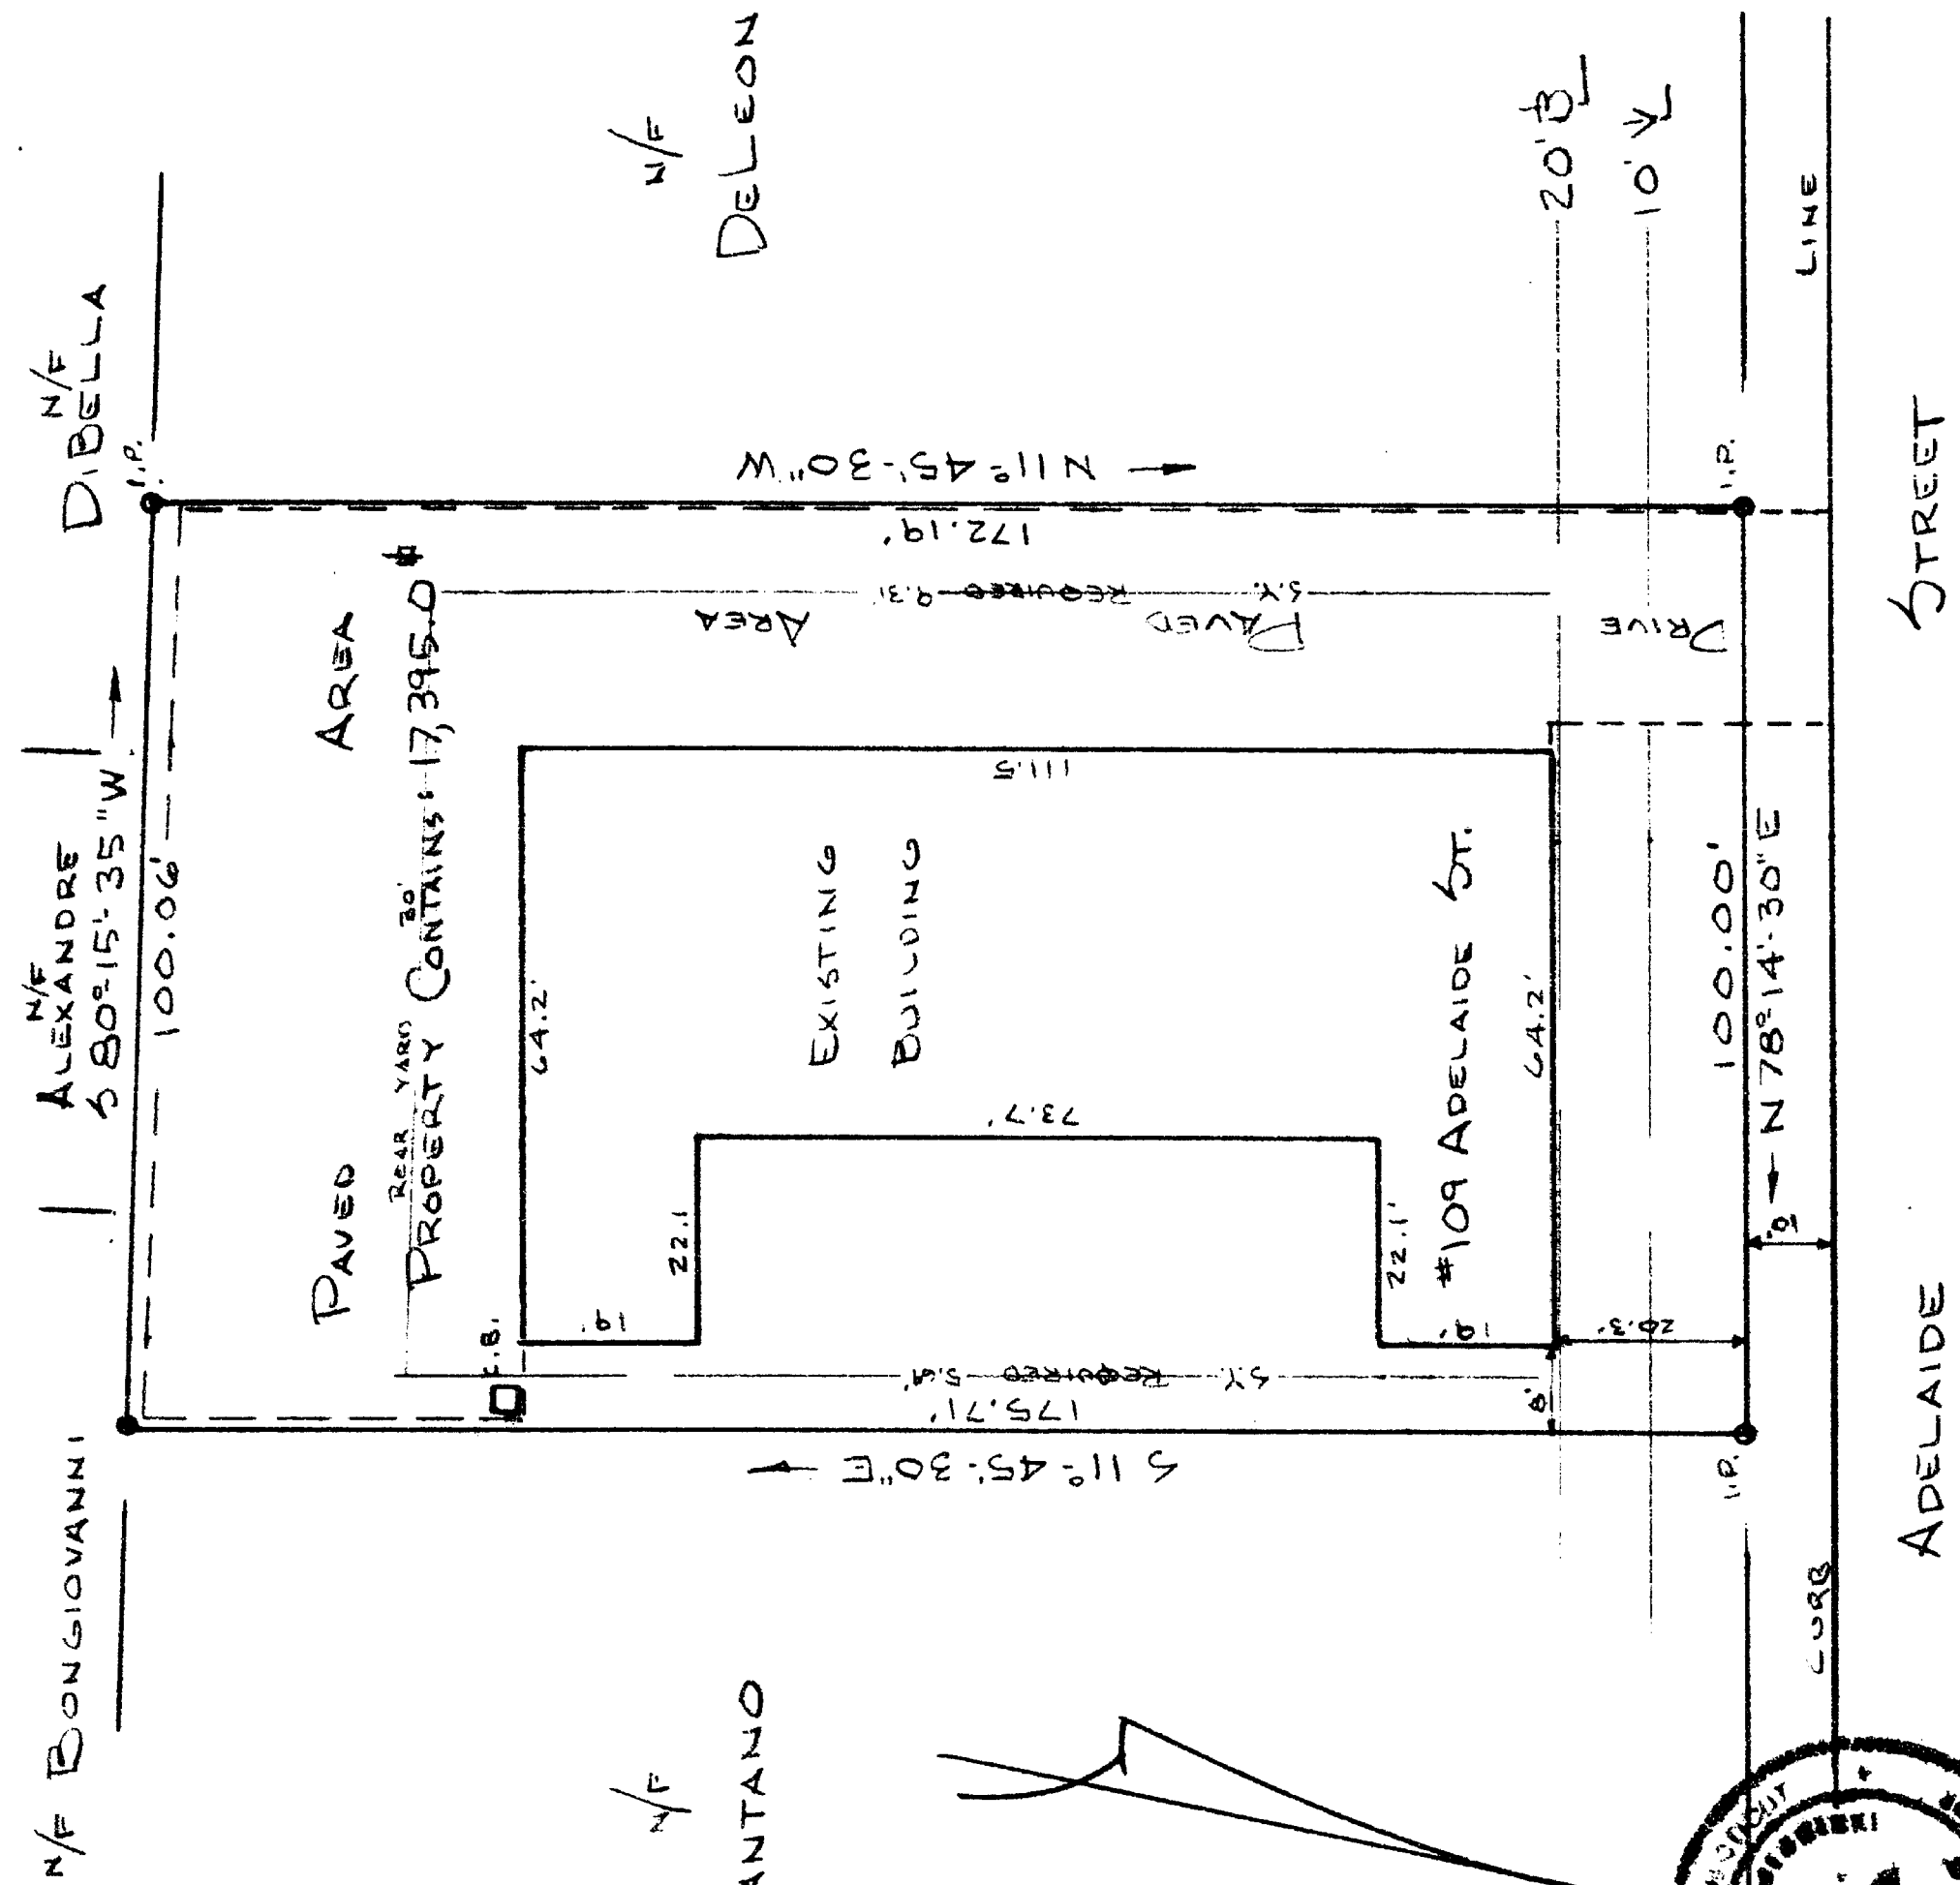


HARTFORD, CONNECTICUT AUGUST 14, 1989 SCALE: 1"=30'
I hereby certify to: Southern Federal Savings & Loan Association of Georgia,
Chicago, Title Insurance Company,
Jon A. Bergren,

that this survey was actually made upon the ground and that it and the bounds and measurements shown hereon are correct with the standards of a Class A-2 of the Surveyor's Association of Connecticut and that title lines and lines of actual possession are the same, buildings are located as shown and do not encroach over or upon street, title or building lines, there are no violations of zoning regulations with reference to the location of said building affecting this property apparent from a careful inspection of the same and that no adjoining structure encroaches on the premises or any dominant appurtenant easement, and said premises are not located within a 100-year flood plain or in an identified "flood-prone area", as defined by the U.S. Department of Housing and Urban Development, pursuant to the Flood Disaster Protection Act of 1973, as amended.

Stanley W. Gzeszowski R.L.S.7772
Stanley W. Gzeszowski
623 Talcottville Road Vernon, Connecticut 4558

The portion of Adelaide St. shown on this plan
is an established public street of the City of Hartford,
10/26/89
Date
City Engineer

RECEIVED BY
OCT 24 10 11 AM '89
TOWN & CITY CLERK
HARTFORD
VOL. _____ PAGE _____

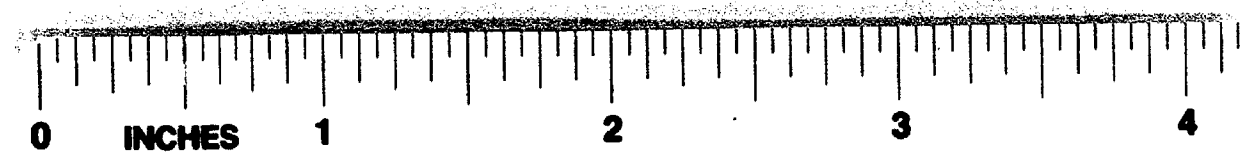

1894

74