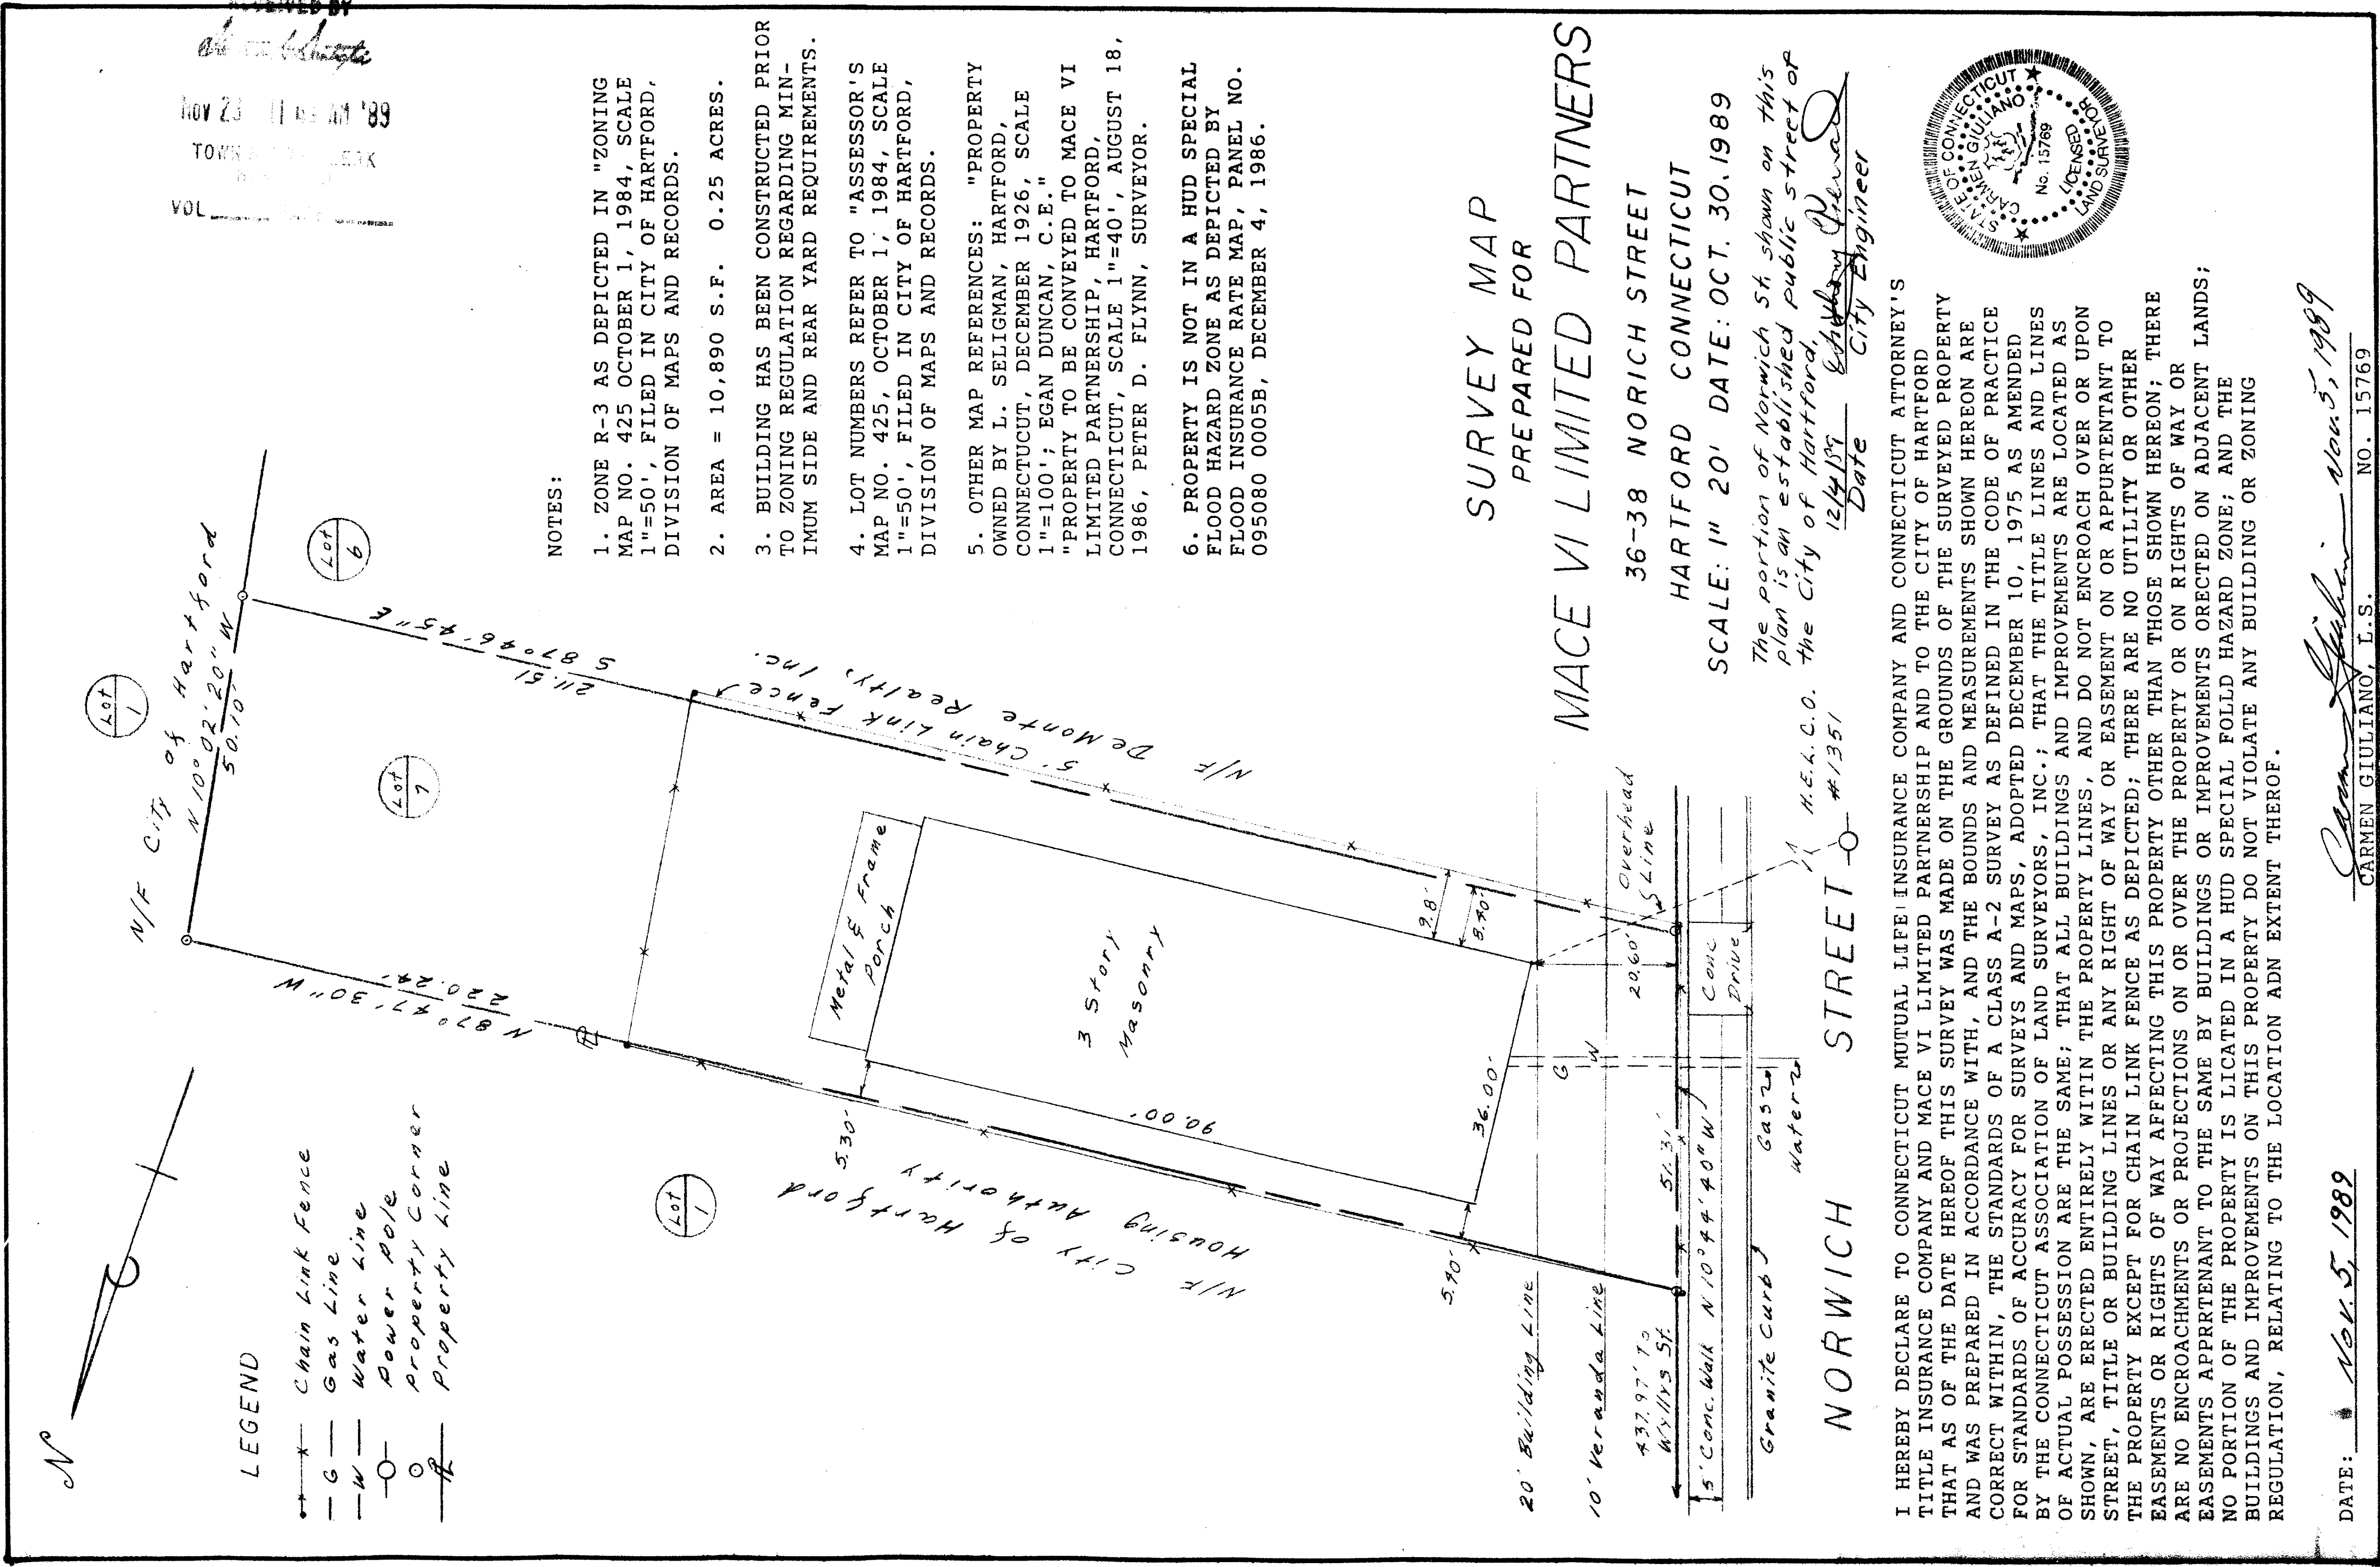


EASI FILE CORP. IRVINE CA EPM 34

1900

1900

1900