


RECEIVED BY
DATE
FILE NO.

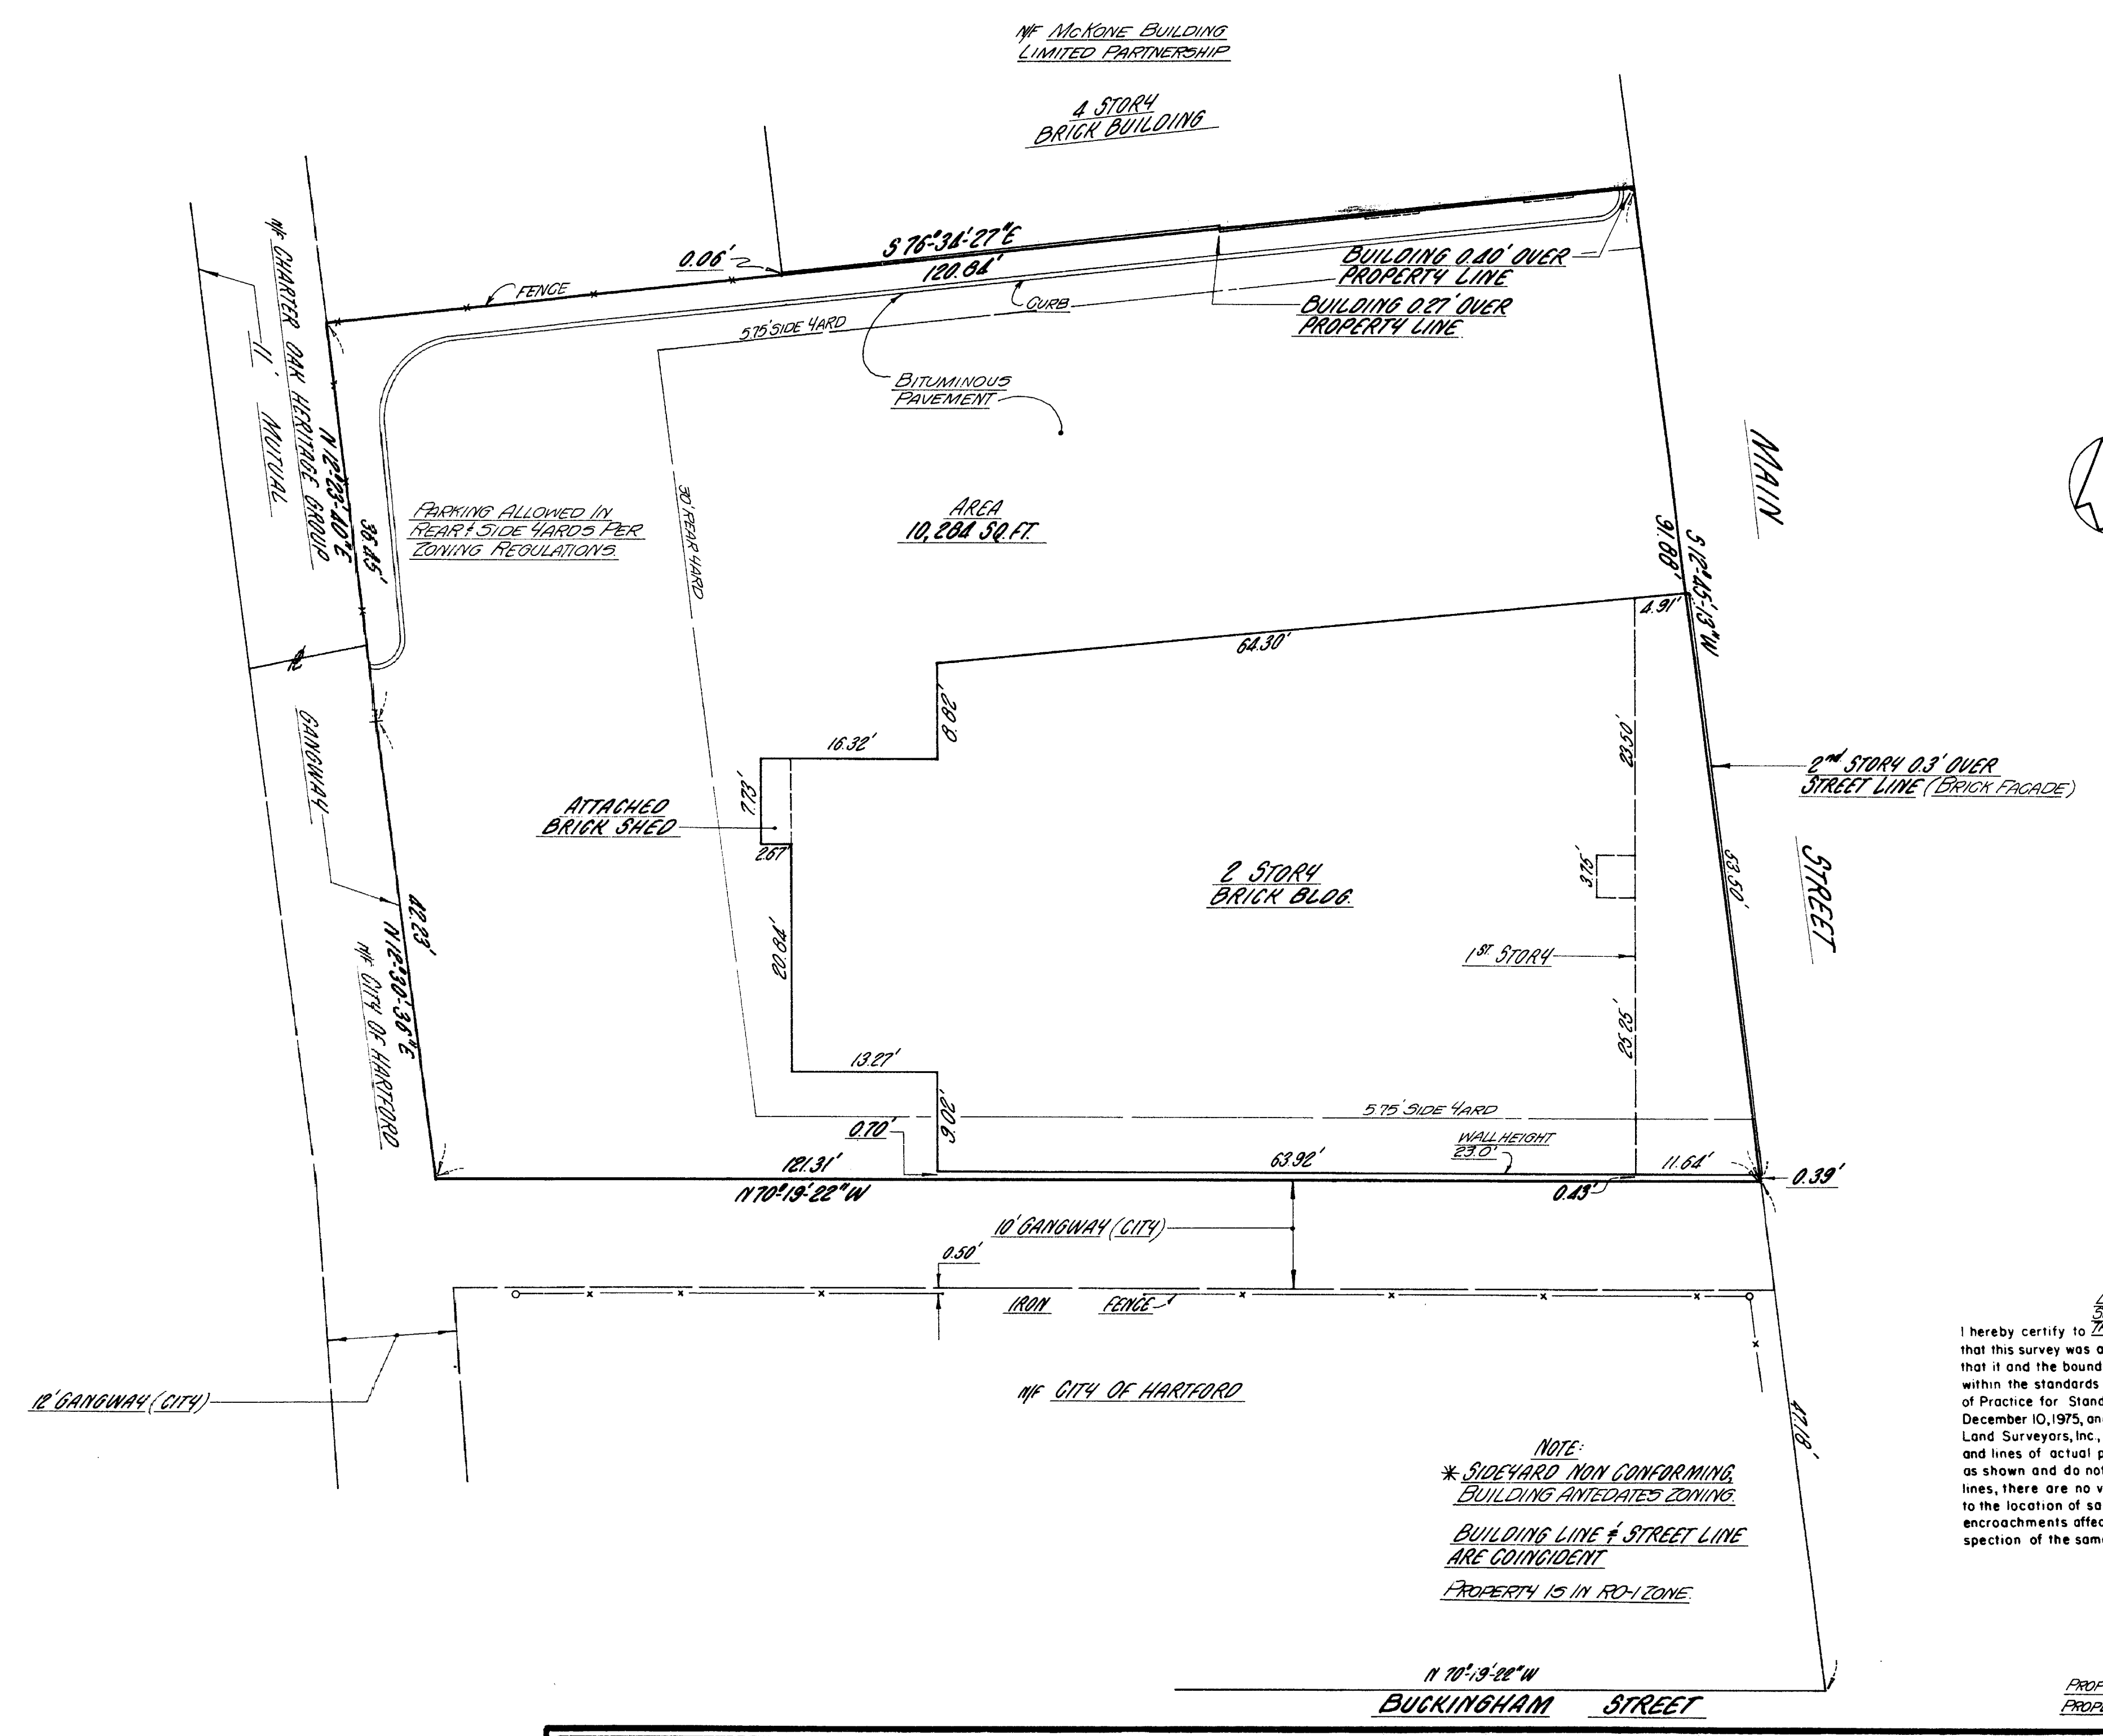

LAWYERS TITLE INSURANCE CORPORATION
SOCIETY OF SURVEYORS
THE HARTFORD DISPENSARY

I hereby certify to
that this survey was actually made upon the ground on 9-20-89 and
that it and the bounds and measurements shown hereon are correct
within the standards of a Class A.S.E. survey as defined in the Code
of Practice for Standards of Accuracy of Surveys and Maps, adopted
December 10, 1975, and as amended by the Connecticut Association of
Land Surveyors, Inc. and that, unless otherwise shown, deed lines
and lines of actual possession are the same, buildings are located
as shown and do not encroach over or upon street, deed or building
lines, there are no violations of zoning regulations with reference
to the location of said buildings and there are no easements or
encroachments affecting this property apparent from a careful in-
spection of the same, other than those noted and depicted hereon.

CLOSE, JENSEN & MILLER
Civil Engineers & Surveyors
By *Robert J. Miller*


PROPERTY IS IN FLOOD ZONE C PER HUD Q.T.R.M. No. 095080-0005 A
PROPERTY IS NOT IN INLAND WETLANDS.

The portion of Main St. shown on this plan is an established
public street of the City of Hartford.

11/27/89 *Whitney Coleman*
Date City Engineer

Designed	 Close, Jensen & Miller Consulting Engineers, Land Planners & Surveyors 1151 Silas Deane Highway Wethersfield, Connecticut 06109	
Drawn		R.B.B.
Checked		J.H.M.
Date		Oct. 12, 1989
Scale		1"=10'

PROPERTY OF
**THE HARTFORD
DISPENSARY**
341-347, 347 1/2-355 MAIN STREET
HARTFORD, CONNECTICUT

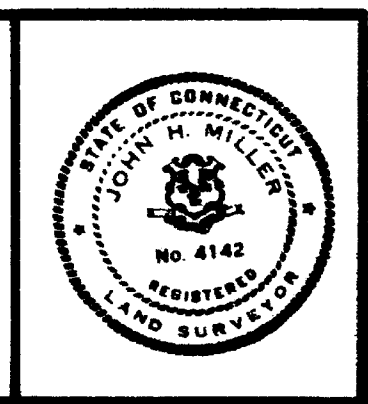

No.	Date	Description

Sheet No.	1
Of	1
File No.	M.17.3.3

