1912

NOTE: THIS SURVEY CONSISTS OF EIGHT SHEETS. SUBSEQUENT SHEETS MAY BE ADDED.

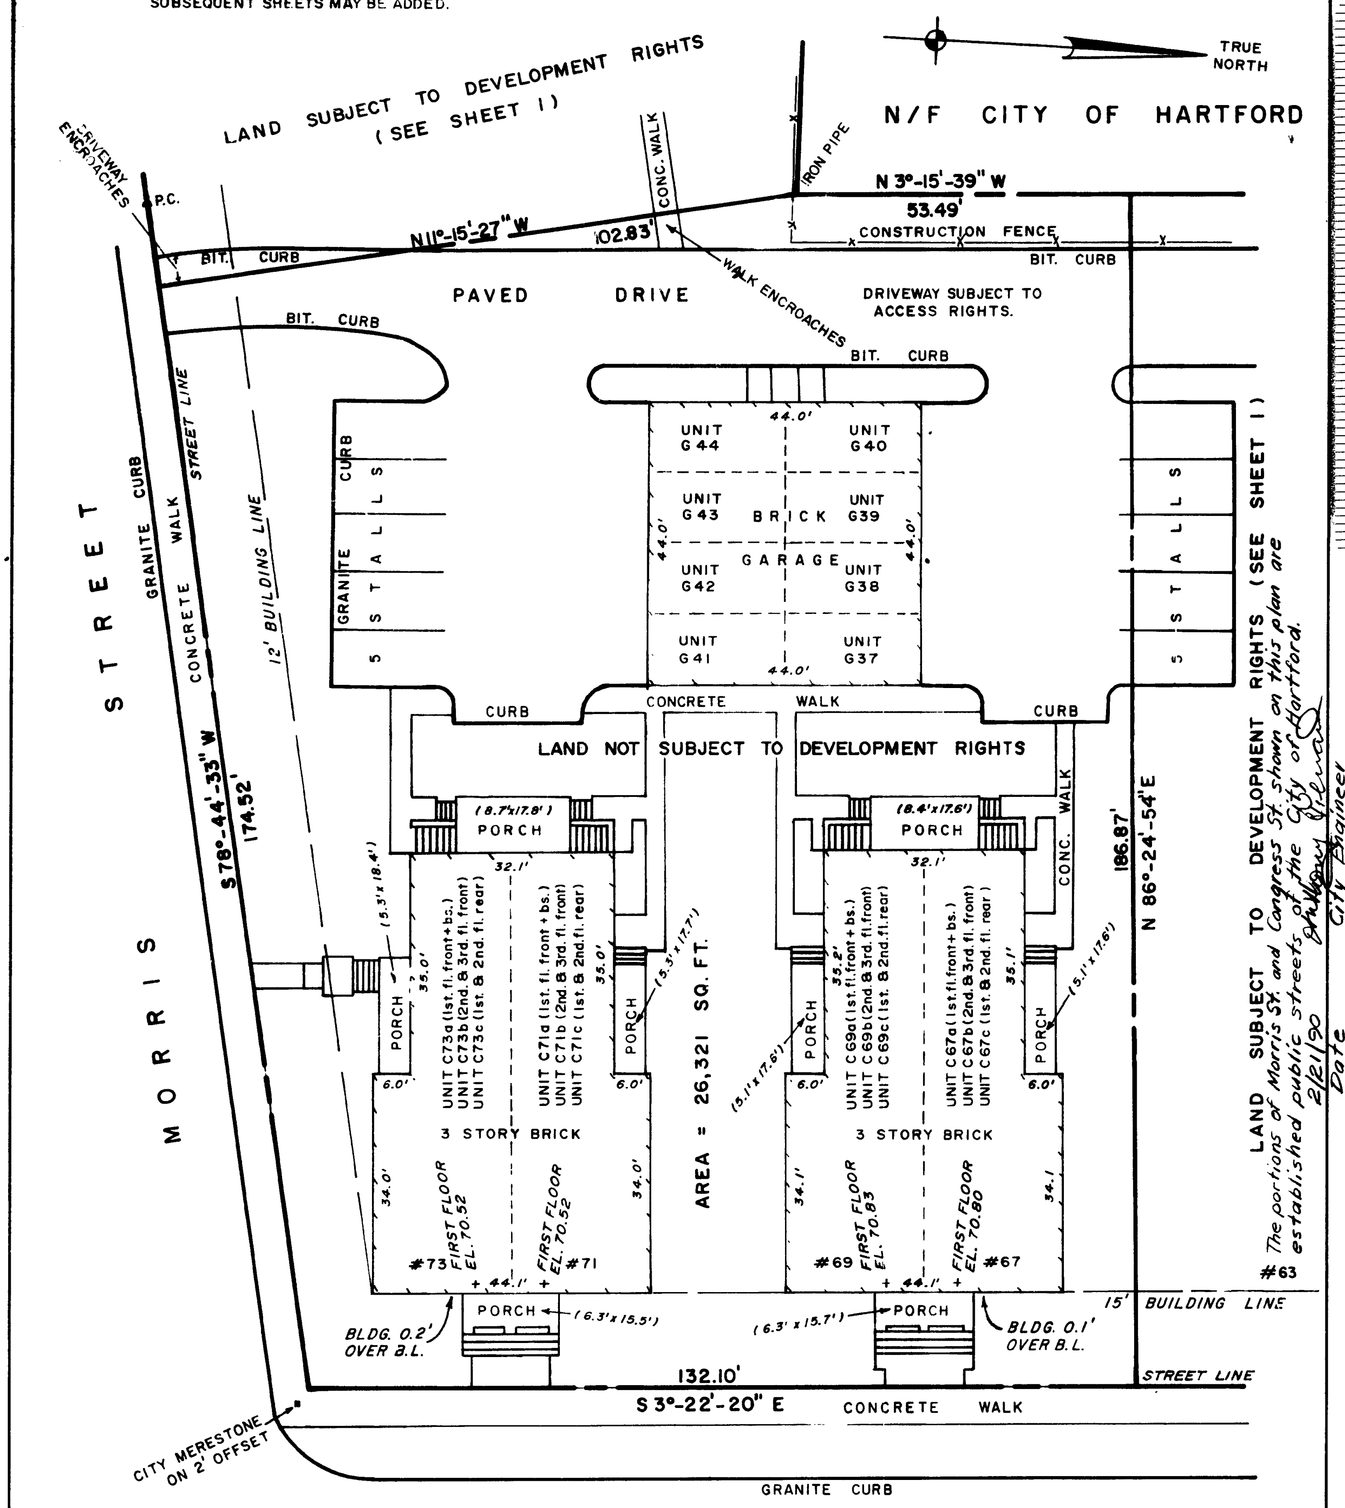

NOTES:
(1) REFERENCE FOR AZIMUTH IS METROPOLITAN DISTRICT COMMISSION COORDINATE SYSTEM.
(2) REFERENCE IS MADE TO OUR 40 SCALE BLOCK MAPS (2 SHEETS) SHOWING THE ENTIRE CONGRESS STREET COMMUNITY AREA.
(3) IRON PINS OR OTHER APPROPRIATE MARKERS TO BE SET AT CORNERS.
(4) THIS PROPERTY IS SUBJECT TO THE UTILITY PROVISIONS SET FORTH IN V. 1562, P. 158 (& FOL.), CITY LAND RECORDS.

I HEREBY DECLARE THAT THIS MAP IS SUBSTANTIALLY CORRECT. THIS MAP AND SURVEY WERE PREPARED IN ACCORDANCE WITH THE STANDARDS OF A CLASS A-2 SURVEY AS DEFINED IN THE "RECOMMENDED STANDARDS FOR SURVEYS AND MAPS IN THE STATE OF CONNECTICUT" AS PREPARED AND ADOPTED BY THE CONNECTICUT ASSOCIATION OF LAND SURVEYORS, INC., ON SEPTEMBER 13, 1984. THIS MAP AND SURVEY CONSISTING OF THE NUMBER OF SHEETS NOTED SHOWS ALL INFORMATION REQUIRED OF SURVEYS UNDER SEC. 47-228 OF THE CONNECTICUT GENERAL STATUTES.

AUG. 28, 1989 E. S. Smith

STATE OF CONNECTICUT — E. S. SMITH — No. 13644 — LICENSED LAND SURVEYOR

CONGRESS STREET CONDOMINIUM

DEVELOPER: CONGRESS STREET CONDOMINIUMS, LTD.

HARTFORD, CONNECTICUT

SHEET 8 PHASE V UNITS 67-69 & 71-73 CONGRESS STREET

SCALE: 1 INCH = 20 FEET (0' 5' 10' 15' 20')

AUGUST, 1989

MAP PREPARED BY:
PETERSEN & HOFFMAN —— LAND SURVEYORS
1000 FARMINGTON AVE., WEST HARTFORD, CT. 06107

MAP UPDATES:

EASI FILE CORP. IRVINE CA 1912

1912