



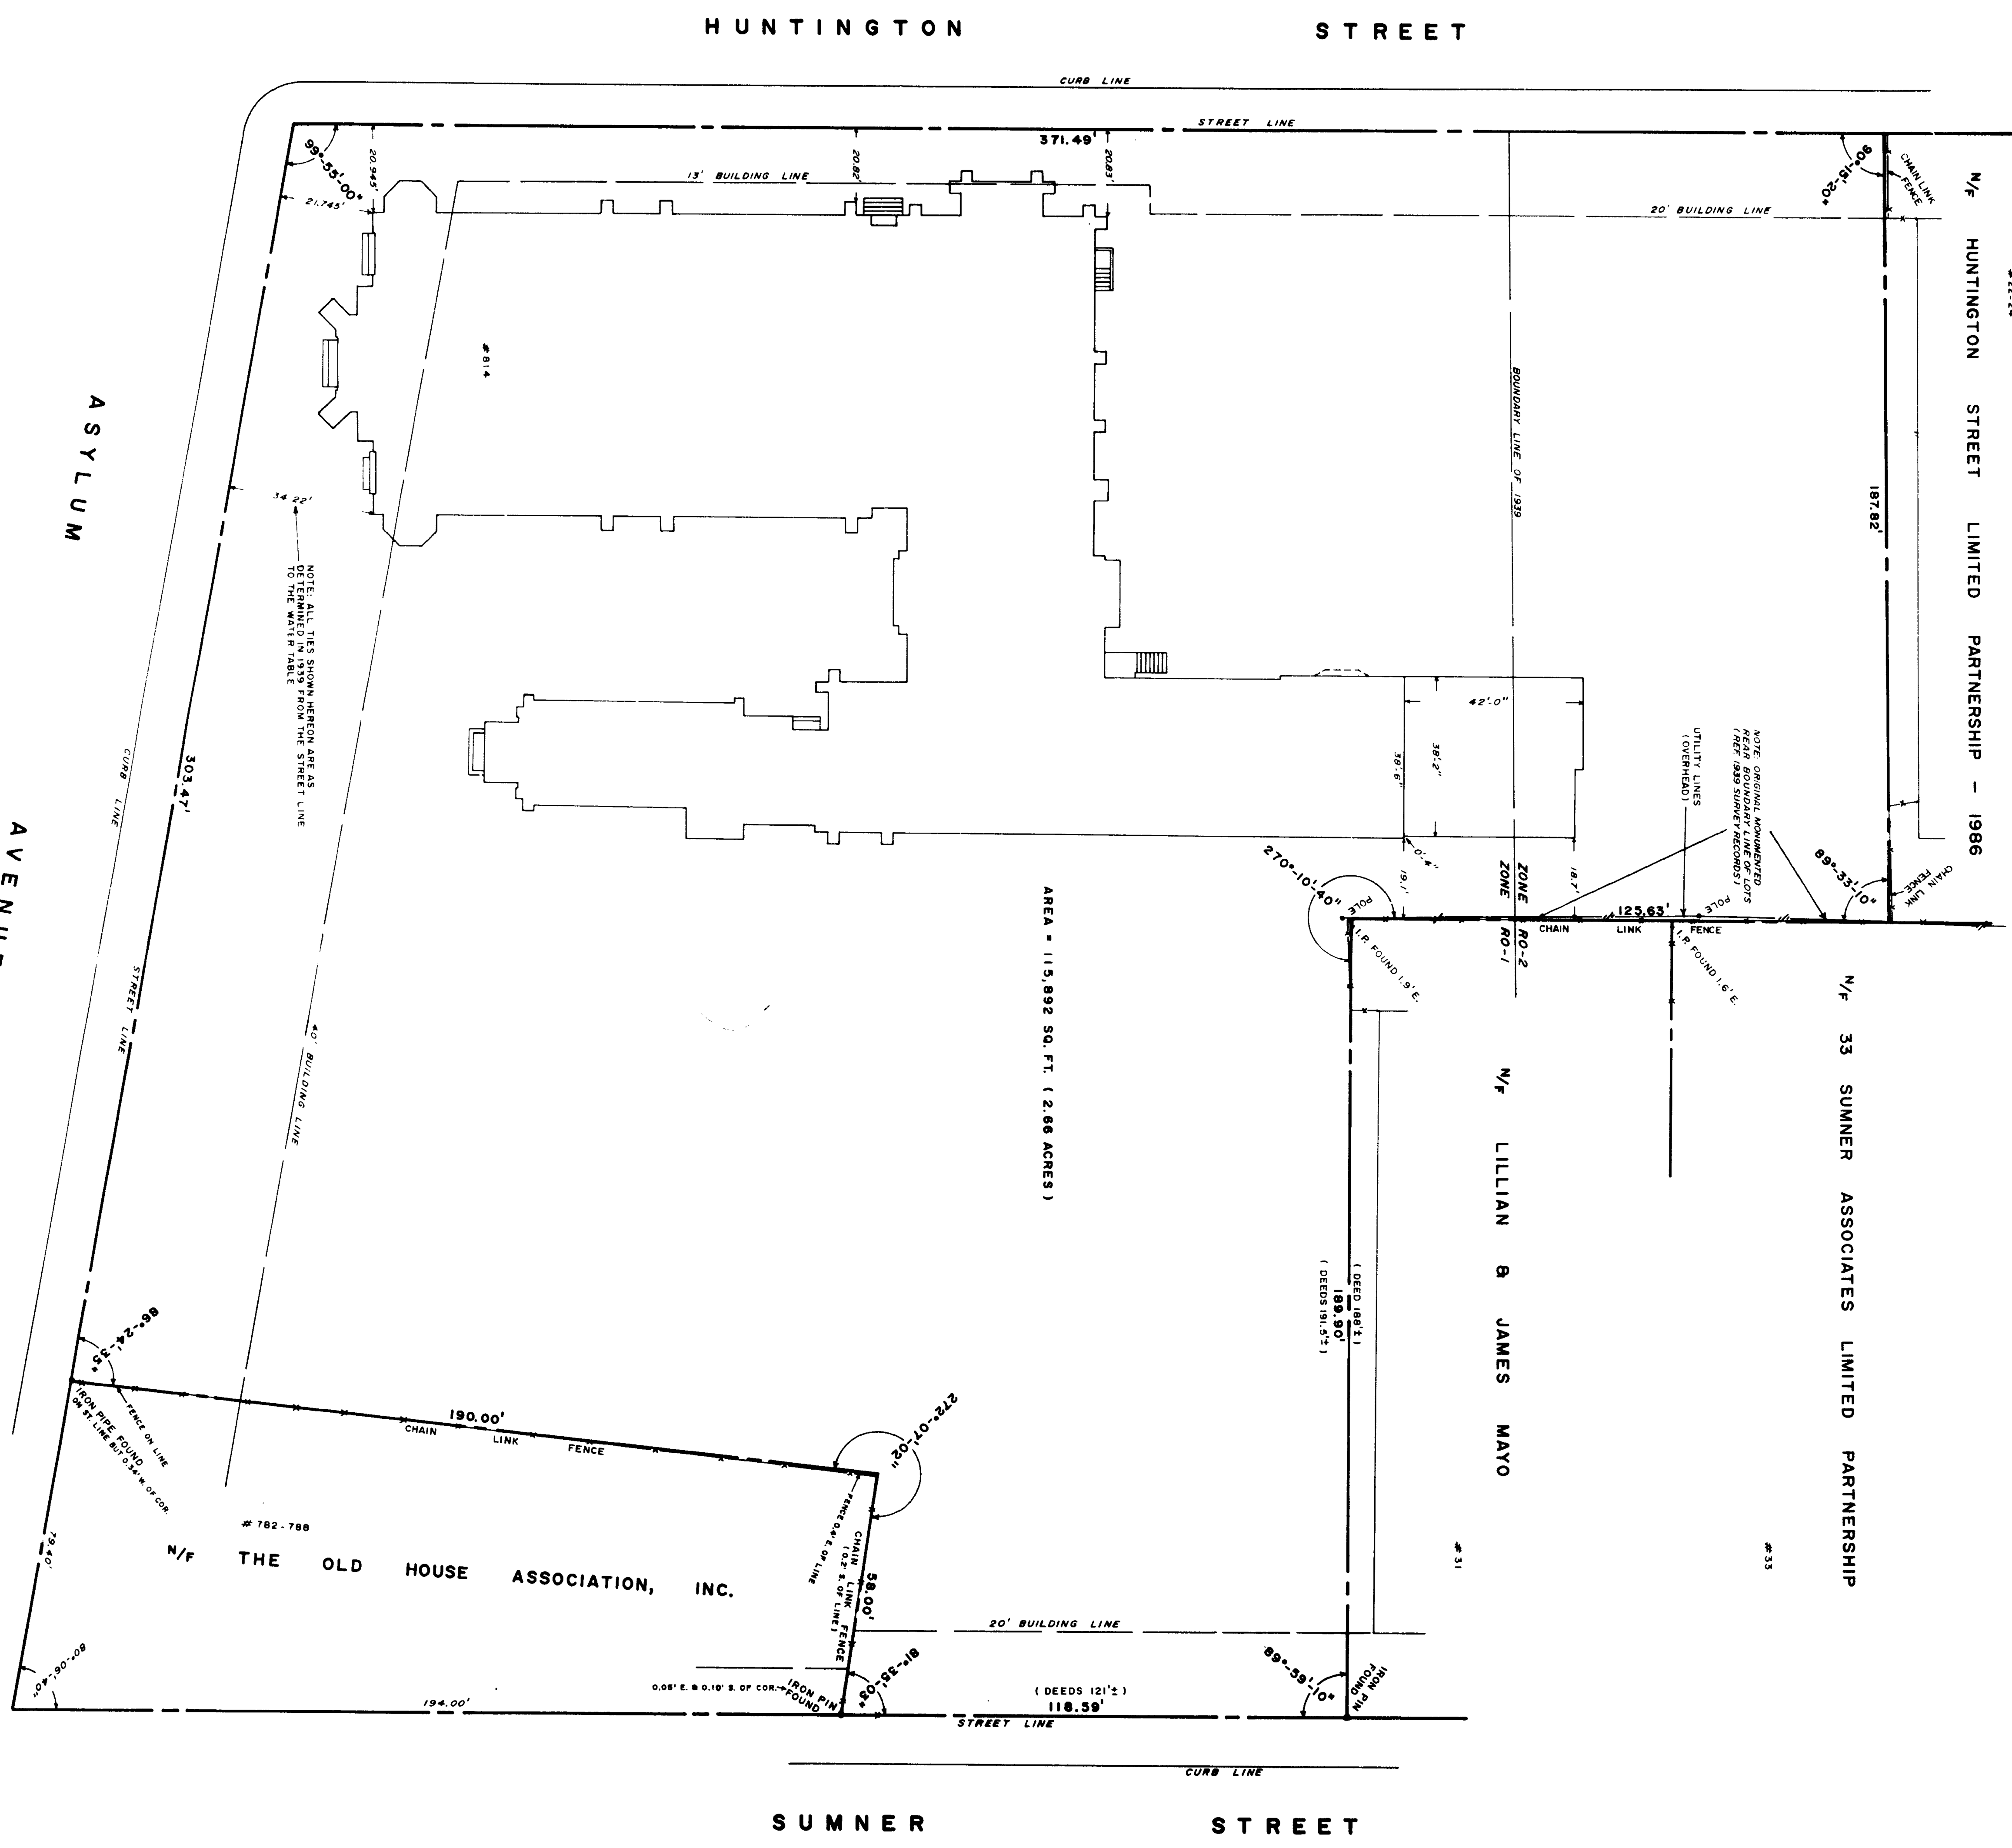

- NOTES
- (1) THE EXISTING BUILDING IS NONCONFORMING TO THE BUILDING LINE.
 - (2) REFERENCE IS MADE TO OUR MAY 1989 SURVEY OF A PORTION OF THESE PREMISES.
 - (3) REFERENCE IS MADE TO A MAP OF THE PREMISES AT 782-788 ASYLUM AVENUE PREPARED IN MARCH 1980 BY JOSE, JENSEN AND MILLER.
 - (4) THE PROPOSED ADDITION SHOWN HEREIN IS IN CONFORMANCE WITH ZONING REQUIREMENTS FOR SIDE AND REAR YARDS AND MINIMUM LOT COVERAGES.

I HEREBY DECLARE THAT THIS MAP IS SUBSTANTIALLY CORRECT
THIS MAP AND SURVEY WERE PREPARED IN ACCORDANCE WITH
THE STANDARDS AND PRACTICES OF A PROFESSIONAL LAND SURVEYOR
AND I AM A MEMBER OF THE CONNECTICUT LAND SURVEYORS
ASSOCIATION OF LAND SURVEYORS, INC. ON SEPTEMBER 13, 1989.
MARCH 12, 1990 *E. S. Smith, L.S.*

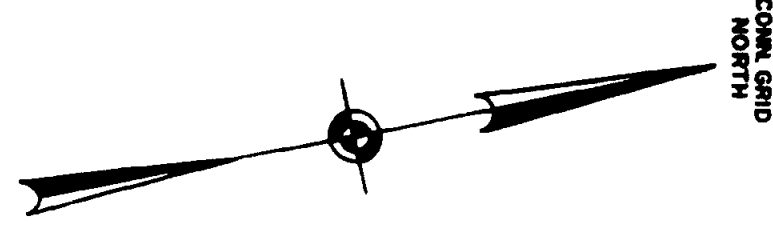

PROPERTY OF
ASYLUM HILL CONGREGATIONAL CHURCH
814 ASYLUM AVENUE
HARTFORD, CONNECTICUT
SCALE: 1 INCH = 20 FEET
MARCH, 1990
MAP PREPARED BY
PETERSEN & HOFFMAN — LAND SURVEYORS
1000 FARMINGTON AVENUE, WEST HARTFORD, CONN. 06107

The portion of Sumner St. Asylum Ave. and Huntington St.
shown on this plan are existing public streets of the
City of Hartford.
Date *3/11/90* *L.L. Jensen* *City Engineer*

FILED
TO BUREAU AND FILED 1990

1916

96