


1919

40-16

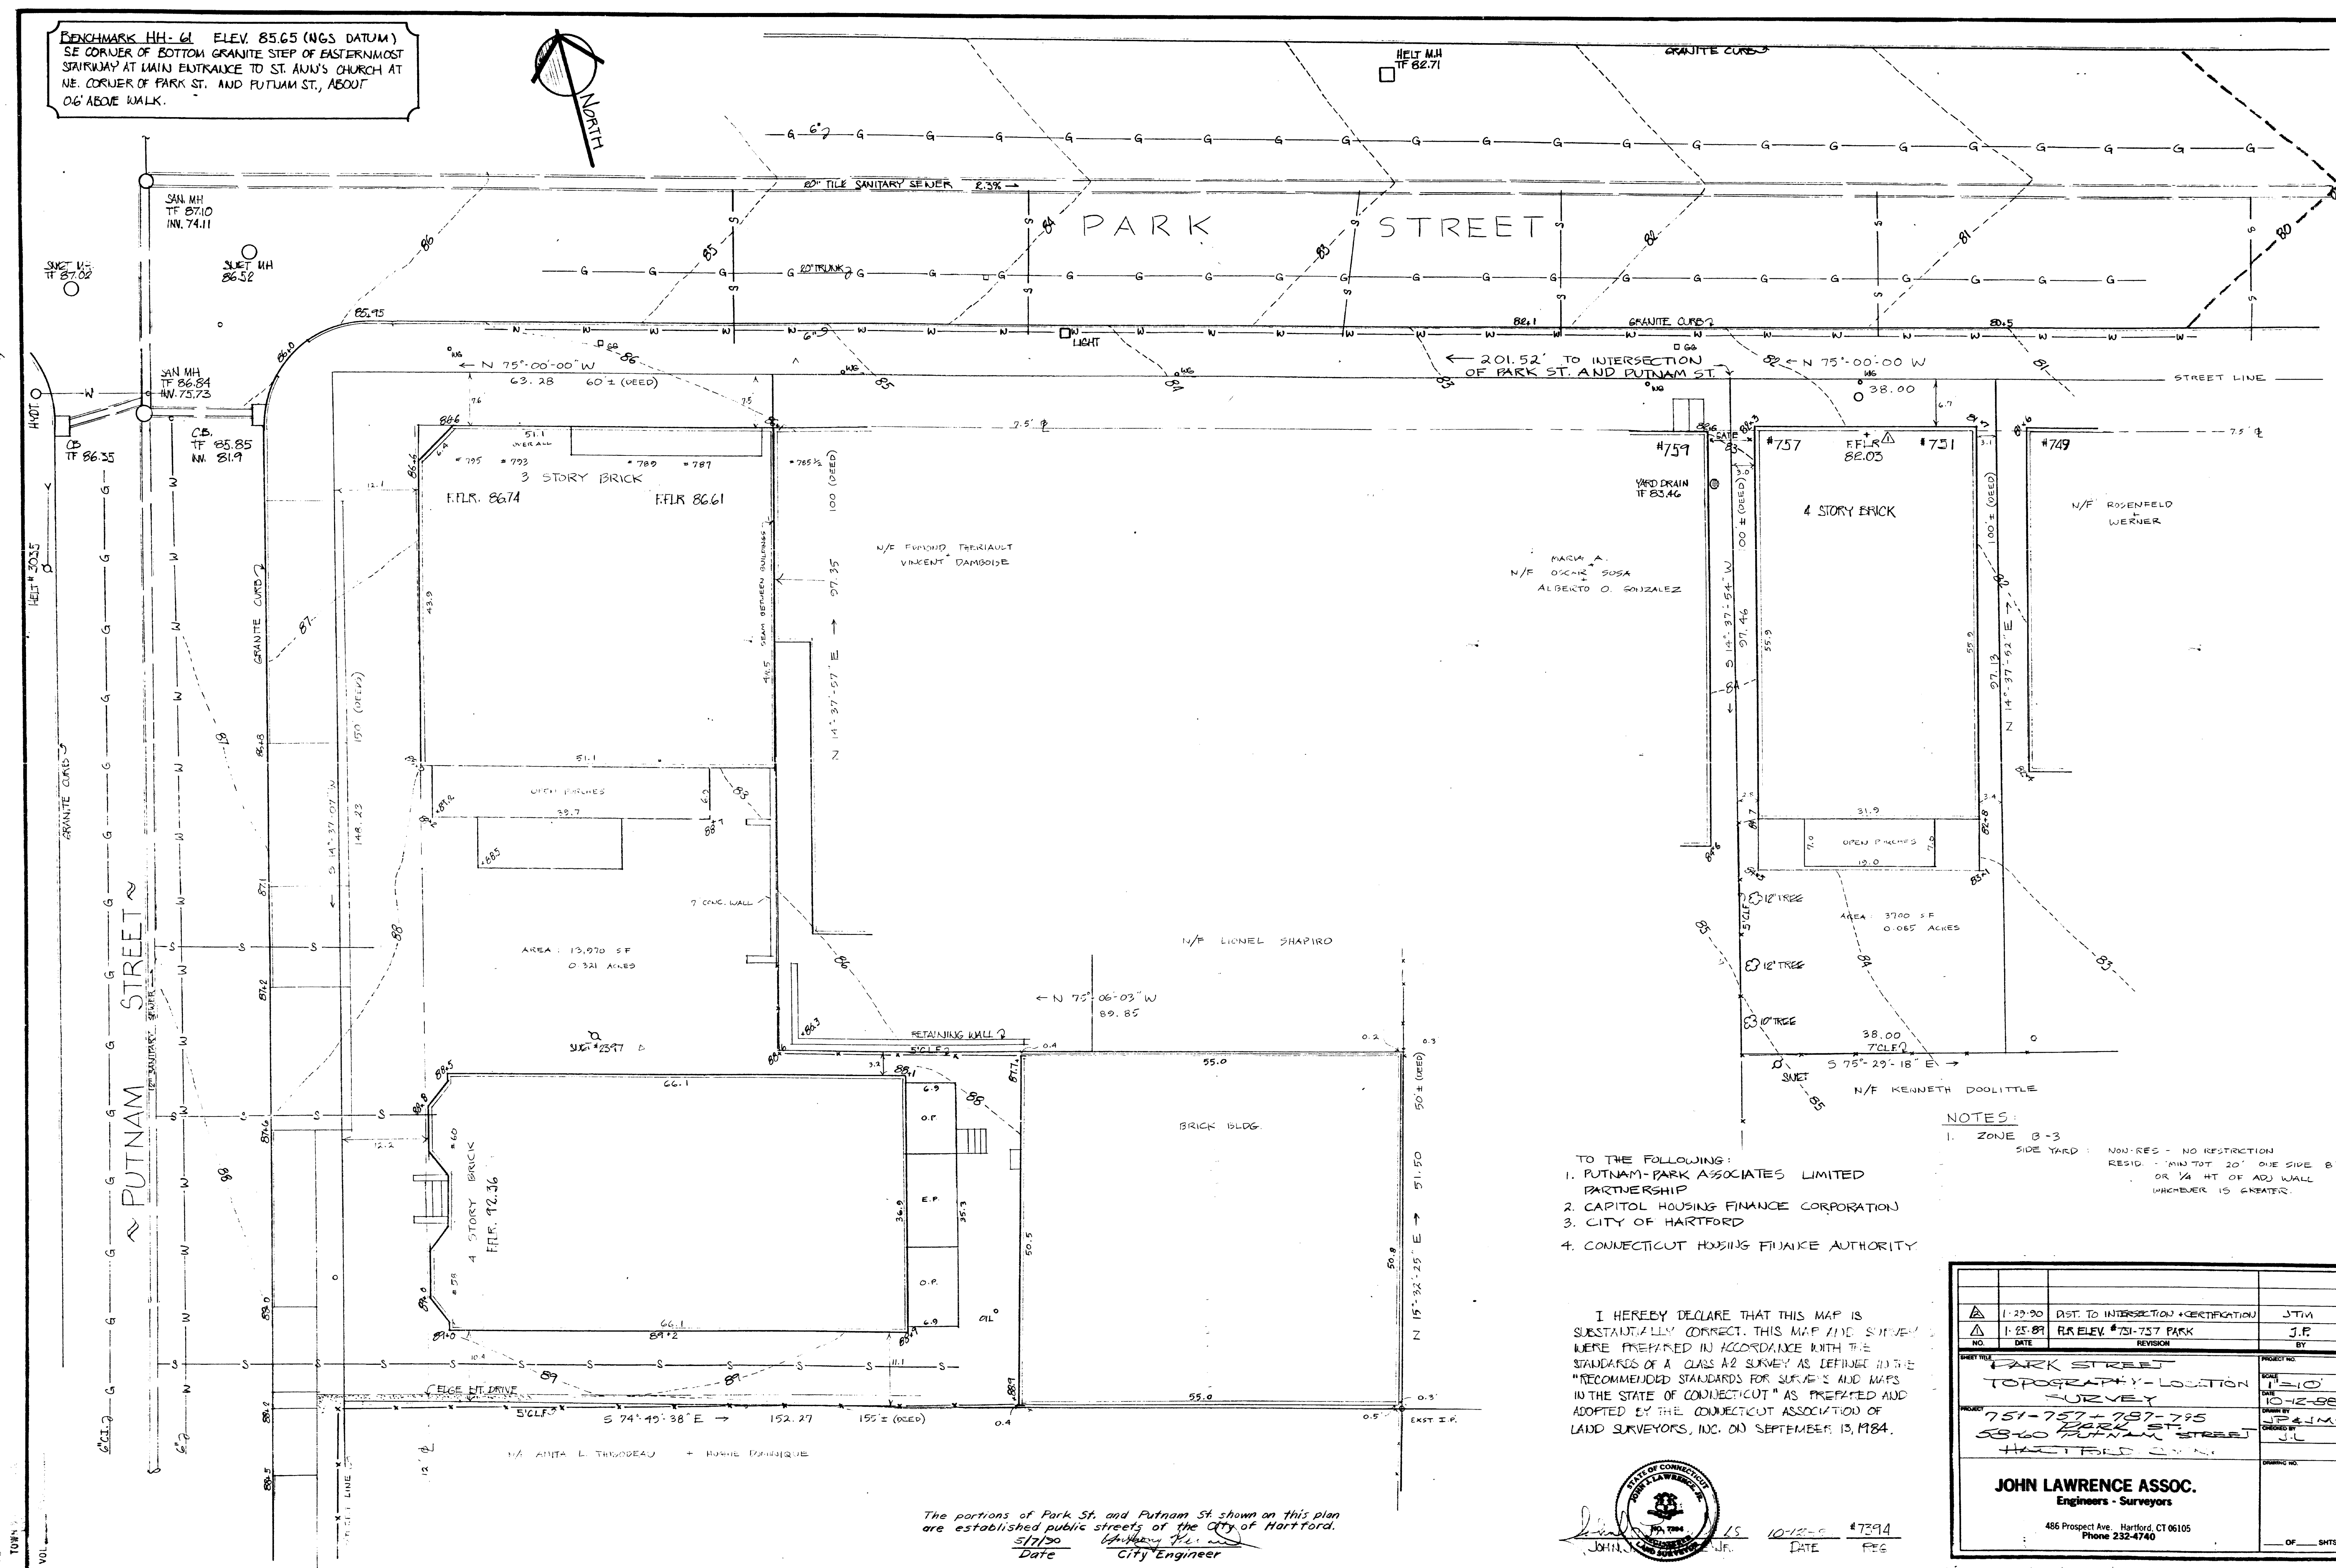

1919

1919

0 1 2 3 4