


64

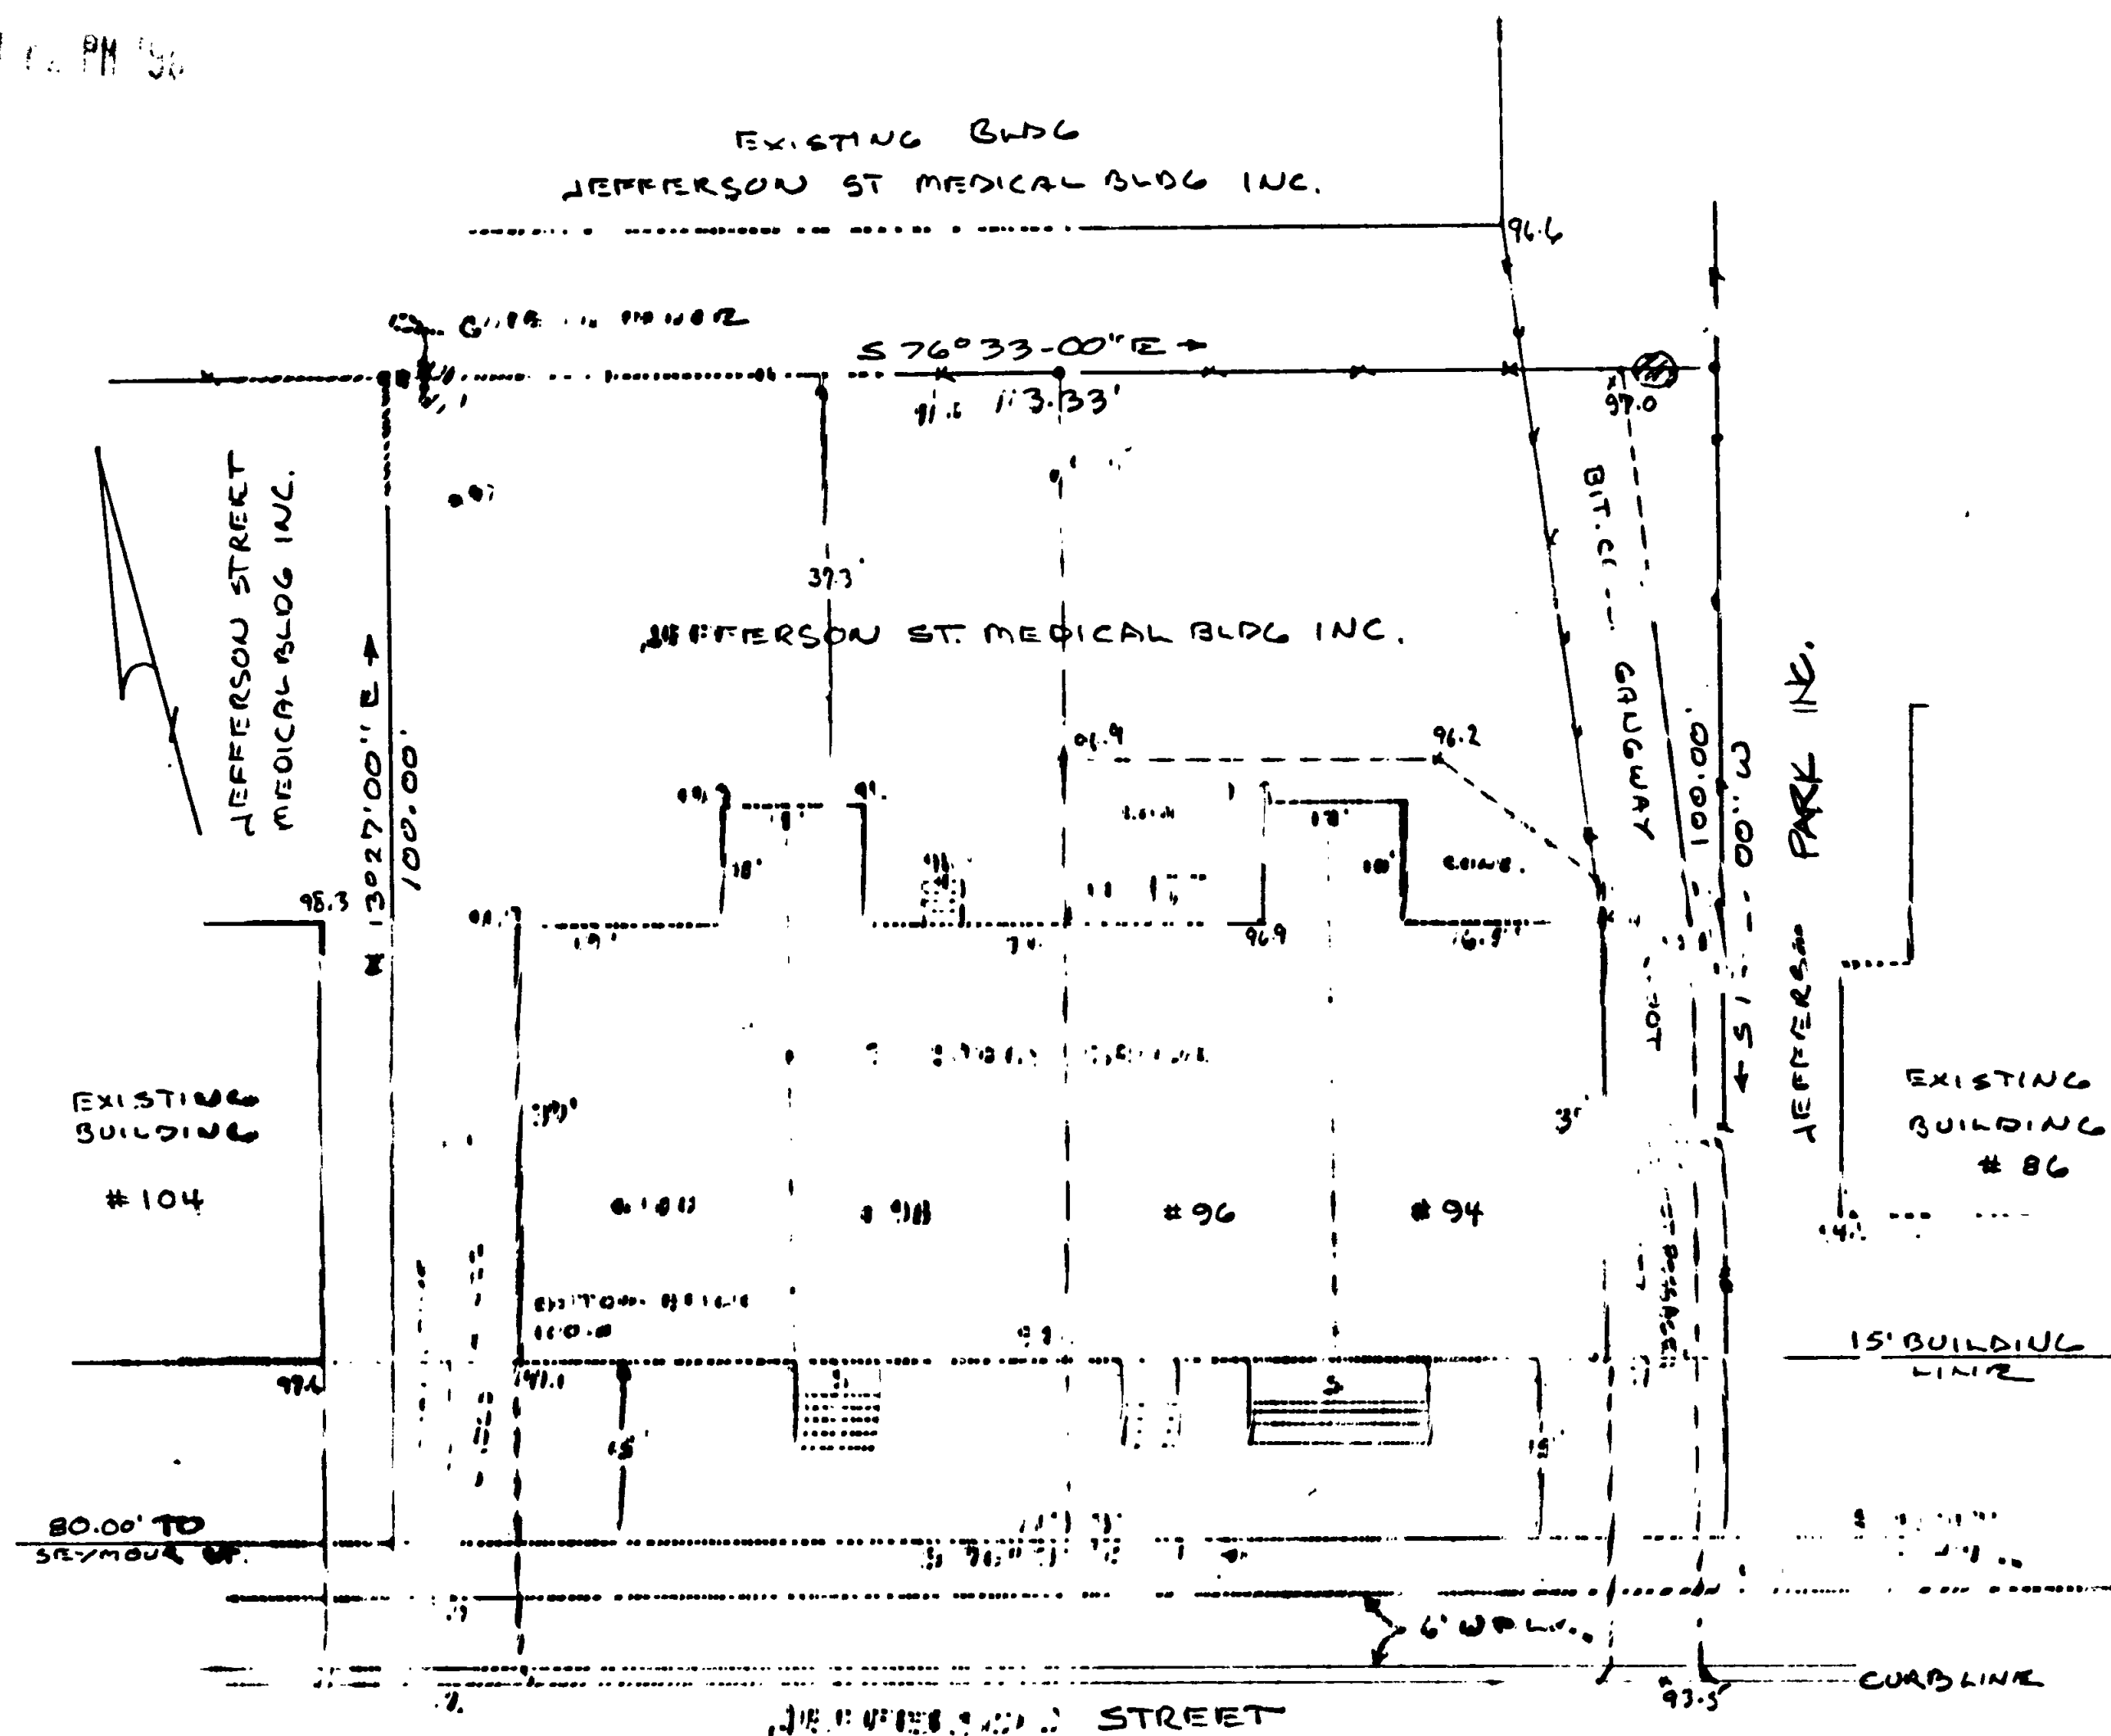

The portion of Jefferson St. shown on this plan is an established public street of the City of Hartford.

5/14/90 Anthony J. Pineda  
 Date City Engineer

THIS SURVEY WAS ACTUALLY MADE UPON THE GROUND AND I HEREBY CERTIFY TO THE ABOVE THAT IT AND THE BOUNDS AND MEASUREMENTS SHOWN HEREON ARE CORRECT WITHIN THE STANDARDS OF CLASS A-2 OF THE CODE OF PRACTICE FOR STANDARDS OF ACCURACY OF SURVEYS AND MAPS, ADOPTED DECEMBER 10, 1975 AS AMENDED BY THE CONNECTICUT ASSOCIATION OF LAND SURVEYORS, INC. AND THAT TITLE LINES AND LINES OF ACTUAL POSSESSION ARE THE SAME; BUILDINGS AND OTHER IMPROVEMENTS ARE LOCATED AS SHOWN AND DO NOT ENCROACH OVER OR OVERHANG ON TO ANY OTHER LAND, STREET, TITLE OR BUILDING LINES, OR UPON ANY EASEMENT OR RIGHT OF WAY; THERE ARE NO VIOLATIONS OF ZONING REGULATIONS WITH REFERENCE TO THE LOCATIONS OF SAID BUILDINGS OR IMPROVEMENTS; AND THERE ARE NO EASEMENTS OR ENCROACHMENTS AFFECTING THIS PROPERTY, OTHER THAN THOSE SHOWN, APPARENT FROM A CAREFUL INSPECTION OF THE LAND.

Richard T Tourville  
SUNNYVALE RICHARD T TOURVILLE L.S.  
24 WINDING LAKE  
AVON CONN 06001

LAND SURVEY  
CITY OF HARTFORD  
PLAN DRAWING PROPERTY  
G!  
JEFFERSON STREET MEDICAL BLDG.  
INC.  
94-100 JEFFERSON ST.  
SCALE 1" = 20' 3-22-90



1923

