1927-5

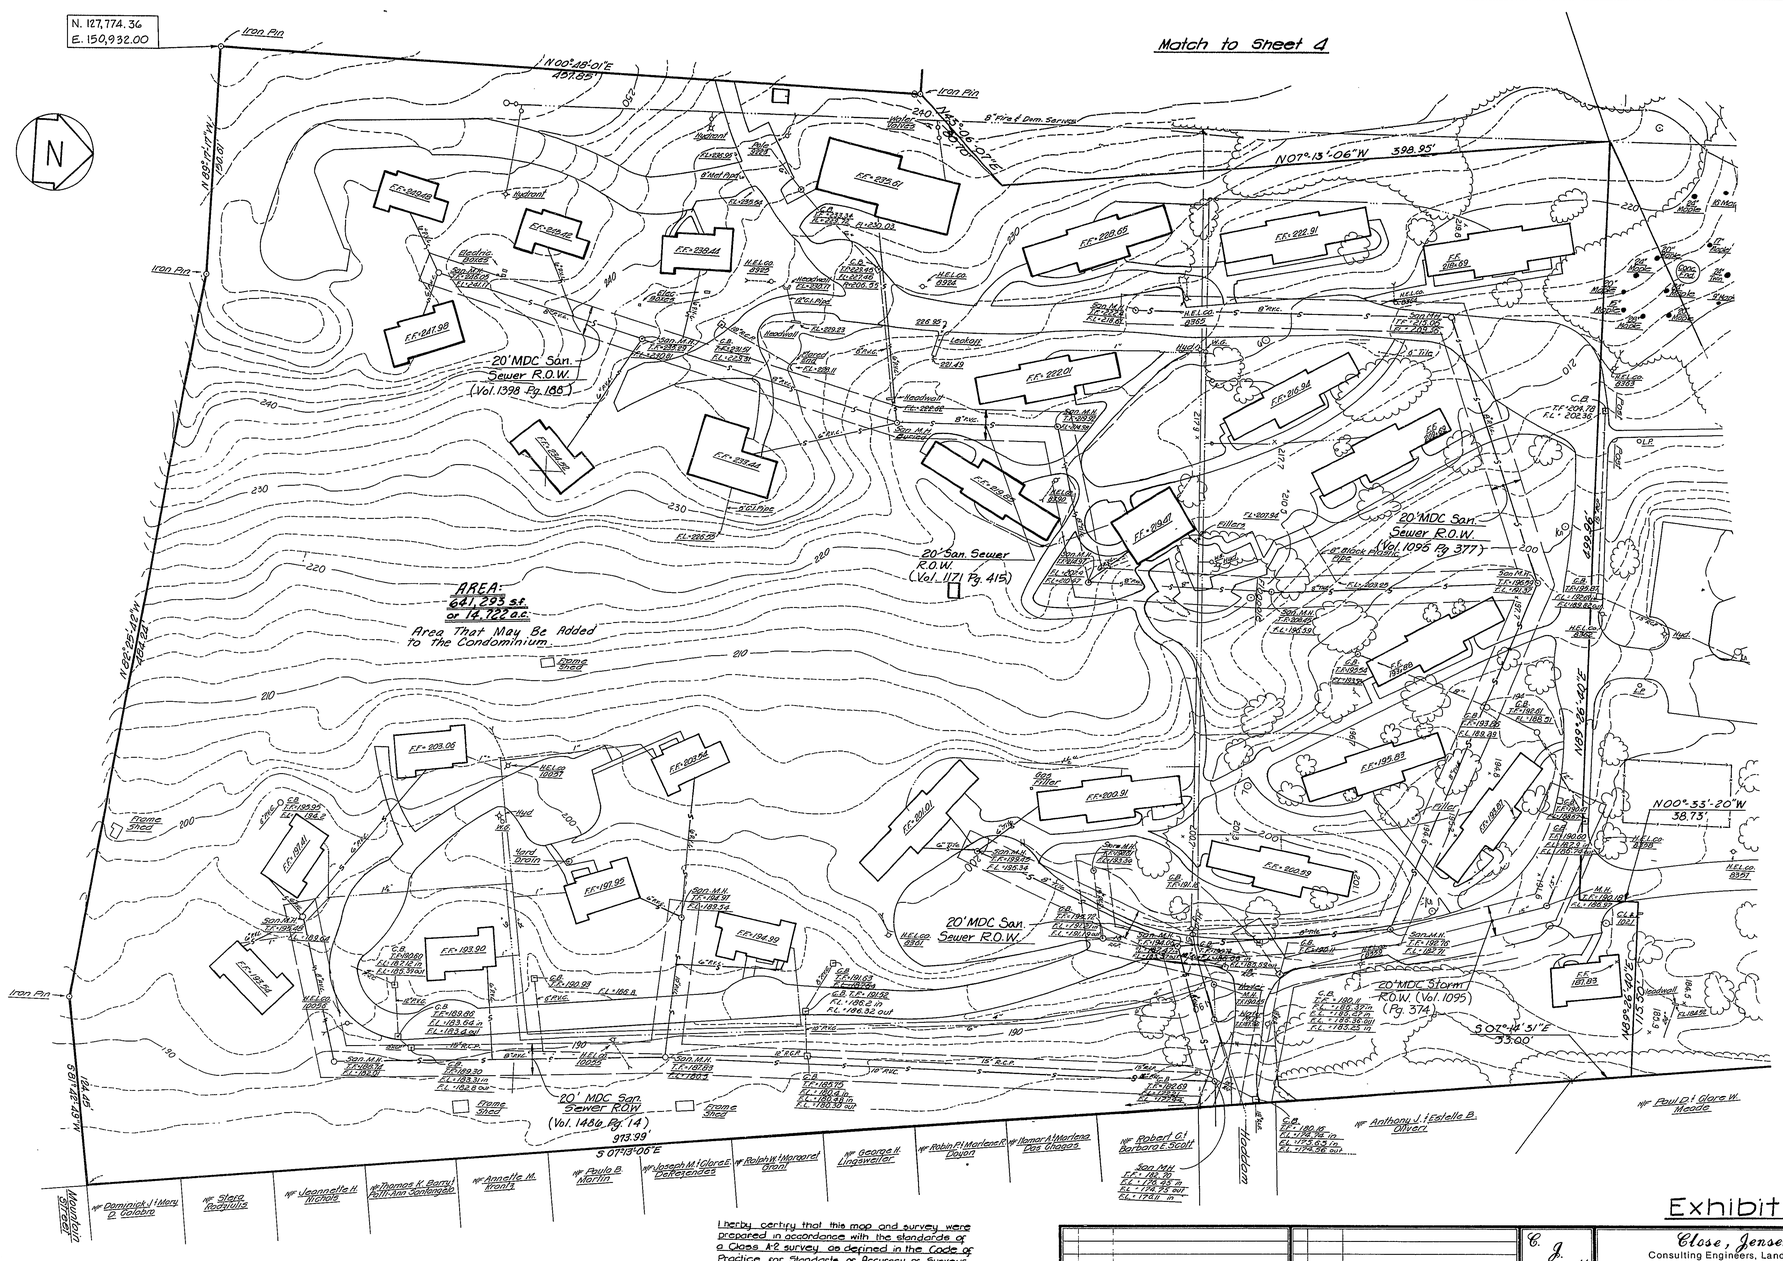

Exhibit A-3

I hereby certify that this map and survey were prepared in accordance with the standards of a Class A-2 survey as defined in the Code of Practice for Standards of Accuracy of Surveys and Maps, adopted December 10, 1975, and as amended by The Connecticut Association of Land Surveyors, Inc. and that this survey contains all the information required of a survey under Connecticut General Statutes section 47-228 (Common Interest Ownership Act.)

Close, Jensen & Miller
Civil Engineers & Surveyors
By John H. Miller

No.	Date	Description
		Revisions

STATE OF CONNECTICUT JOHN H. MILLER No. 4142 REGISTERED LAND SURVEYOR

C. J. M.

Close, Jensen & Miller
Consulting Engineers, Land Planners & Surveyors
1137 Silas Deane Highway Wethersfield, Connecticut 06109

Avery Heights

705 New Britain Avenue

Hartford, Connecticut

Designed	
Drawn	RBB/RB
Checked	P.W.H.
Scale	1" = 40'
Date	May 1990
Sheet No.	5
Of	10
Job No.	35613
File No.	

EAST FILE CORP. IRVINE CA. 1927 EFA-34

107/927

0 INCHES 1 2 3 4