1927-6

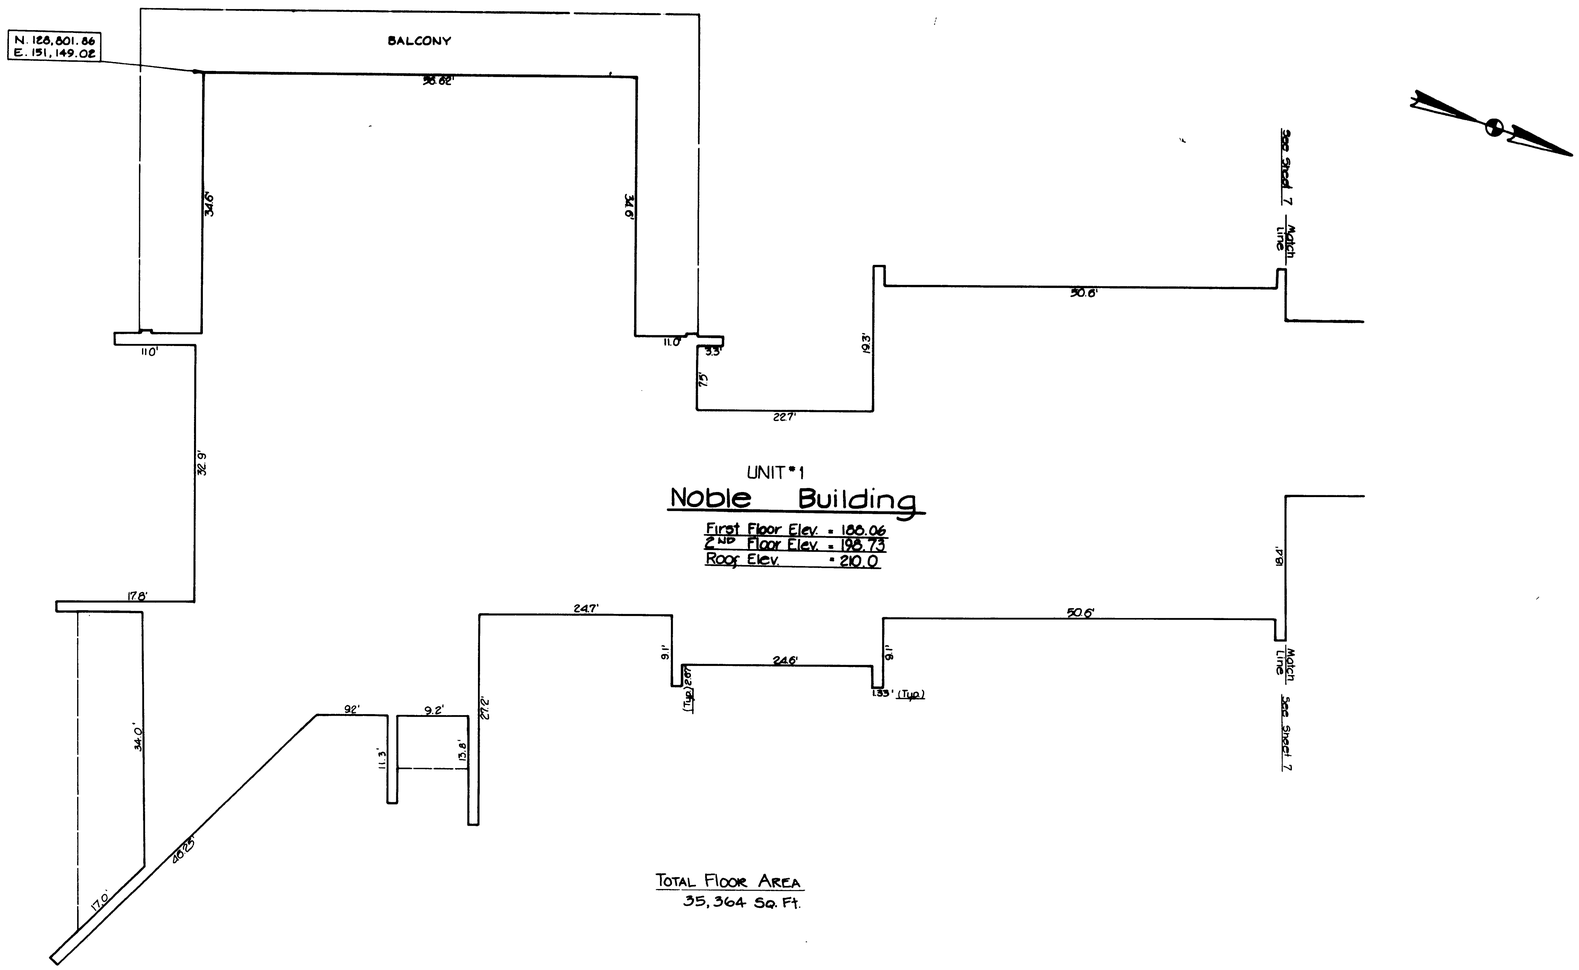

UNIT #1

Noble Building

First Floor Elev. = 188.06
2ND Floor Elev. = 198.73
Roof Elev. = 210.0

TOTAL FLOOR AREA
35,364 SQ. FT.

I hereby certify that this map and survey were prepared in accordance with the standards of a Class A2 survey as defined in the Code of Practice for Standards of Accuracy of Surveys and Maps, adopted December 10, 1979, and as amended by the Connecticut Association of Land Surveyors, Inc. and that this map and contains all the information required by the survey under Connecticut General Statutes, section 47-33b (Common Interest Ownership Act).

Signature of Surveyor
Date
By: [redacted]

Exhibit A-4

No.	Date	Description
		Revisions

No.	Date	Description
		Revisions

C. J. M.

Close, Jensen & Miller
Consulting Engineers, Land Planners & Surveyors
1137 Silas Deane Highway Wethersfield, Connecticut 06109

Avery Heights
705 New Britain Avenue
Hartford Connecticut

Designed
Drawn R.C.B.
Checked P.W.H.
Scale 1" = 40'
Date May 1990
Sheet No. 6
of 10
Job No. [illegible]
File No.

107 1927