


1927-7

N 128,971.21  
E 151,010.33

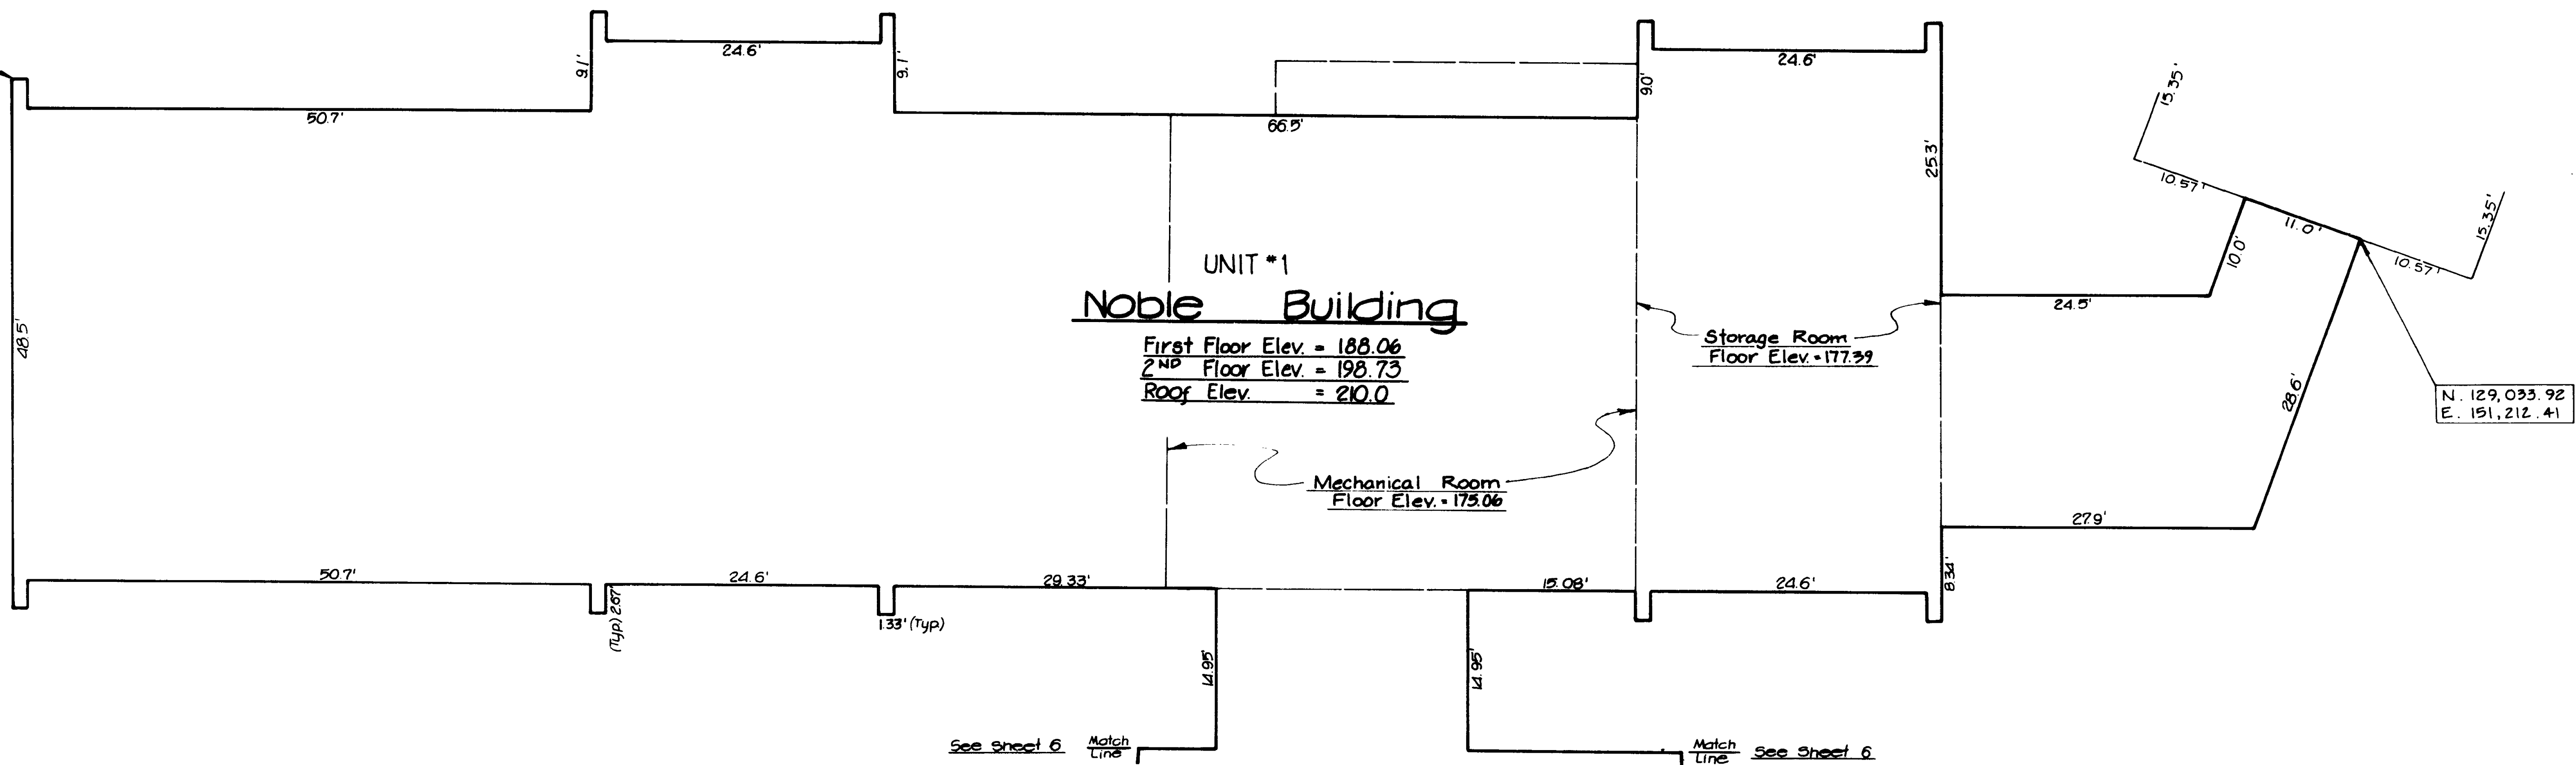

1927-7

I hereby certify that this map and survey were prepared in accordance with the standards of a Class A-2 survey as defined in the Code of Practice for Standards of Accuracy of Survey and Maps, adopted December 19, 1960, and as amended by the Connecticut Association of Land Surveyors, Inc. and that this survey contains all the information required by a survey under Connecticut General Statutes, section 37-603 (Common Interest Boundary).

*James J. Miller*  
Civil Engineer  
by *James J. Miller*

Exhibit A-4

|                                |  |                                                   |  |   |  |                                                                              |  |
|--------------------------------|--|---------------------------------------------------|--|---|--|------------------------------------------------------------------------------|--|
| No. Date Description Revisions |  | B. J. M.                                          |  | Bloss, Jensen & Miller<br>Consulting Engineers, Land Planners & Surveyors<br>1137 Silas Deane Highway Wethersfield, Connecticut 06109 |  | Designed<br>Drawn R.C.B.<br>Checked P.W.H.<br>Scale 1" = 6'<br>Date May 1980 |  |
| No. Date Description Revisions |  | No. 4148<br>STATE OF CONNECTICUT<br>LAND SURVEYOR |  | Avery Heights<br>705 New Britain Avenue<br>Hartford, Connecticut                                                                      |  | Sheet No. 7<br>Of 10<br>Job No. 25518<br>File No.                            |  |

107 1927  
0 INCHES 1 2 3 4