


RECEIVED BY
JUN 15 1990
V.L.

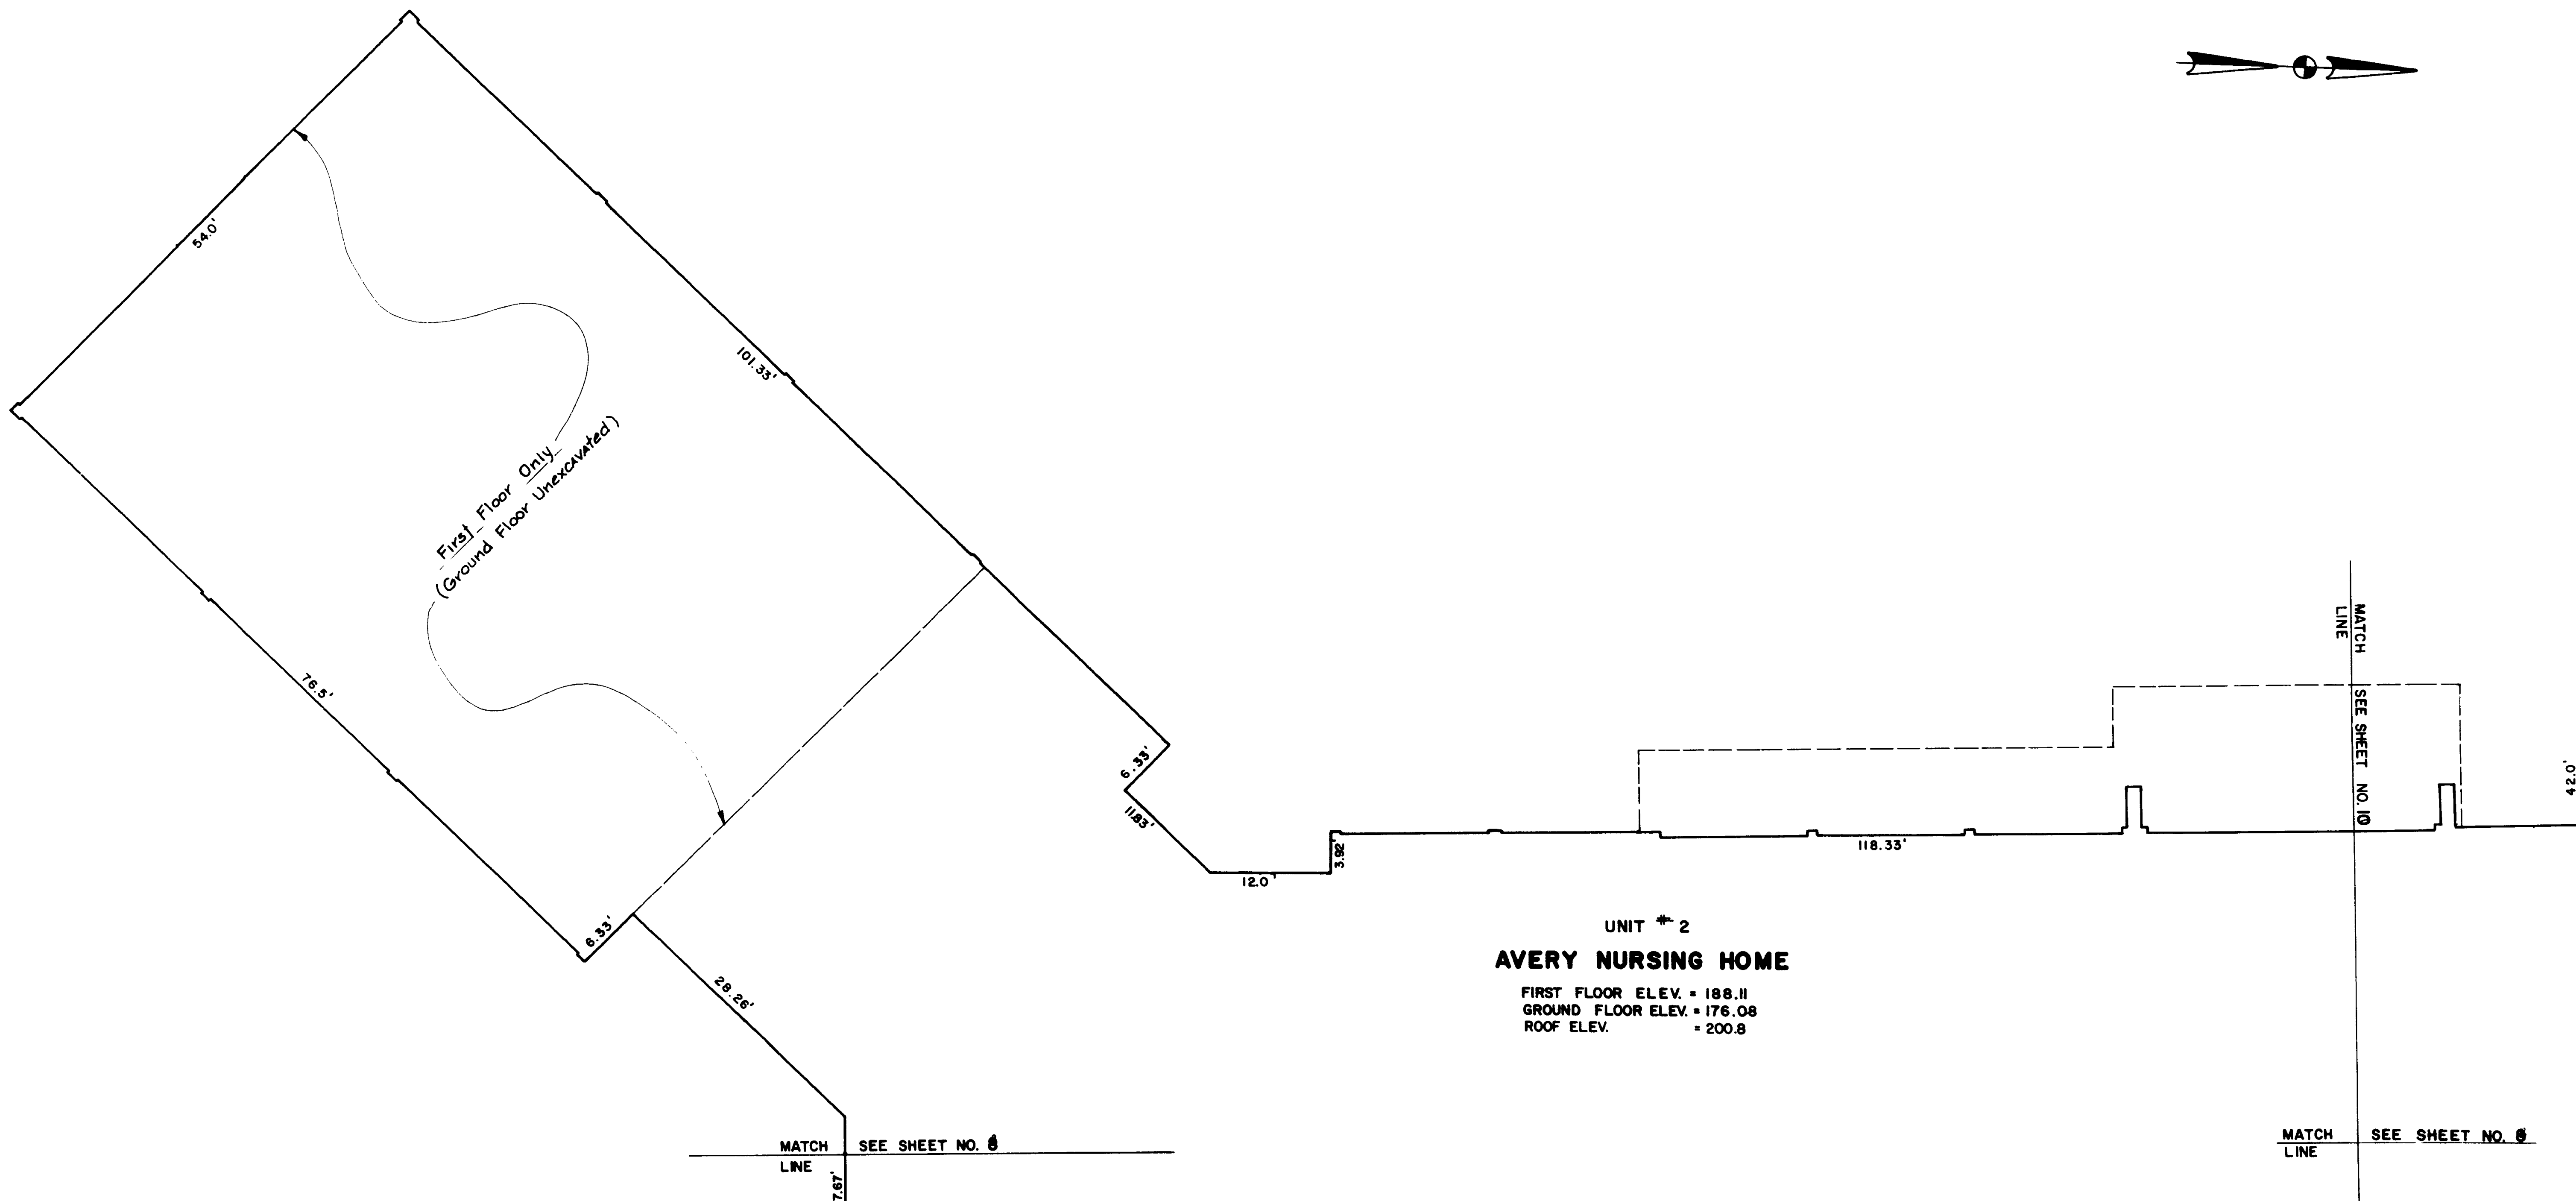


UNIT # 2
AVERY NURSING HOME
FIRST FLOOR ELEV. = 188.11
GROUND FLOOR ELEV. = 176.08
ROOF ELEV. = 200.8

I hereby certify that this map and survey were prepared in accordance with the standards of a Class A-1 survey as defined in the Code of Practice or Standards of Accuracy of Surveys and Maps adopted December 10, 1979, and as amended by the Connecticut Association of Land Surveyors, Inc. and that this survey contains all the information required of a survey under Connecticut General Statutes section 36-222 (Common Interest Ownership Act).

Glass, Jensen & Miller
Civil Engineers & Surveyors
By *[Signature]*

Exhibit A-4

No. Date Description Revisions		<i>E. J. M.</i>		Glass, Jensen & Miller Consulting Engineers, Land Planners & Surveyors 1137 Silas Deane Highway Wethersfield, Connecticut 06109		Designed Drawn JMM Checked PWH Scale 1/8" = 1'-0" Date MAY 1990	
No. Date Description Revisions				Avery Heights 705 New Britain Avenue Hartford, Connecticut		Sheet No. 9 Of 10 Job No. 36613 File No.	

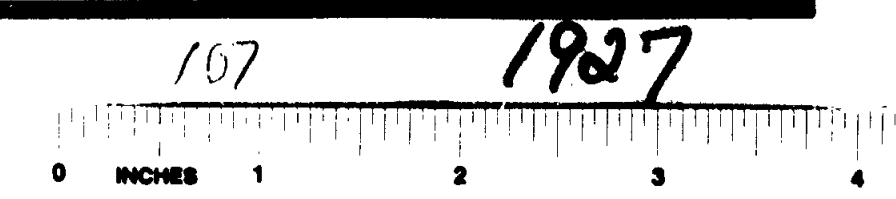

1927