


1932

RECEIVED BY
Jul 13 2 24 PM '90
TOWN CLERK
VOL. PAGE

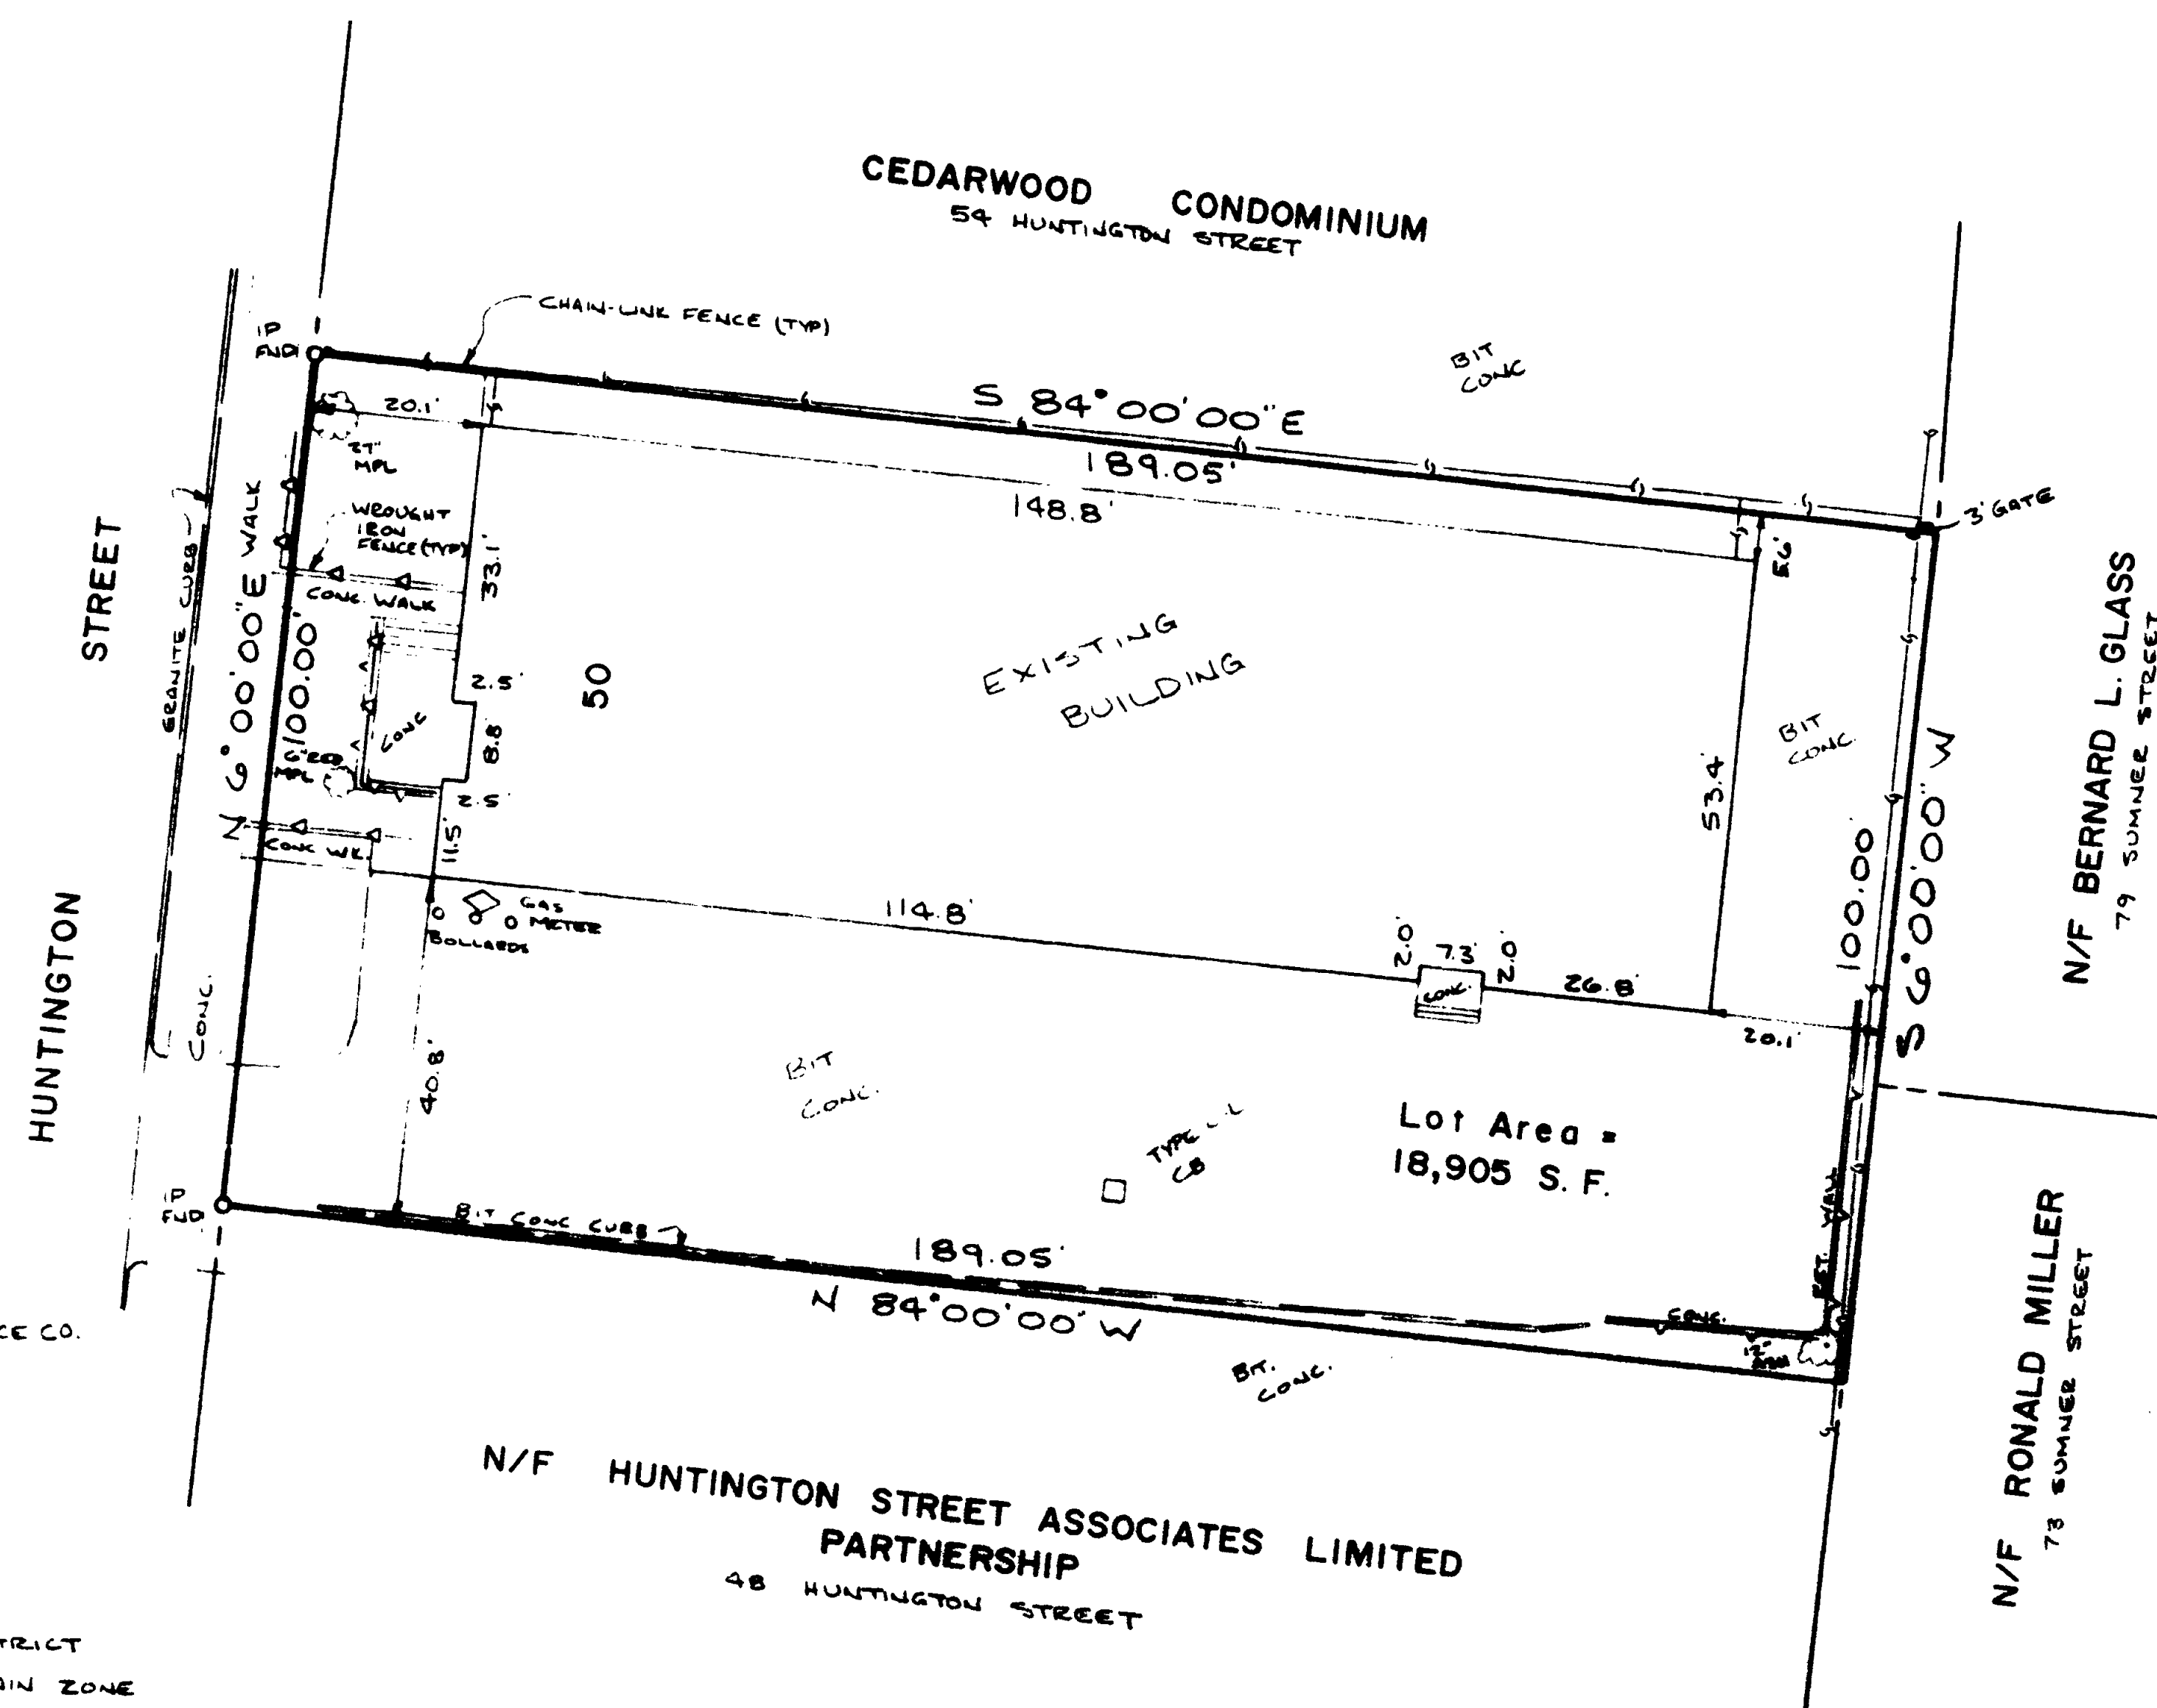

CERTIFIED TO:
THE BANK OF HARTFORD, INC.
CONNECTICUT ATTORNEYS TITLE INSURANCE CO.
RONALD A. & KAREN L. MILLER

ZONE: R02 RESIDENCE-OFFICE DISTRICT
PROPERTY IS NOT LOCATED IN A FLOOD PLAIN ZONE

REFERENCE IS MADE TO A MAP ON FILE
TITLED: "SURVEY & PLANS FOR HUNTINGTON
ASSOCIATES DECLARANT OF CEDARWOOD
CONDOMINIUM 54 HUNTINGTON STREET
HARTFORD, CONNECTICUT DATE AUGUST
1, 1980 BY MYRON FENWISTEN ASSOCIATES
LAND SURVEYING & PLANNING WEST HARTFORD
CONNECTICUT

PREPARED FOR
RONALD MILLER
HARTFORD, CONN.

I hereby declare that this map is substantially correct.
This map and survey were prepared in accordance
with the standards of a Class A-2 survey as
defined in the Recommended Standards for Surveys
and Maps in the State of Connecticut as prepared
and adopted by The Connecticut Association of Land
Surveyors, Inc., on September 13, 1984.



The portion of Huntington St. shown on this plan is an
established public street of the City of Hartford.
7/16/90
Date

James E. Aebchlian
14201

AEBCHLIAN LAND SURVEYING
GLASTONBURY, CONN.
Date 6-7-90 Scale 1" = 20' 112

