


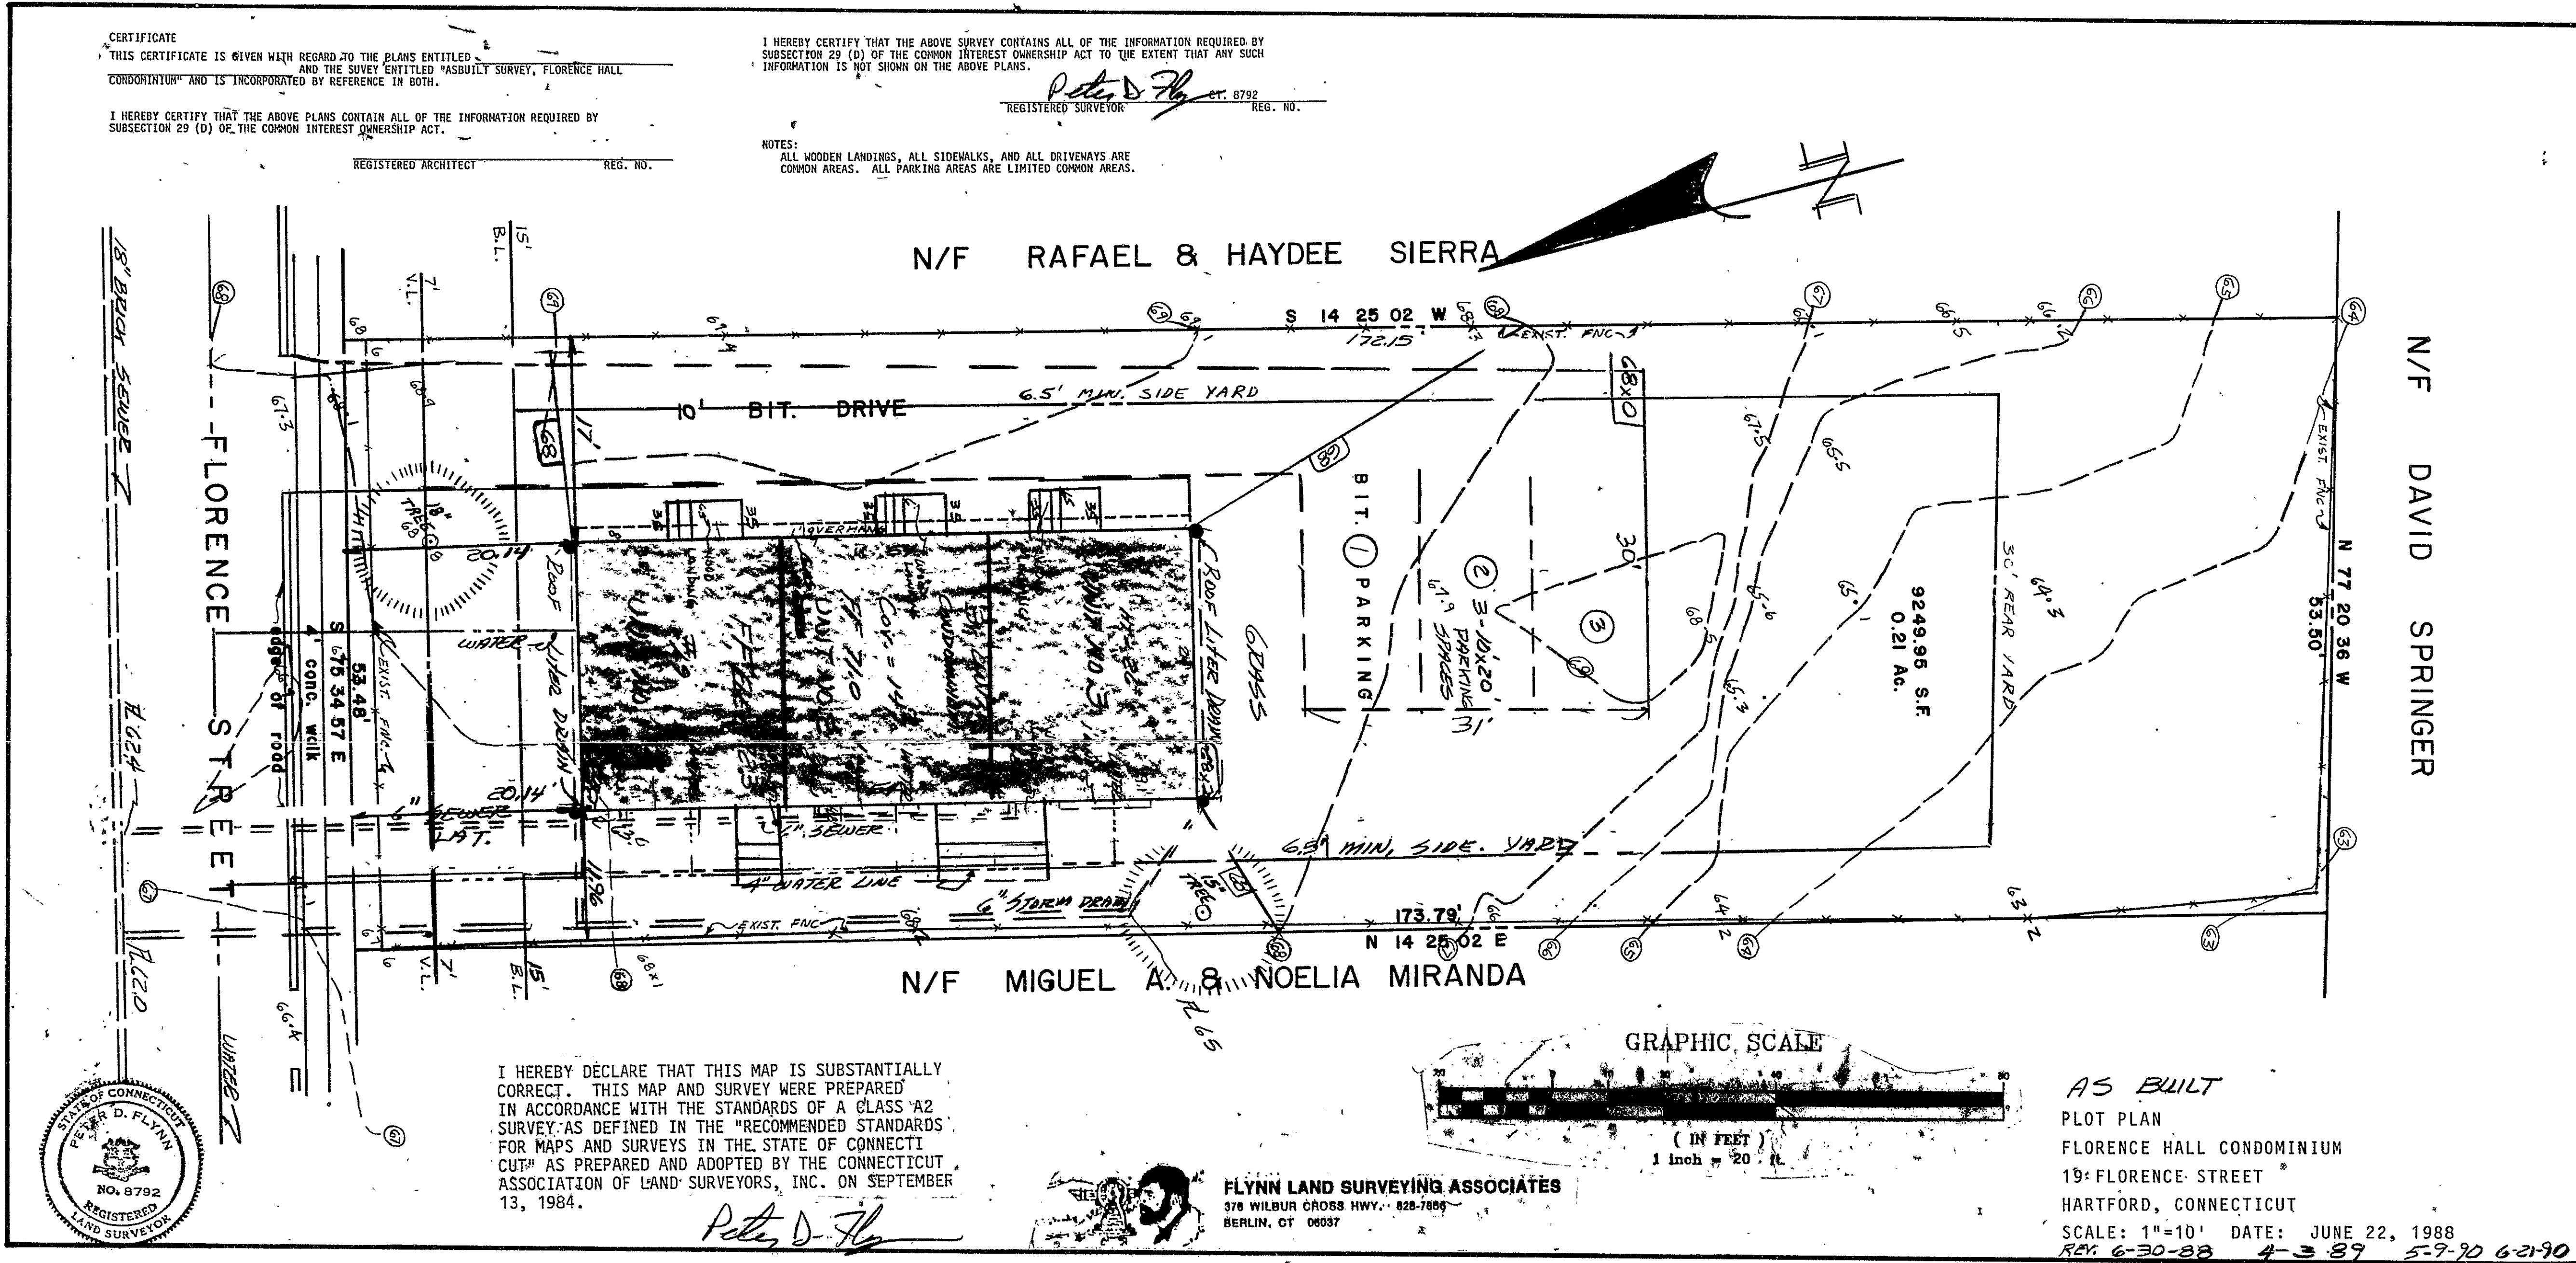

The portion of Florence St. on this plan is an established public street of the City of Hartford
Date 7/24/90 City Engineer