
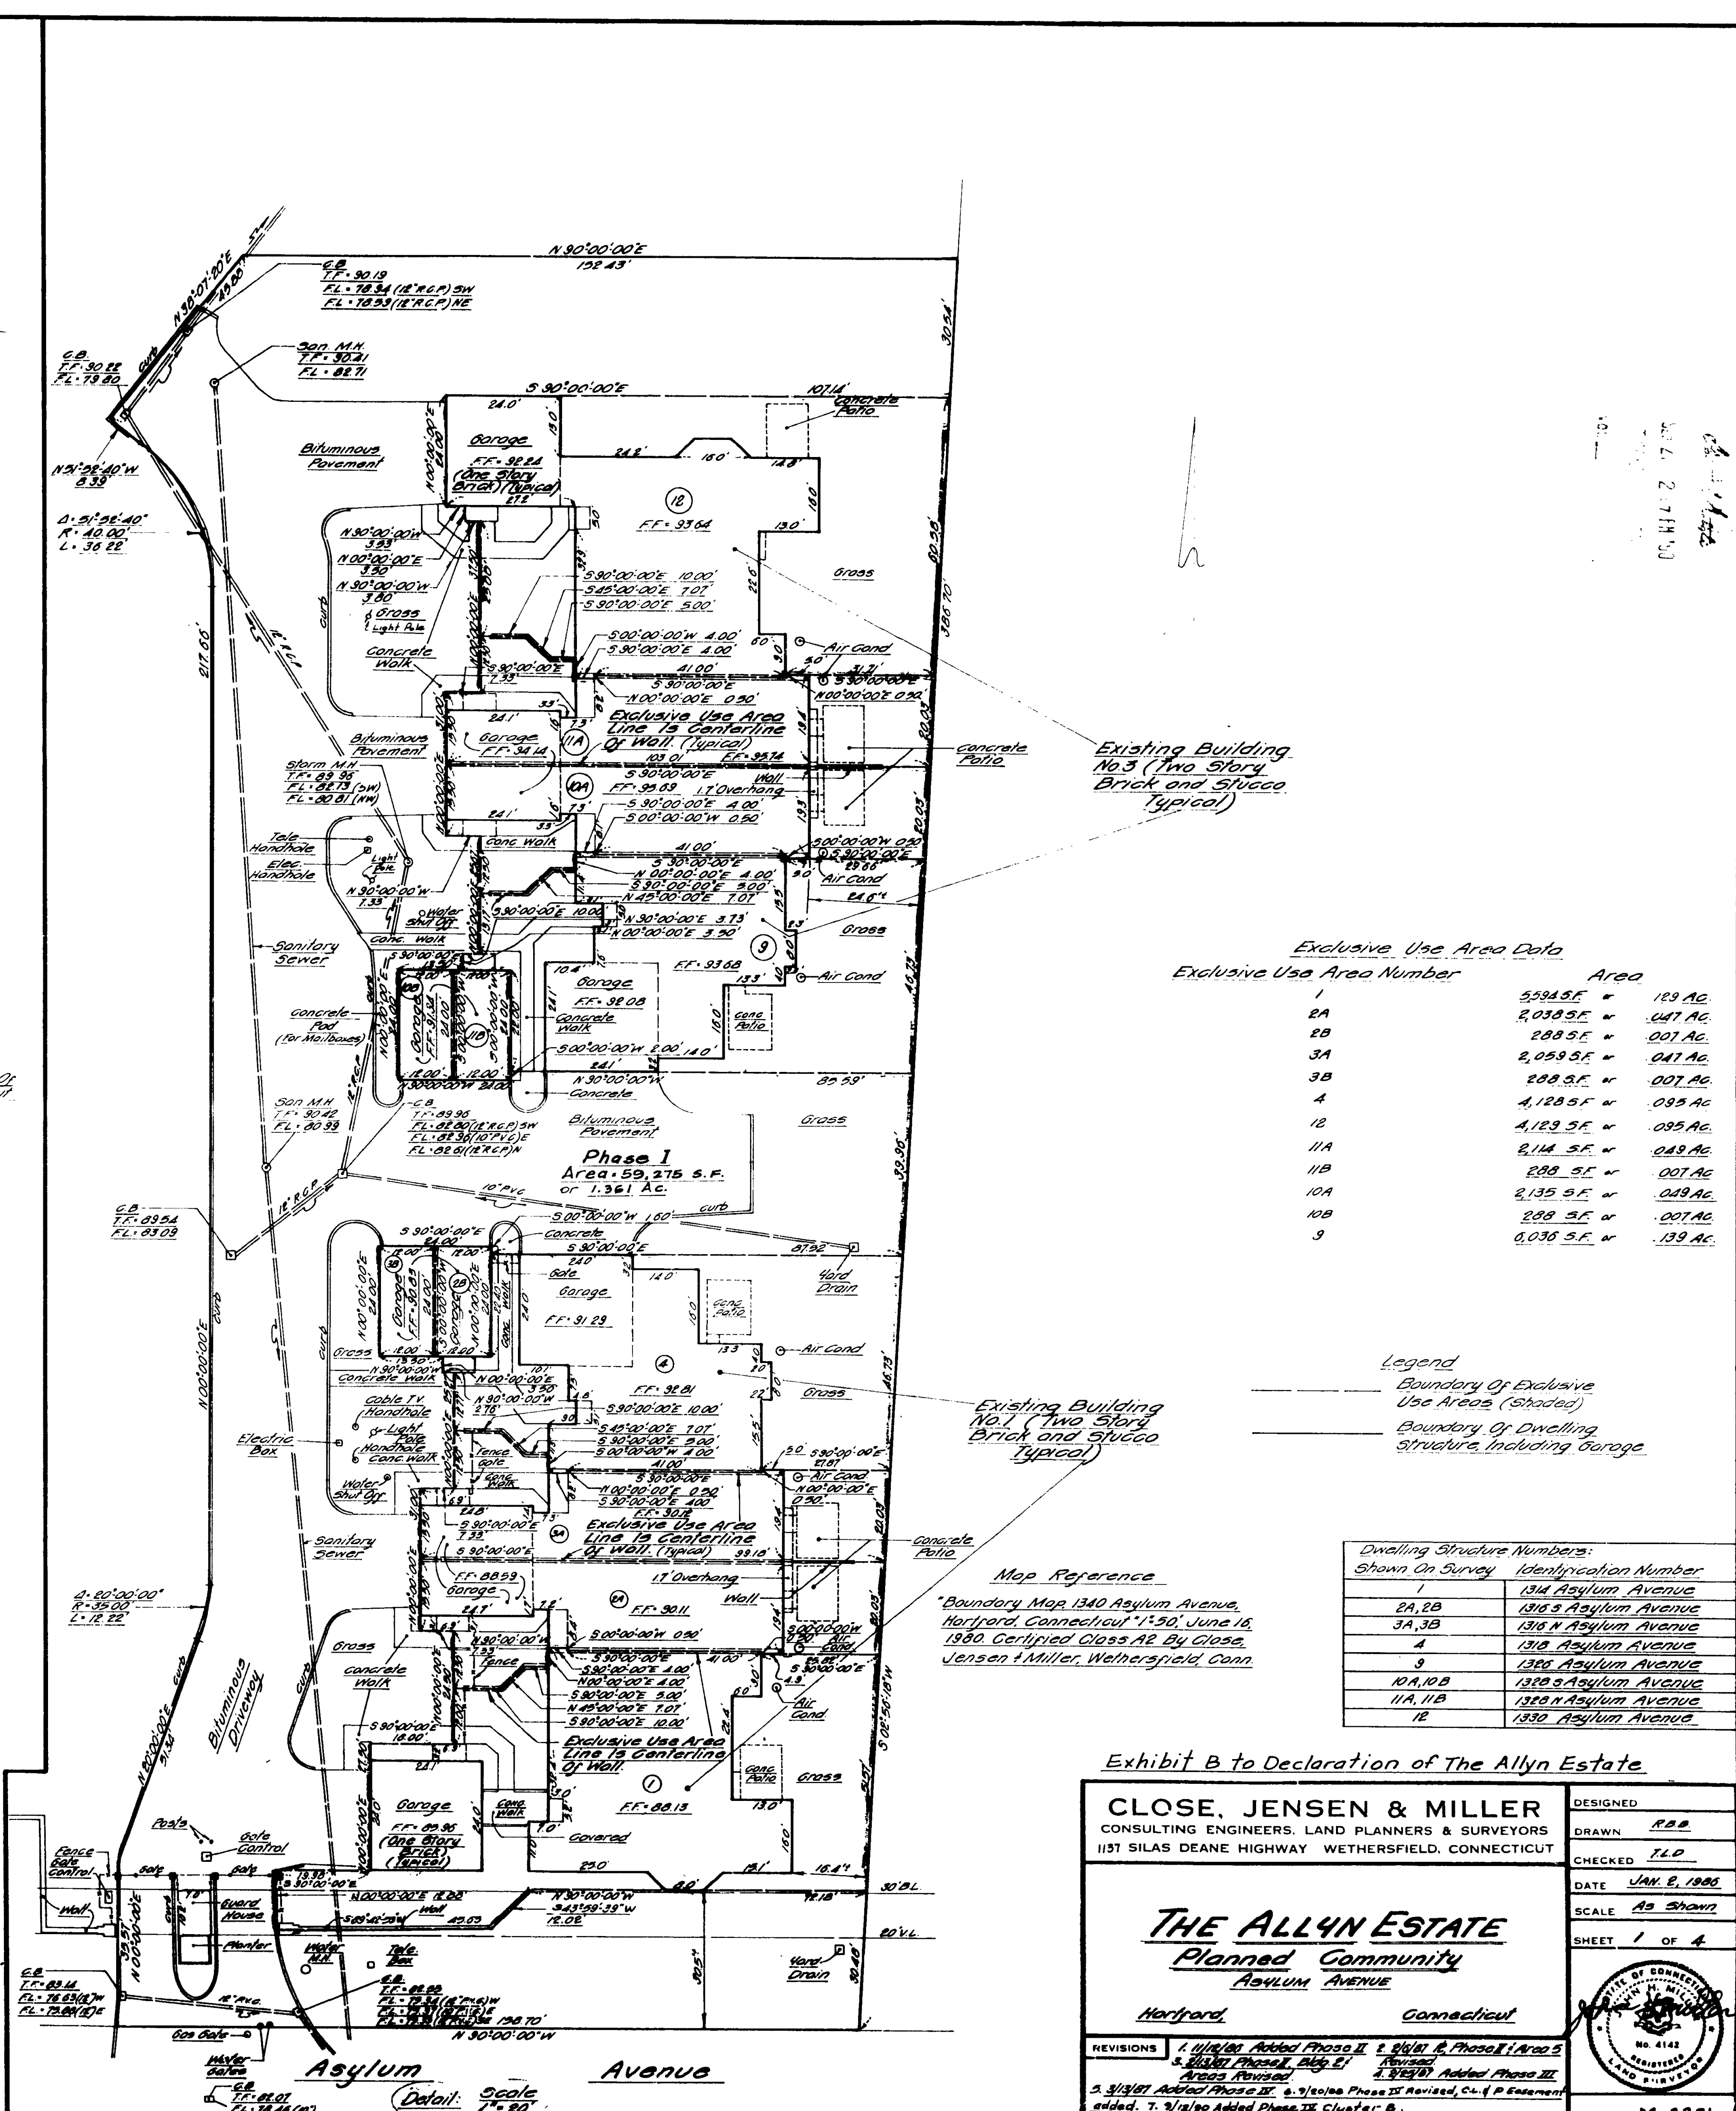


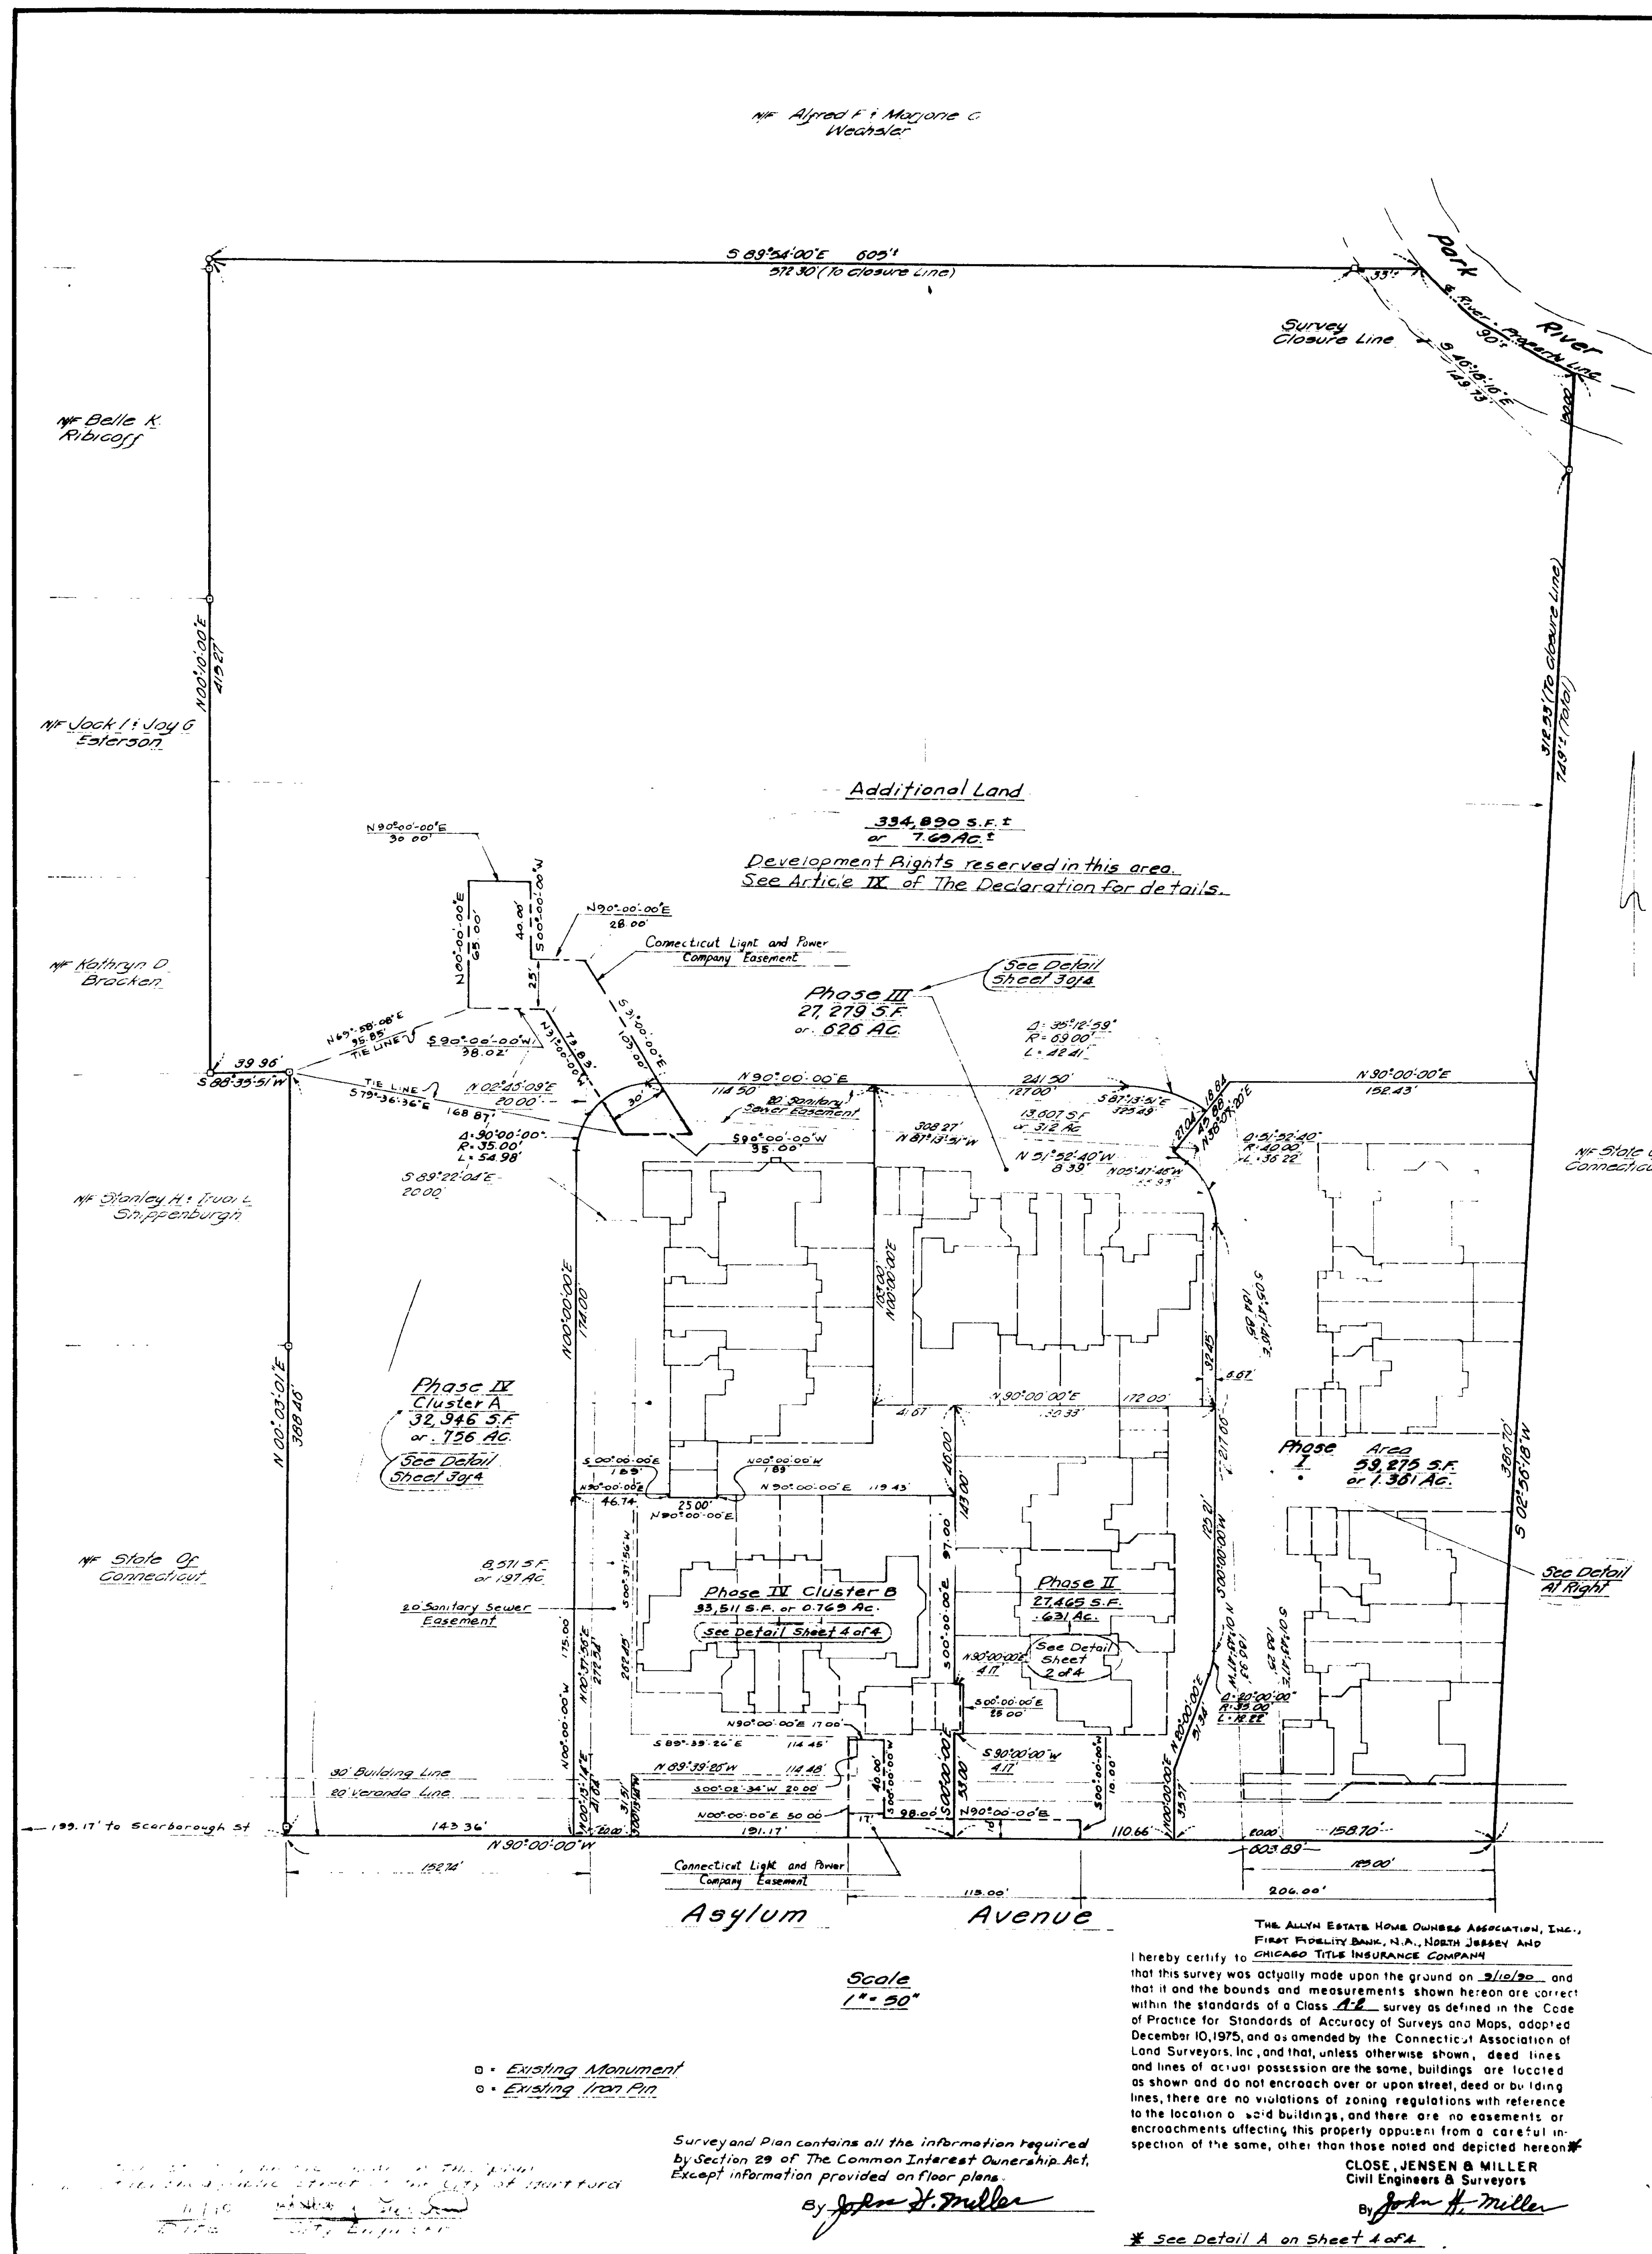

Exclusive Use Area Data

Exclusive Use Area Number	Area
1	5,594.55' = 129 Ac.

Legend

Boundary Of Exclusive Use Areas (Shaded)

Boundary Of Dwelling Structure, Including Garage

Dwelling Structure Numbers:

Shown On Survey	Identification Number

Exhibit B to Declaration of The Allyn Estate

CLOSE, JENSEN & MILLER
CONSULTING ENGINEERS, LAND PLANNERS & SURVEYORS
1137 SILAS DEANE HIGHWAY WETHERSFIELD, CONNECTICUT

SCALE: AS SHOWN
SHEET: 1 OF 4

THE ALLYN ESTATE
Planned Community
Asylum Avenue

Revisions:


Close, Jensen & Miller
Civil Engineers & Surveyors

Surveyors

