
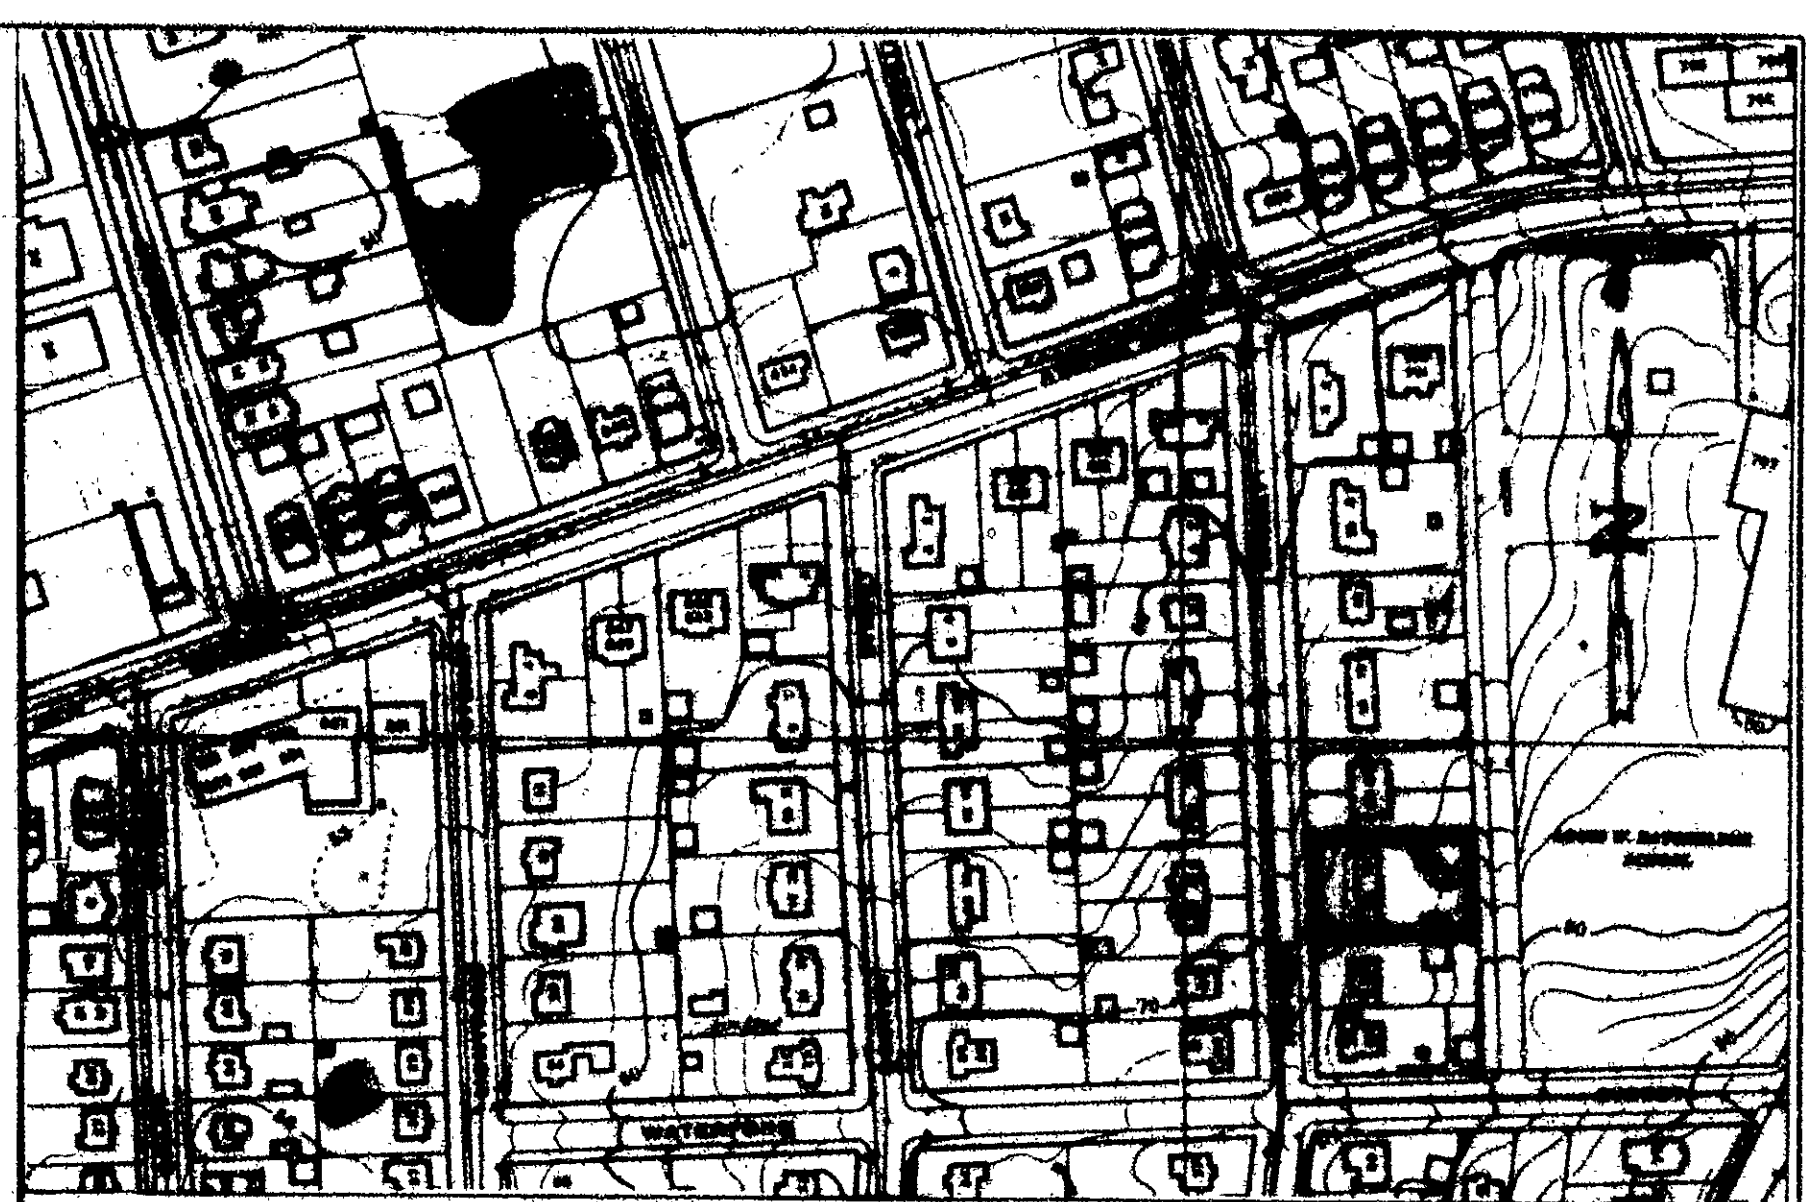


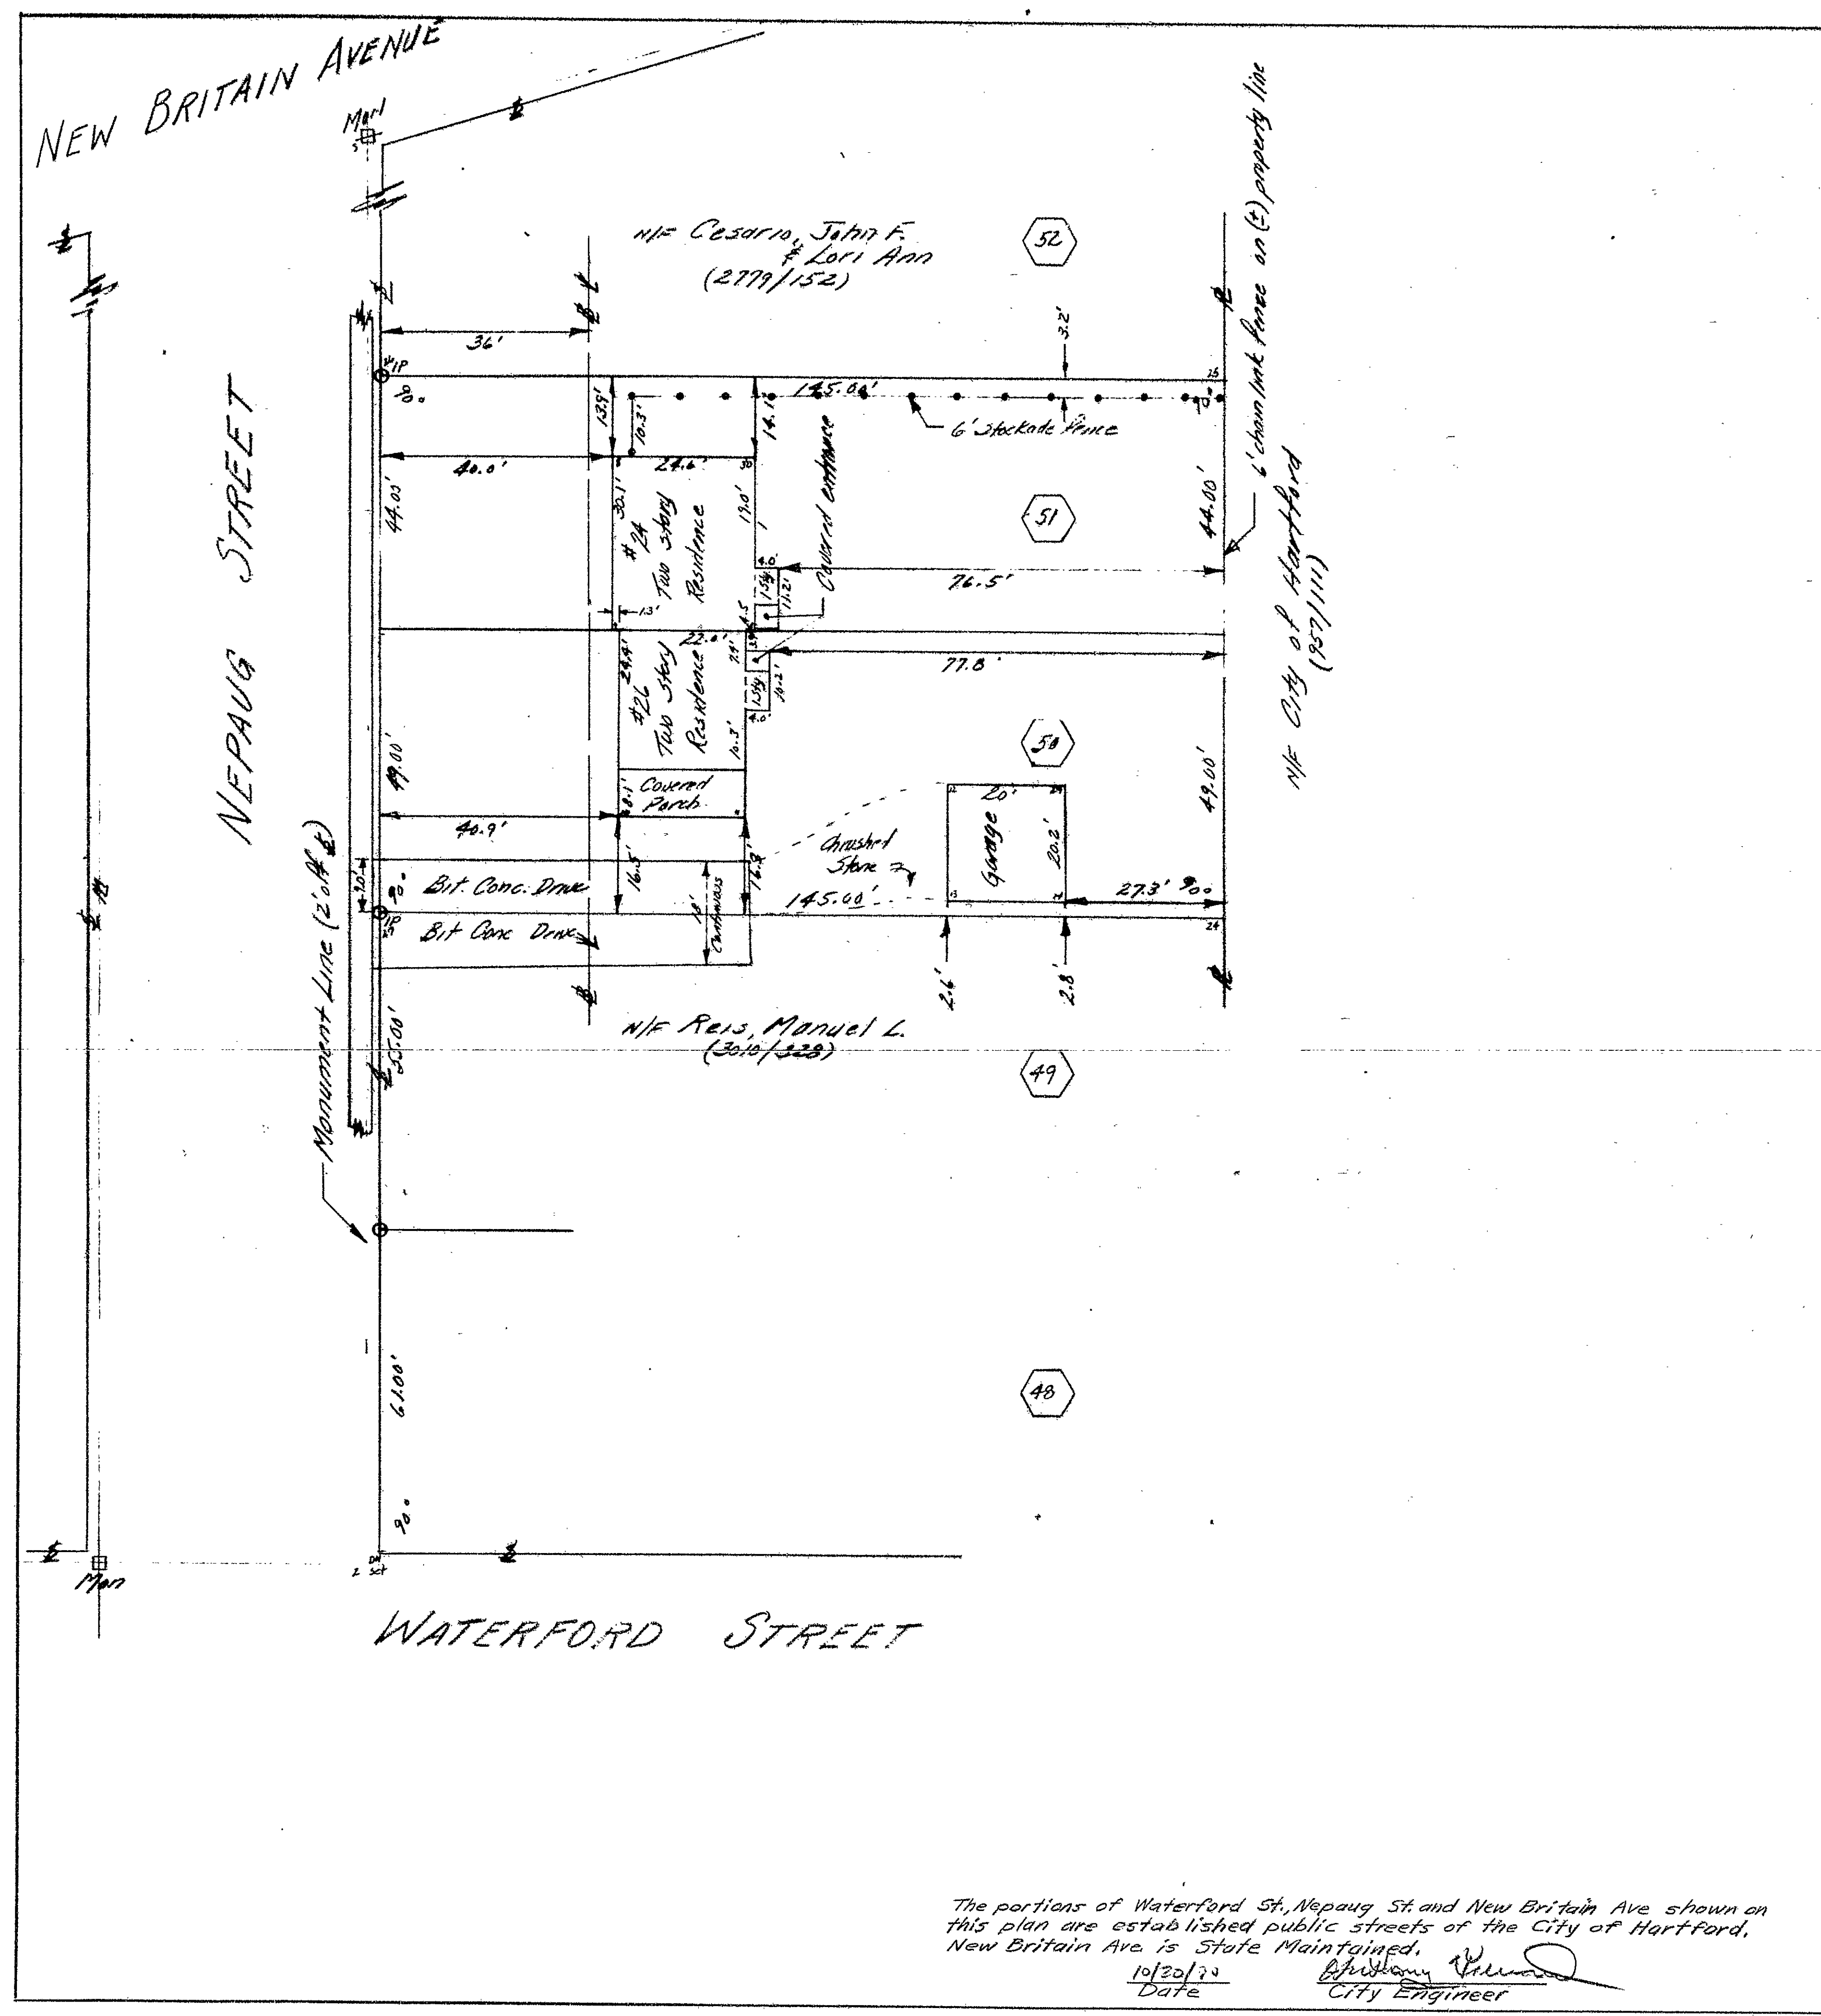

LOCALITY MAP SCALE 1"=200'

- SPECIAL NOTES:
1. For title see volume 1275 page 736.
 2. Zone X per FEMA FIRM City of Hartford, Connecticut; Hartford County; Community-Panel Number 095060 0005 B; Map Revised: December 4, 1986.
 3. Reference maps:
A. "Map of Property Map of Atwood's Corner Plot; The Hartford Home Company Hartford, Conn.; Scale 1"=50'; Aug. 1921." Edgar T. Duncan
 4. Distances to the property lines were measured from the siding or exterior of the appurtenance.
 5. ⑤ refers to lot numbers per the reference map noted above.

RECEIVED BY
Oct 24 2 49 PM '90
TOWN OF HARTFORD
H.F. 100

PROPERTIES (PLOTS 50 AND 51) OF
GARY P. SKEHAN
2801 26 NEPAUG STREET
HARTFORD, CONNECTICUT
OCTOBER 4, 1990 1"=20'

I hereby declare that this map is substantially correct. This map and survey were prepared in accordance with the standards of a Civil Survey as defined in the "Revised Standard for Surveyors and Map Makers of Connecticut" as proposed and adopted by the Connecticut Association of Land Surveyors, Inc. on September 13, 1984.

E. B. Harvey, Jr.
L. S. #4652

10/20/79 Date

City Engineer

