


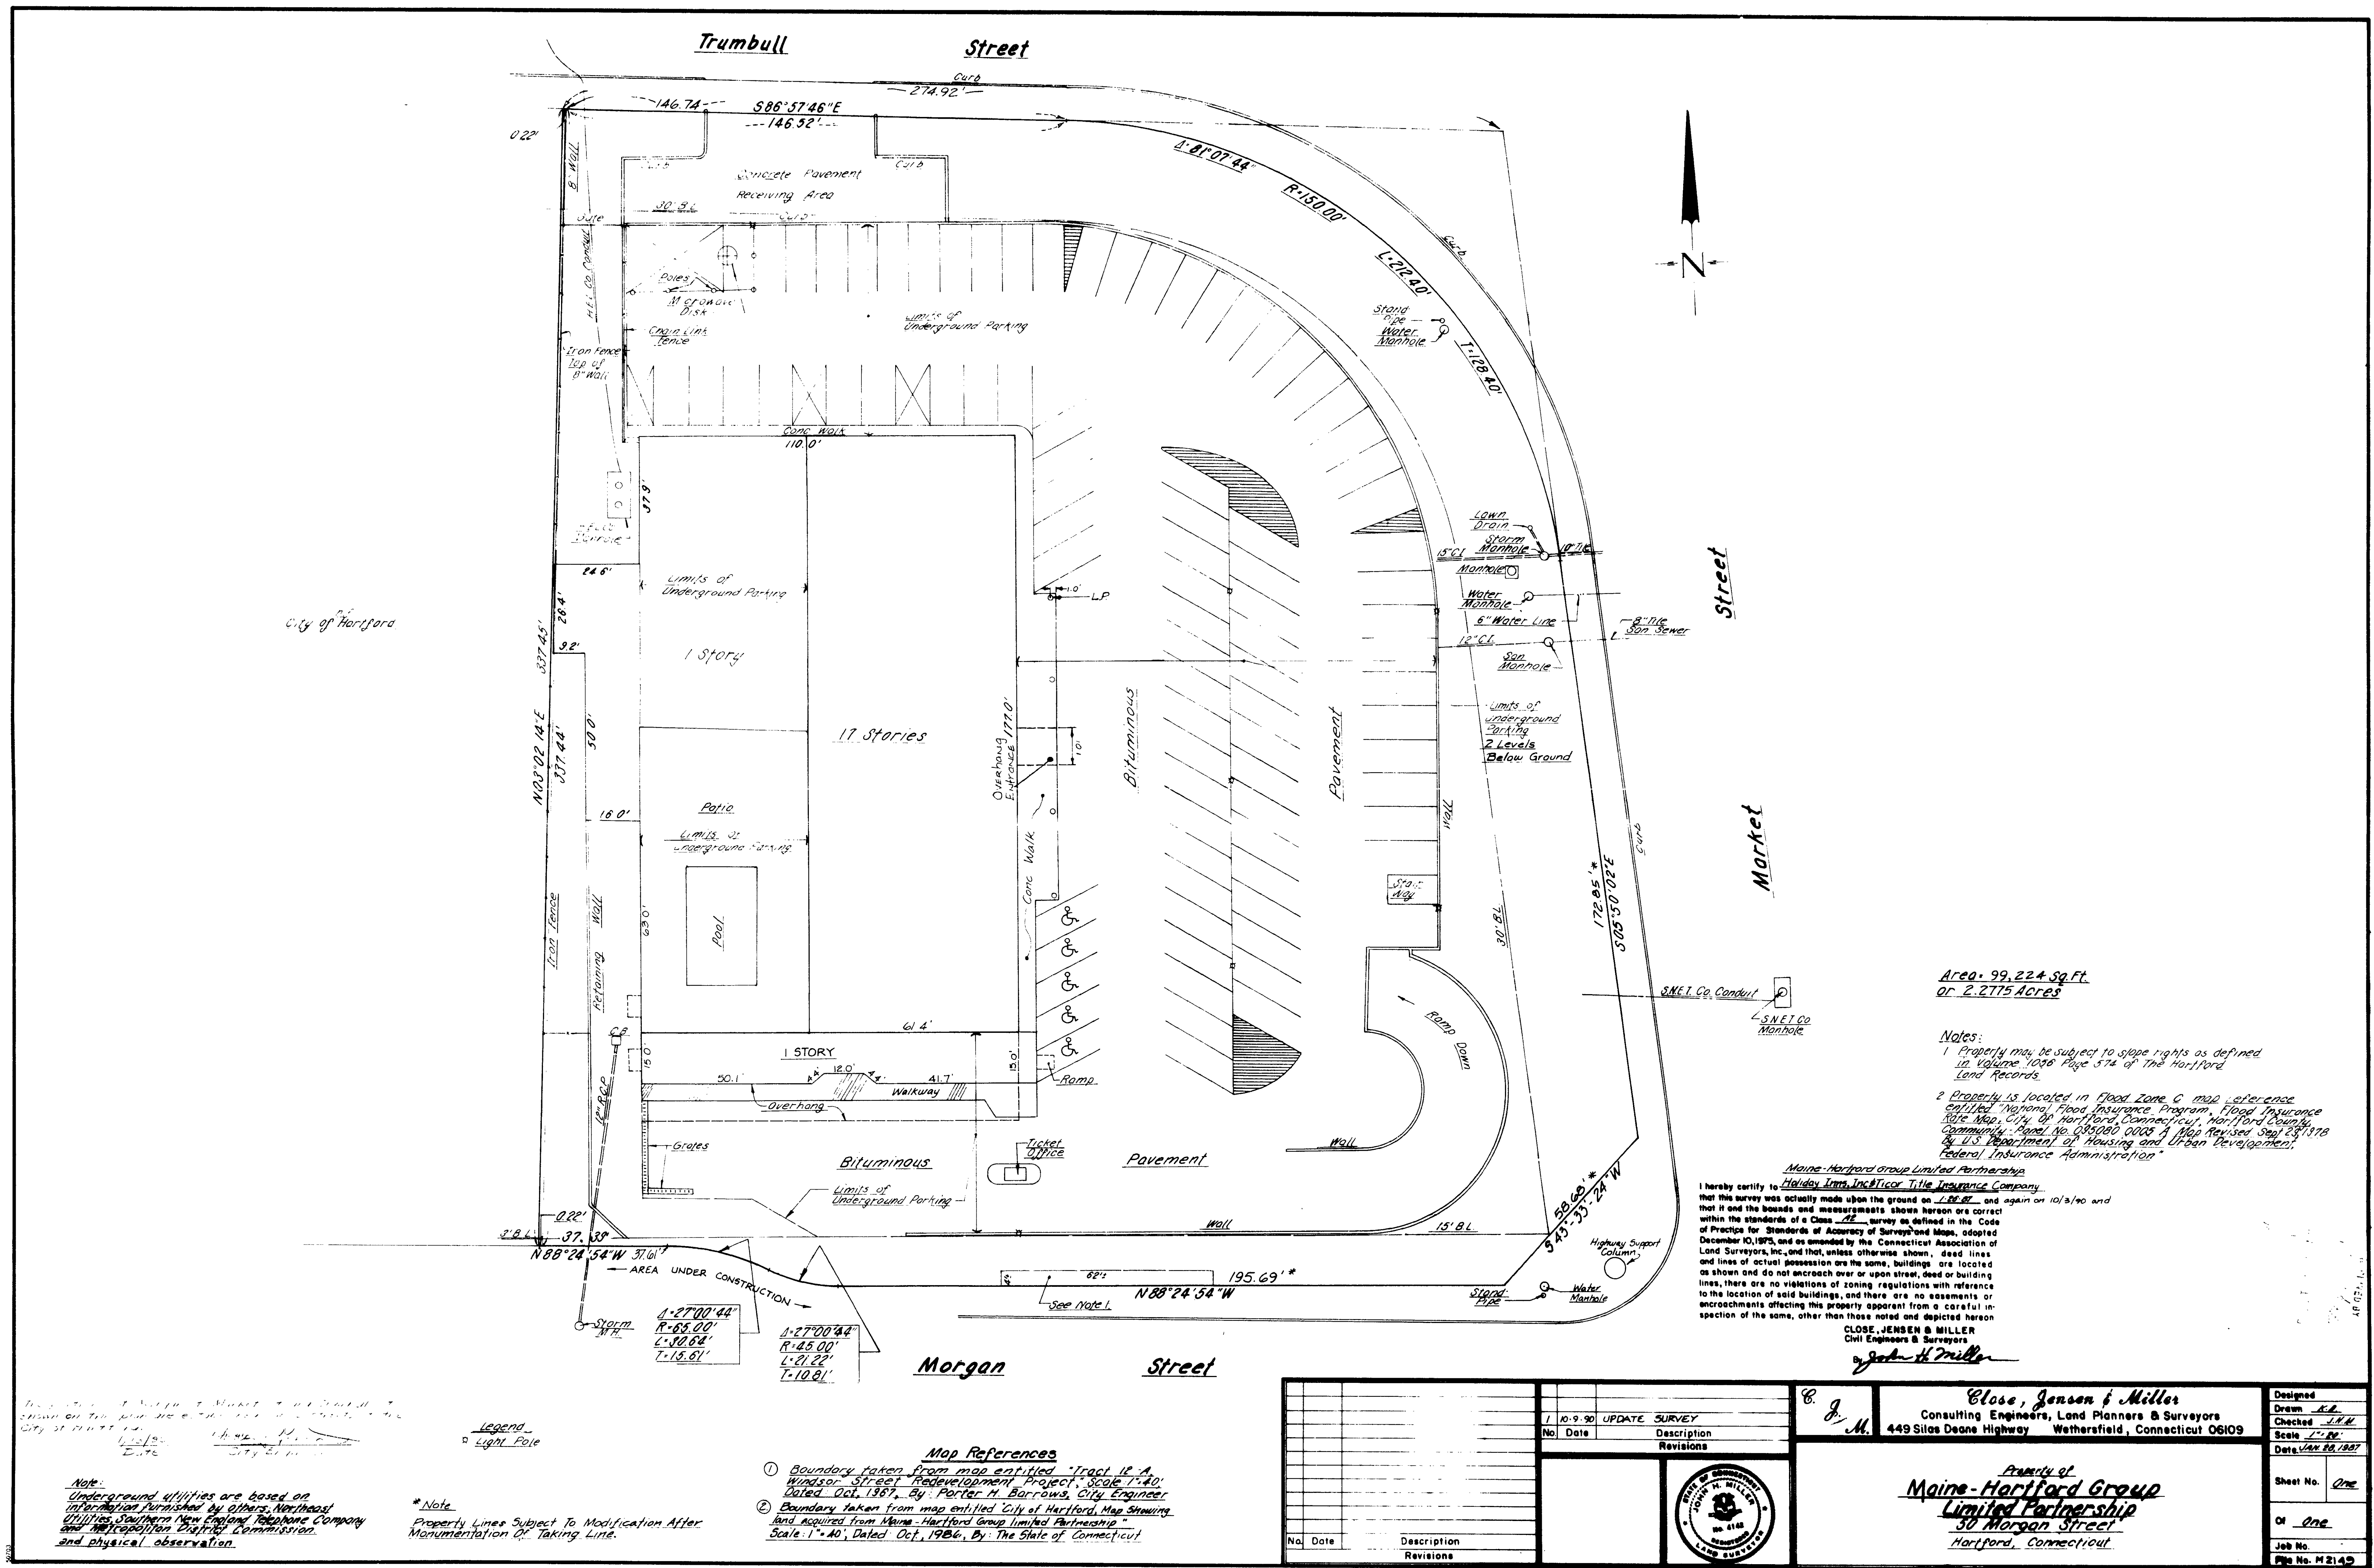

1956	