


9961	9961

N/F
LUCILLE E. GREEN

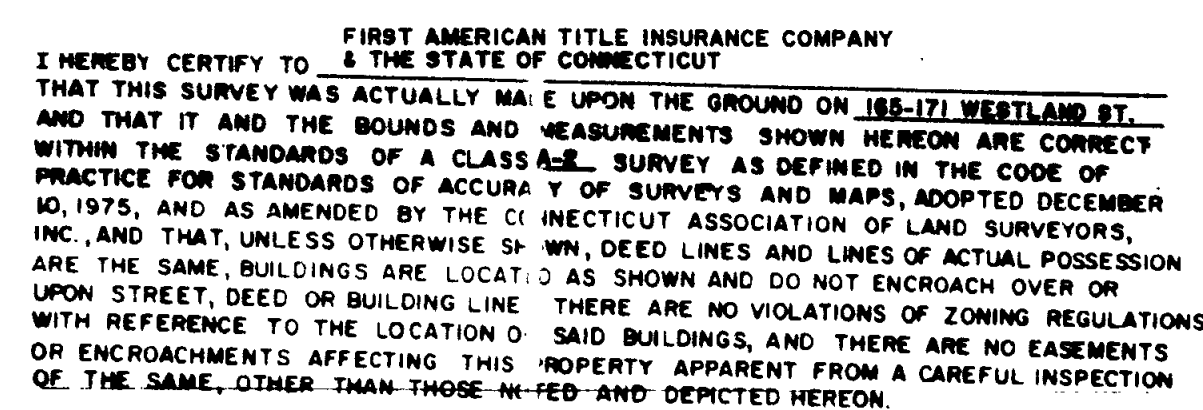

2/26/91
Date

Anthony Greco
City Engineer

SCALE 1"=10' NOV. 1989
Rev. 2/12/81

ZONE R-3

DAVIS SURVEYING & ENGINEERING, INC.-SIMSBURY, CONN.

1966

