


1968

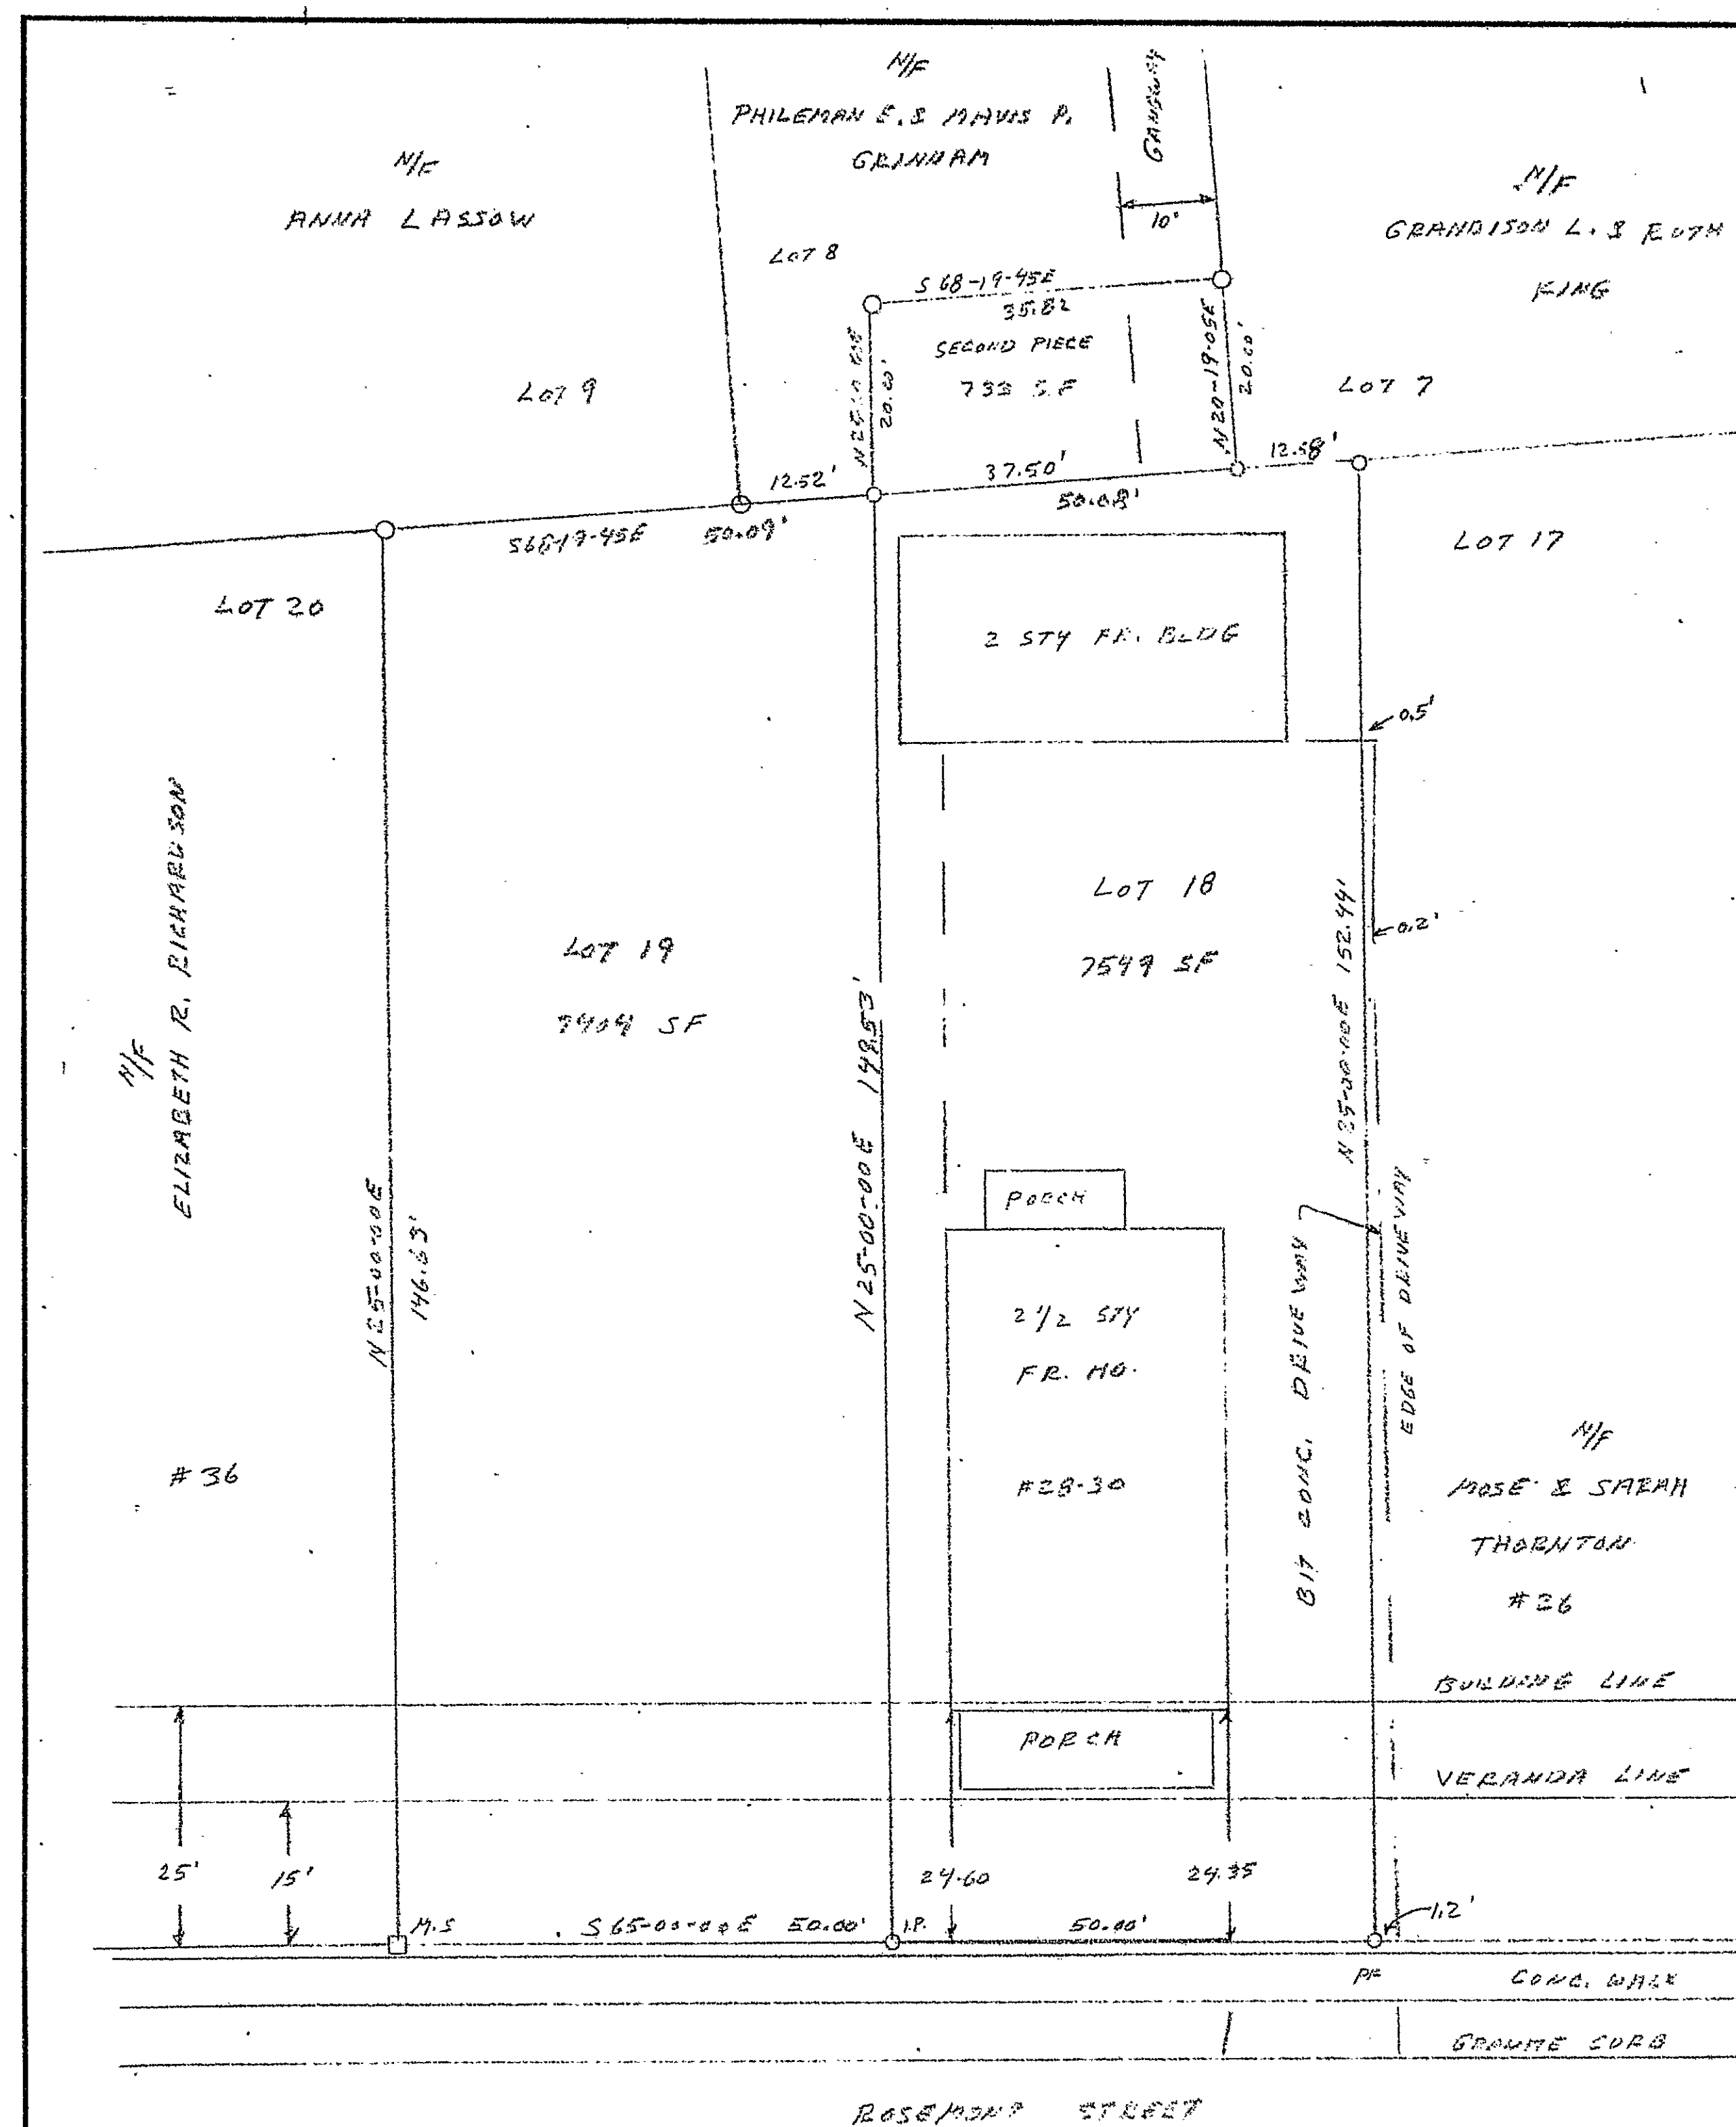

CREST INC

RECEIVED BY
100-100000
Mar 10 3 21 PM '93
TOWN
VOL

B 54 P 42

2 ONE R-5

The portion of Rosemont St. shown on this plan is an established public street of the City of Hartford.

4/16/91
Date

Anthony Gennaro
City Engineer

REVISED FEB. 14, 1989

REFERENCE

Sub-division, "Colonial Gardens," dated May, 1915, received by the City Clerk July 22, 1915, and on file with the City Clerk, for lots on Rosemont Street

Sub-division, "Property of Ernest C. Halliday," dated June, 1914, and on file with the City Clerk, for Lots 7, 8, and 9 on Ashford Street

FIRM Map #095080, Panel #0005-B 12-4-86

This property is not located in a flood hazard zone.

I HEREBY DECLARE THAT THIS MAP IS SUBSTANTIALLY CORRECT. THIS MAP AND THE SURVEY WERE PREPARED IN ACCORDANCE WITH THE STANDARDS OF A CLASS A-2 SURVEY AS DEFINED IN THE "RECOMMENDED STANDARDS FOR SURVEYS AND MAPS IN THE STATE OF CONNECTICUT" AS PREPARED AND ADOPTED BY THE CONNECTICUT ASSOCIATION OF LAND SURVEYORS, INC., ON SEPTEMBER 13, 1984 AND EFFECTIVE JANUARY 1, 1987.

SURVEYOR'S SIGNATURE	DATE	LICENSE NUMBER
<i>M. Gordon Hensley</i>	2-9-89	4654

PROPERTY OF:

CLIVE M. BATCHELOR & CARMEN A. BATCHELOR

SCALE: 1 1/2" = 1'-0"

DATE: FEB. 9, 1989

VEYED BY:

MALCOLM HINCKLEY

DRAWN BY: *Am. H.*

PELS 4654

PLAN SHOWING LOCATION OF BUILDINGS & DRIVEWAY


VOL.	1294	1175
------	------	------

PAGE 241 675

1968

148

