The portion of Morris Street shown on this map is an established city street.

7/19/91 — DATE

Anthony Pascarella — CITY ENGINEER

NOTE: PARCEL AREA = 6397 SQ. FT.

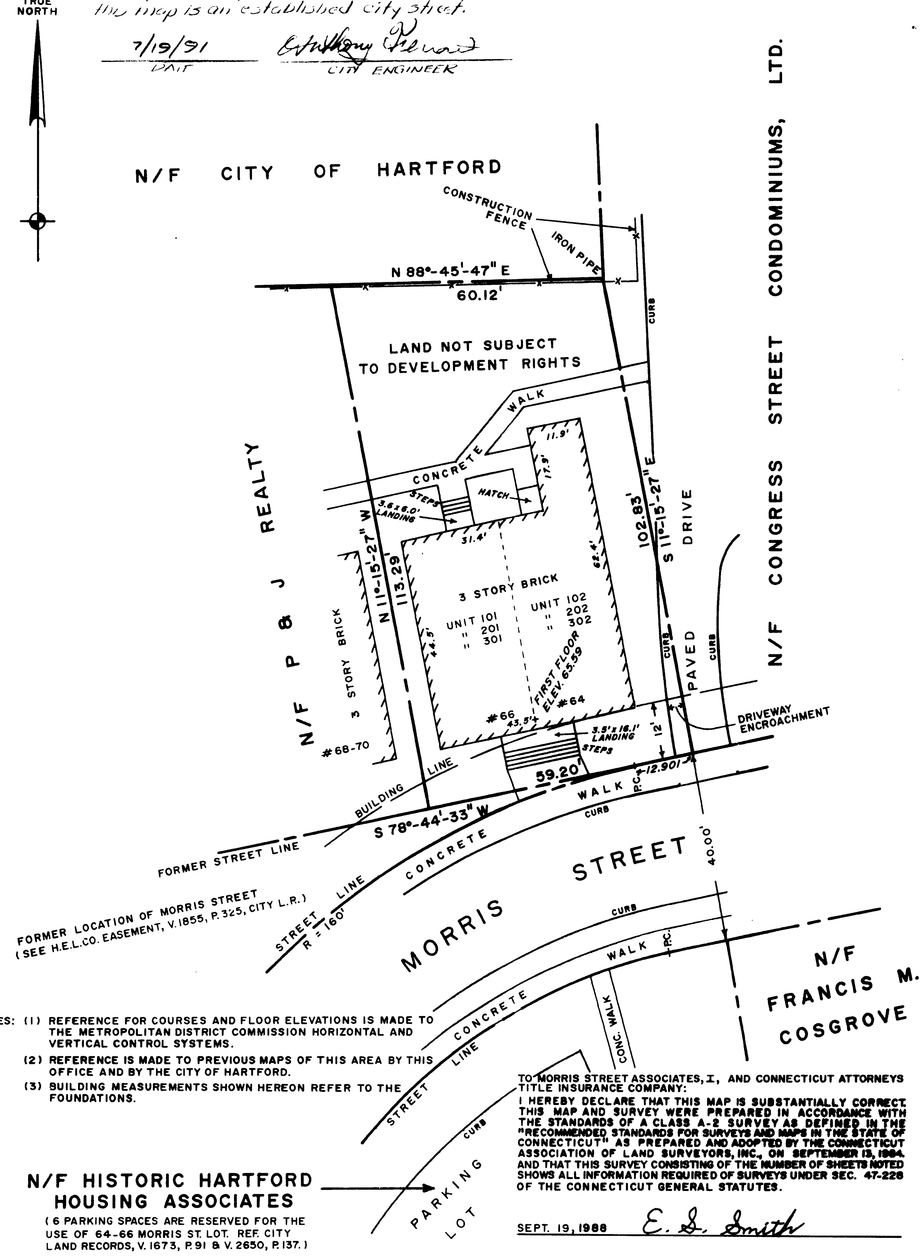

NOTES: (1) REFERENCE FOR COURSES AND FLOOR ELEVATIONS IS MADE TO THE METROPOLITAN DISTRICT COMMISSION HORIZONTAL AND VERTICAL CONTROL SYSTEMS.

(2) REFERENCE IS MADE TO PREVIOUS MAPS OF THIS AREA BY THIS OFFICE AND BY THE CITY OF HARTFORD.

(3) BUILDING MEASUREMENTS SHOWN HEREON REFER TO THE FOUNDATIONS.

N/F HISTORIC HARTFORD HOUSING ASSOCIATES

(6 PARKING SPACES ARE RESERVED FOR THE USE OF 64-66 MORRIS ST. LOT. REF. CITY LAND RECORDS, V. 1673, P. 91 & V. 2650, P. 137.)

TO MORRIS STREET ASSOCIATES, I, AND CONNECTICUT ATTORNEYS TITLE INSURANCE COMPANY:

I HEREBY DECLARE THAT THIS MAP IS SUBSTANTIALLY CORRECT. THIS MAP AND SURVEY WERE PREPARED IN ACCORDANCE WITH THE STANDARDS OF A CLASS A-2 SURVEY AS DEFINED IN THE "RECOMMENDED STANDARDS FOR SURVEYS AND MAPS IN THE STATE OF CONNECTICUT" AS PREPARED AND ADOPTED BY THE CONNECTICUT ASSOCIATION OF LAND SURVEYORS, INC., ON SEPTEMBER 13, 1984, AND THAT THIS SURVEY CONSISTING OF THE NUMBER OF SHEETS NOTED SHOWS ALL INFORMATION REQUIRED OF SURVEYS UNDER SEC. 47-228 OF THE CONNECTICUT GENERAL STATUTES.

SEPT. 19, 1988 — E. S. Smith

STATE OF CONNECTICUT — E S SMITH — No 13644 — LICENSED LAND SURVEYOR

THE PATRICK HENRY — A CONDOMINIUM

DECLARANT: MORRIS STREET ASSOCIATES, I

64-66 MORRIS STREET
HARTFORD, CONNECTICUT

SCALE: 1 INCH = 20 FEET — SHEET 1 OF 1 — SEPT., 1988

0' 5' 10' 15' 20'

MAP PREPARED BY

PETERSEN & HOFFMAN - LAND SURVEYORS
1000 FARMINGTON AVENUE, WEST HARTFORD, CONN. 06107

N.B. 6111-56 F.B. 42-114

EASI FILE CORP. IRVINE CA. EFN 34

983

983

(3)