


PROPERTY OF
JOE K. MENSAB
53 - 55 LIBERTY STREET
HARTFORD
CONNECTICUT
AUGUST 9, 1991
SCALE: 1" = 20'

LIBERTY STREET

EASI FILE CORP IRVINE CA EPH 34
1996

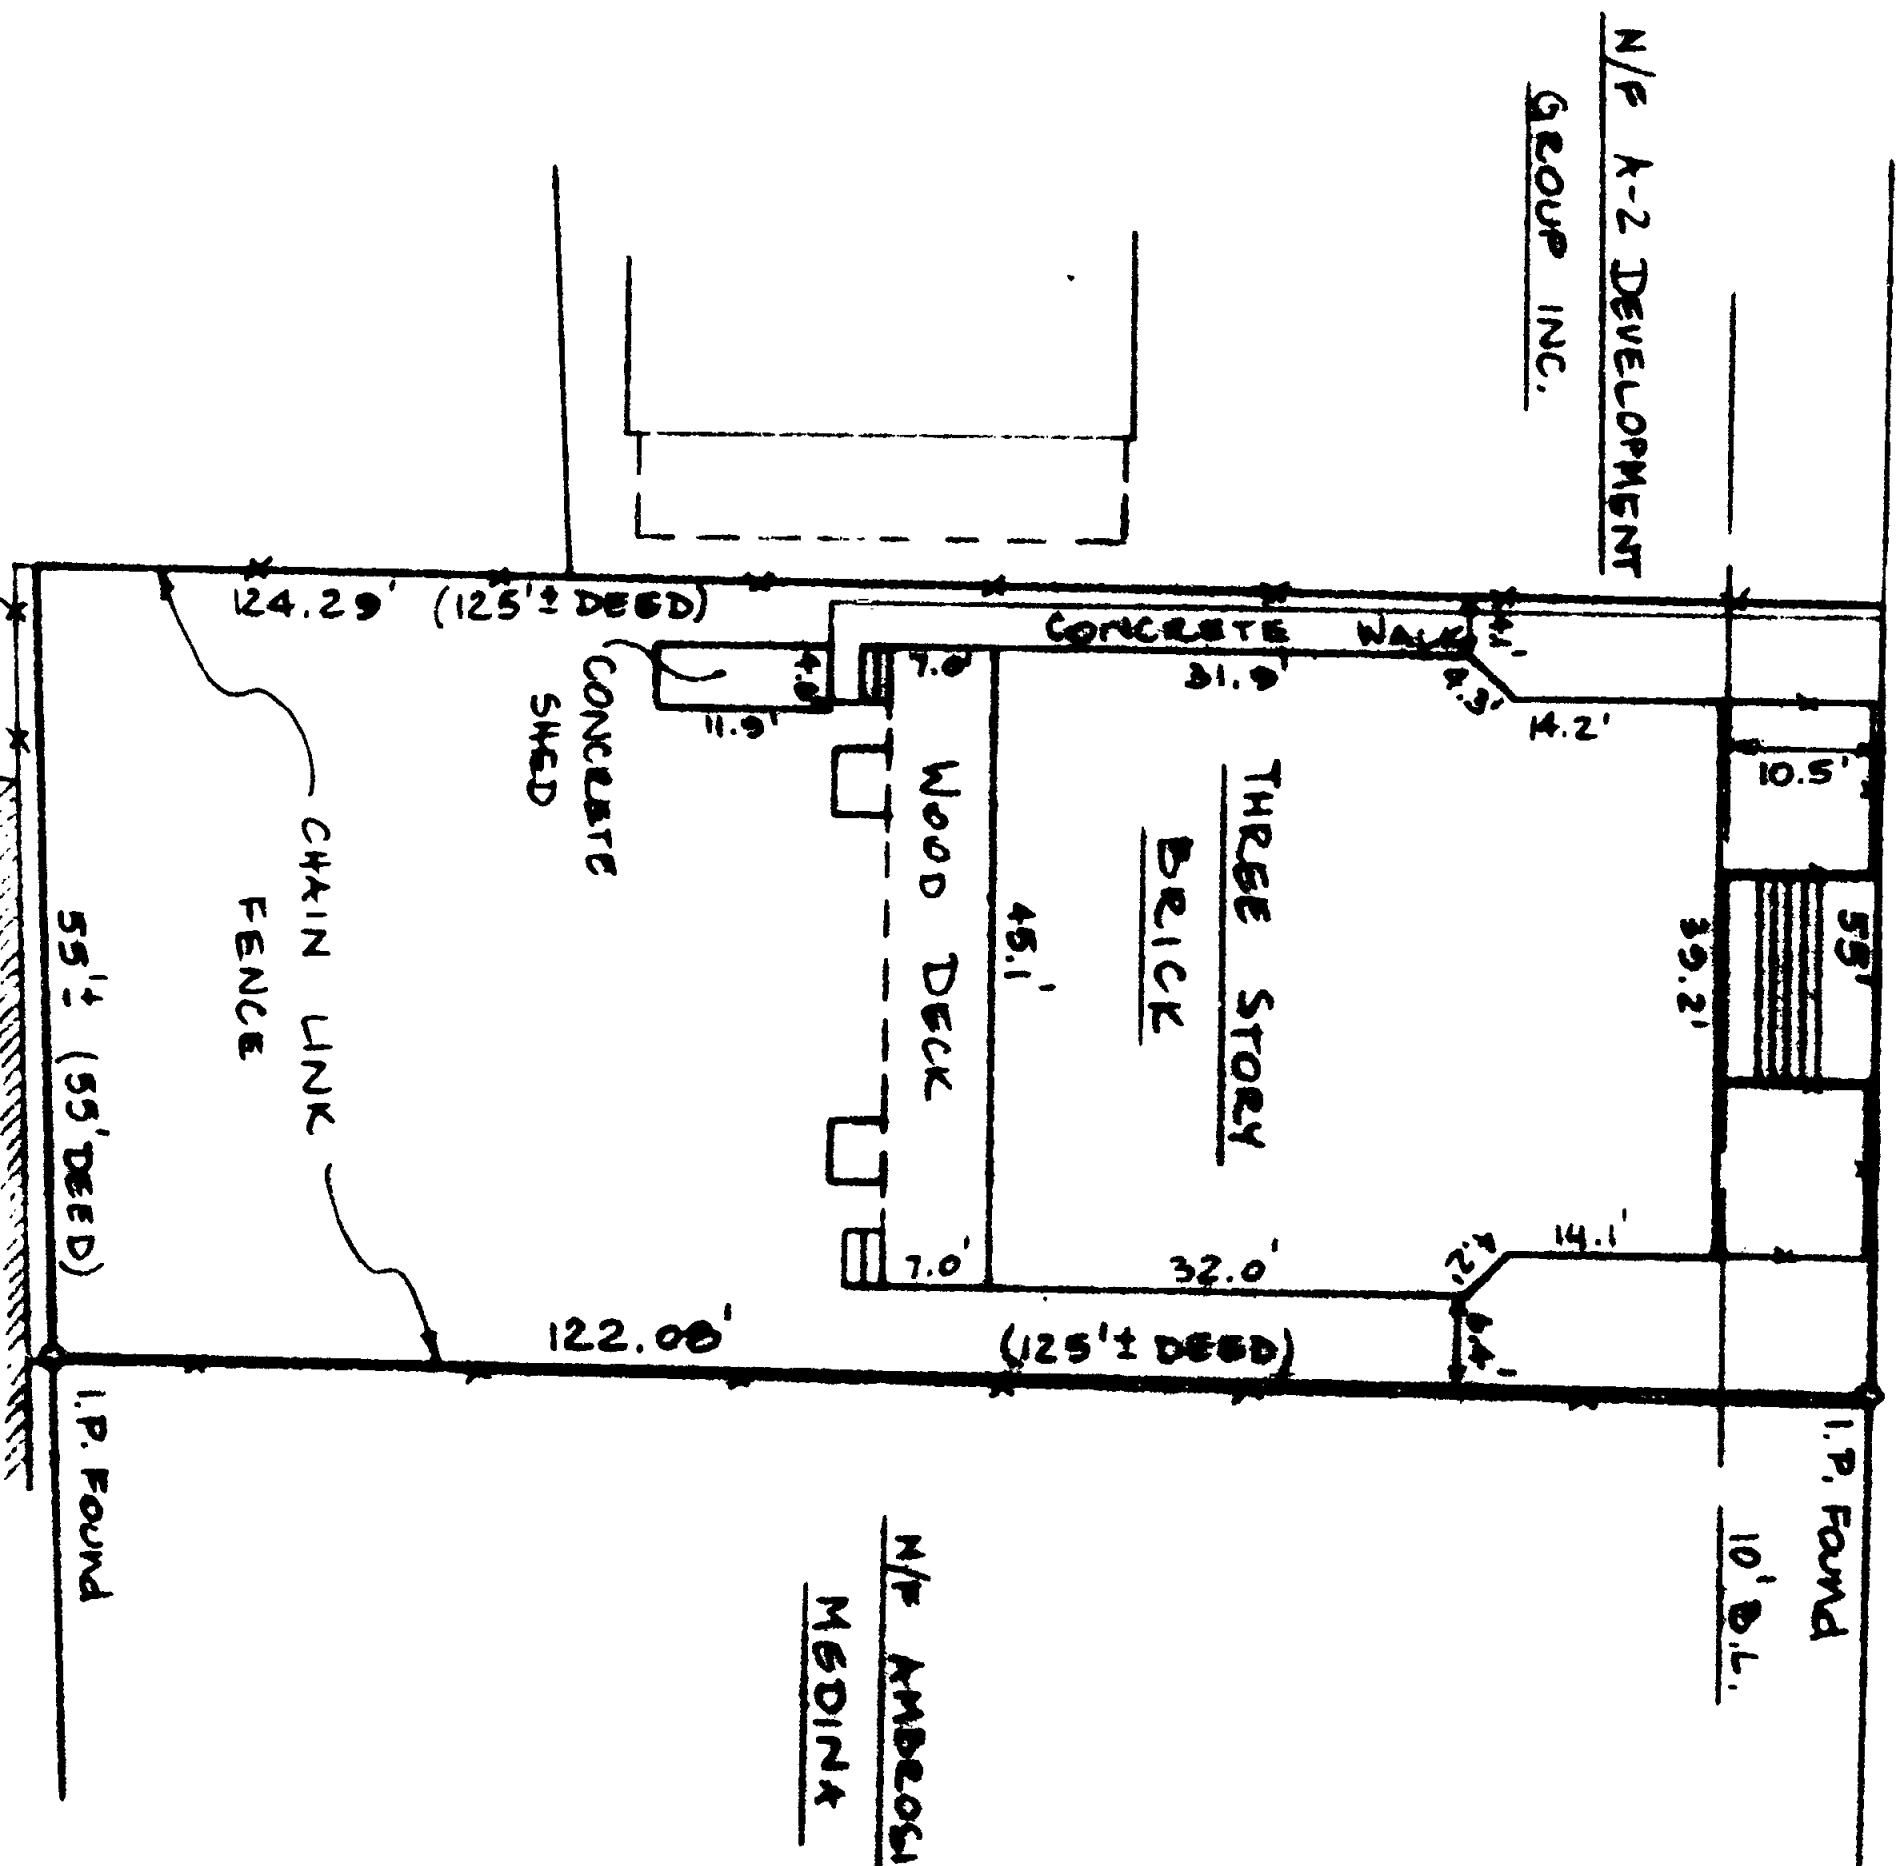

NOTE: Sideyard non-conforming -
Building built prior to
present zoning.

N/E ROBERT W. SPILANE

Peoples Bank, Connecticut
Attorneys Title Insurance
Insuring entry to COMPANY

Joe K. Mensab

that this map, which shows physical conditions existing
at this date, is substantially correct in accordance
with the standards of a CLASS D survey and that
existing regulations are not violated other than those
captioned herein.

CLARE JOHNSON & SULLER
Civil Engineers & Surveyors

by John H. Miller

That portion of Liberty Street shown on
this plan is an established street in
the City of Hartford.
10/21/91
City Engineer



RECEIVED BY
TOWN & CITY CLERK
HARTFORD
Oct 10 1 20 PM '91

1996

16