


FAS FILE CORP IRVINE CA EFM 34
2001

2001

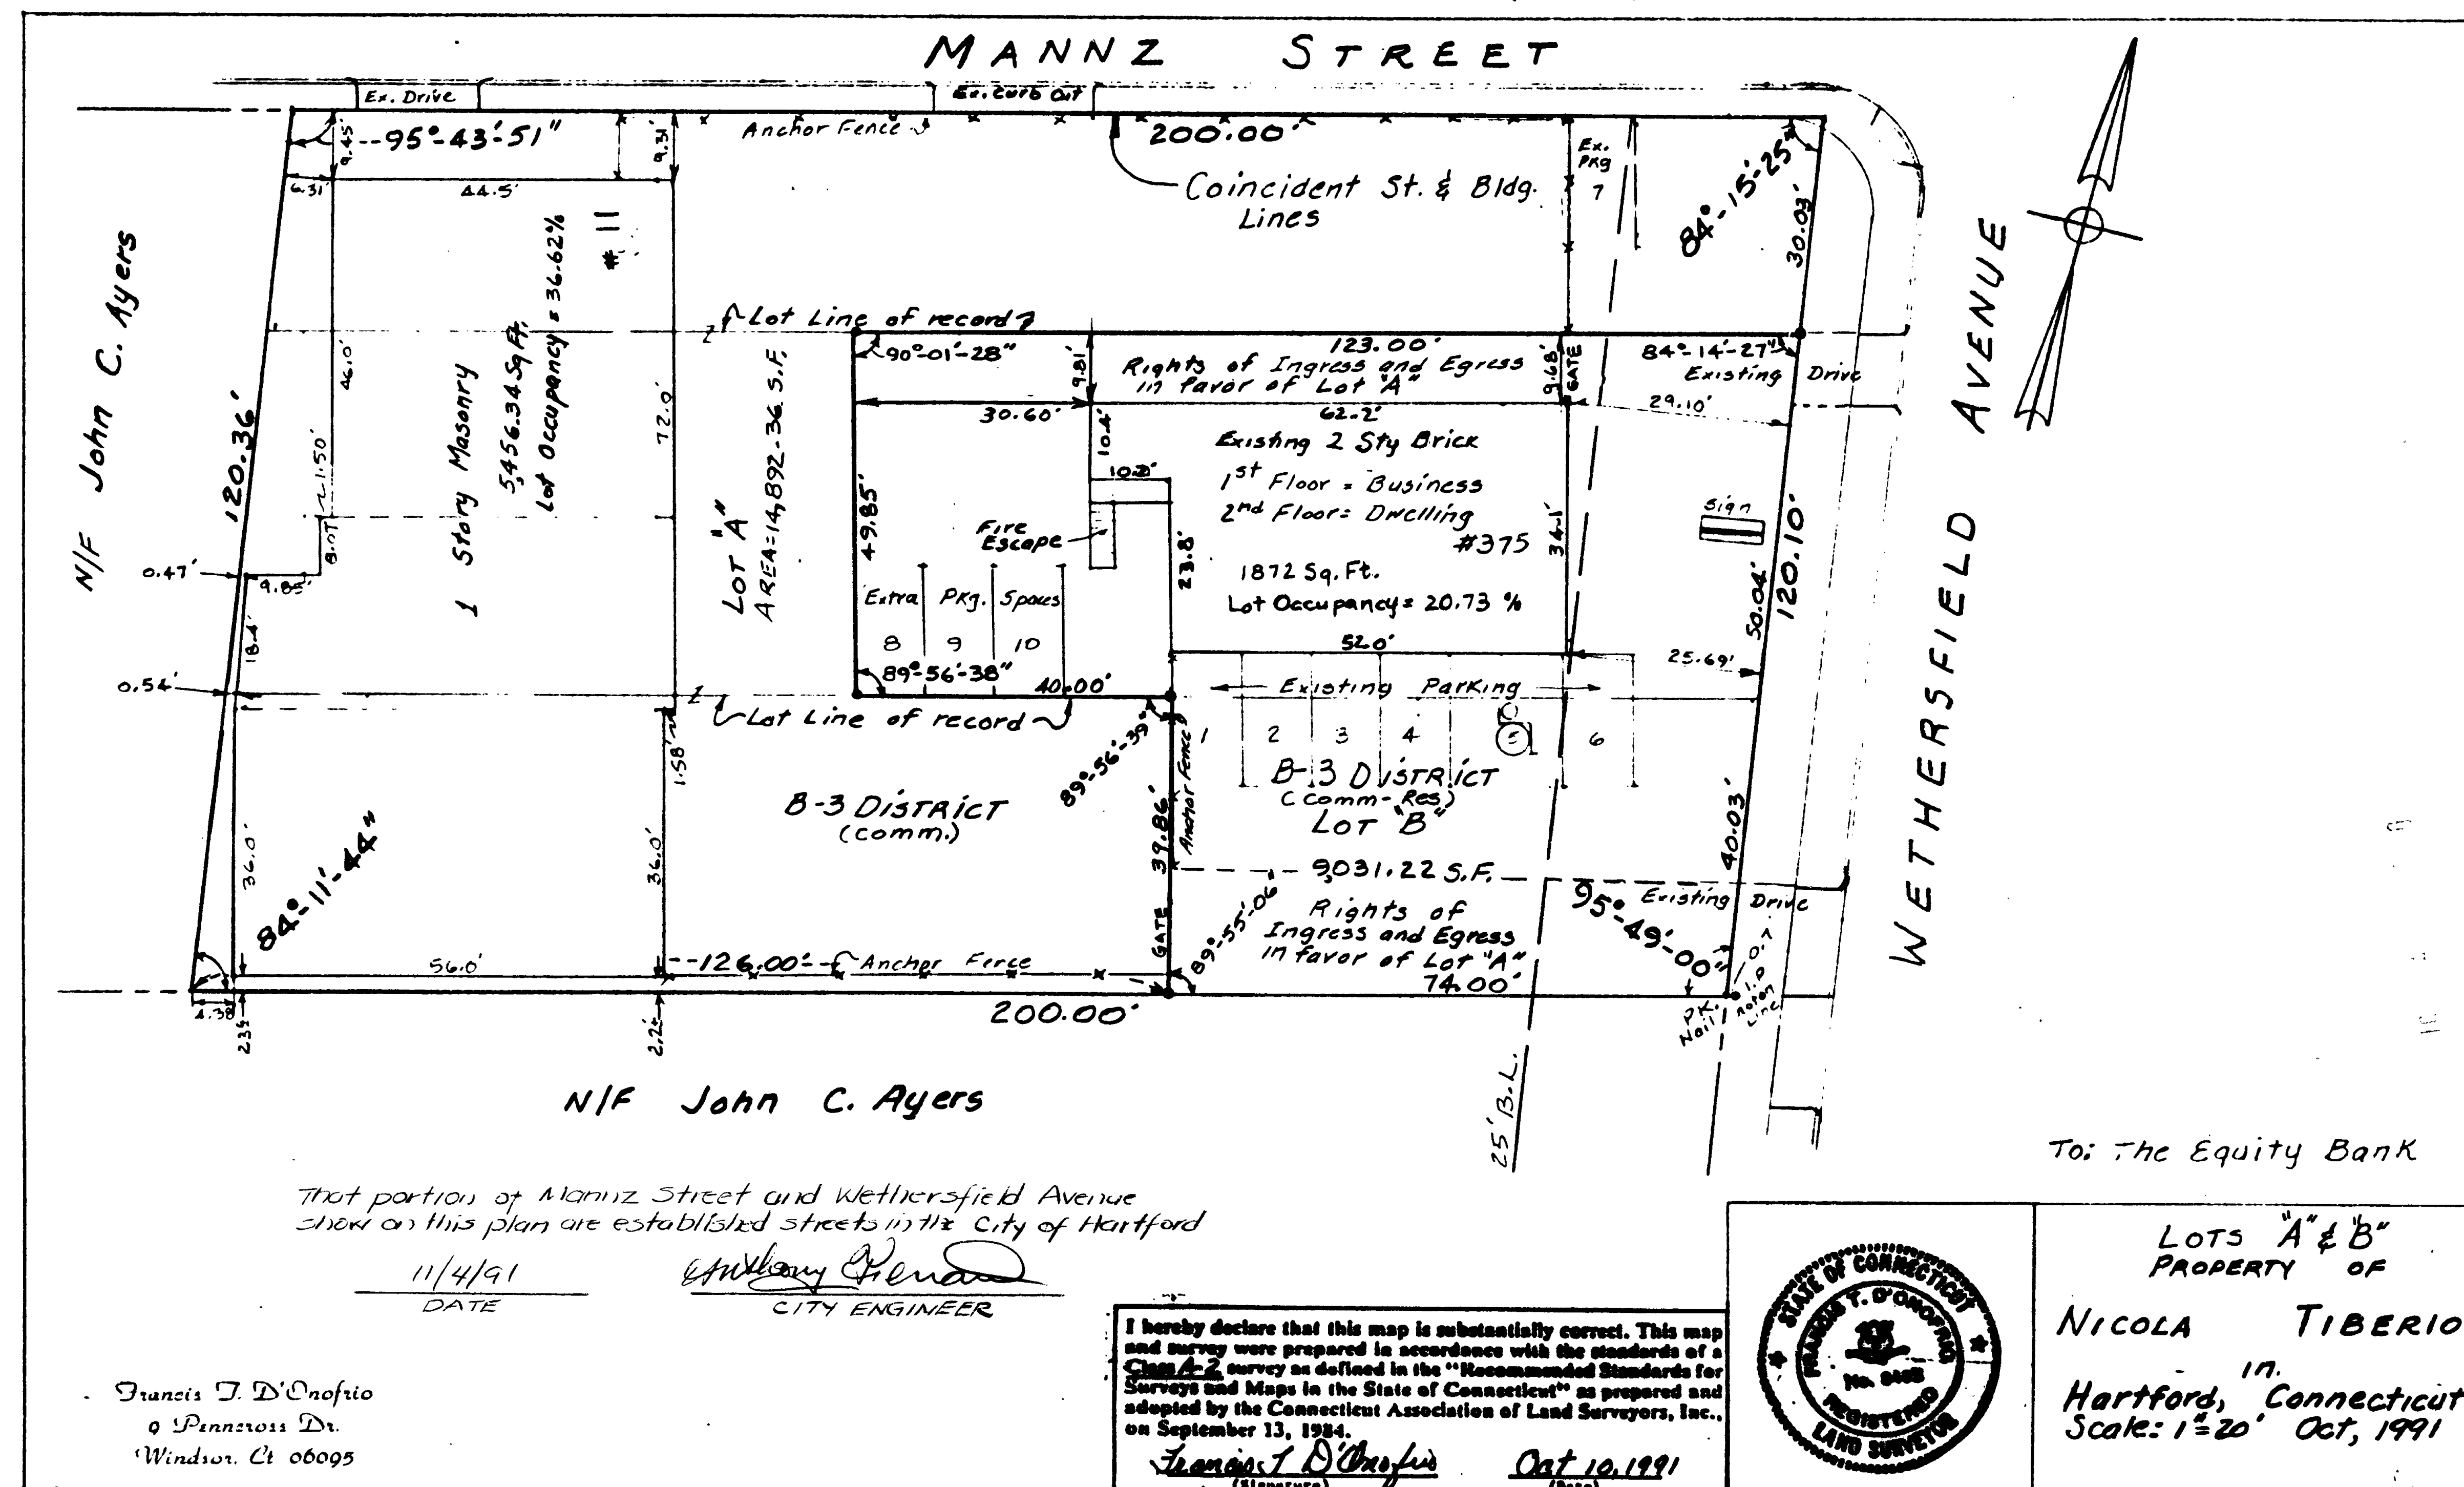

21 2001

