


EAST FILE CORP. IRVINE, CA EFM 34
2005

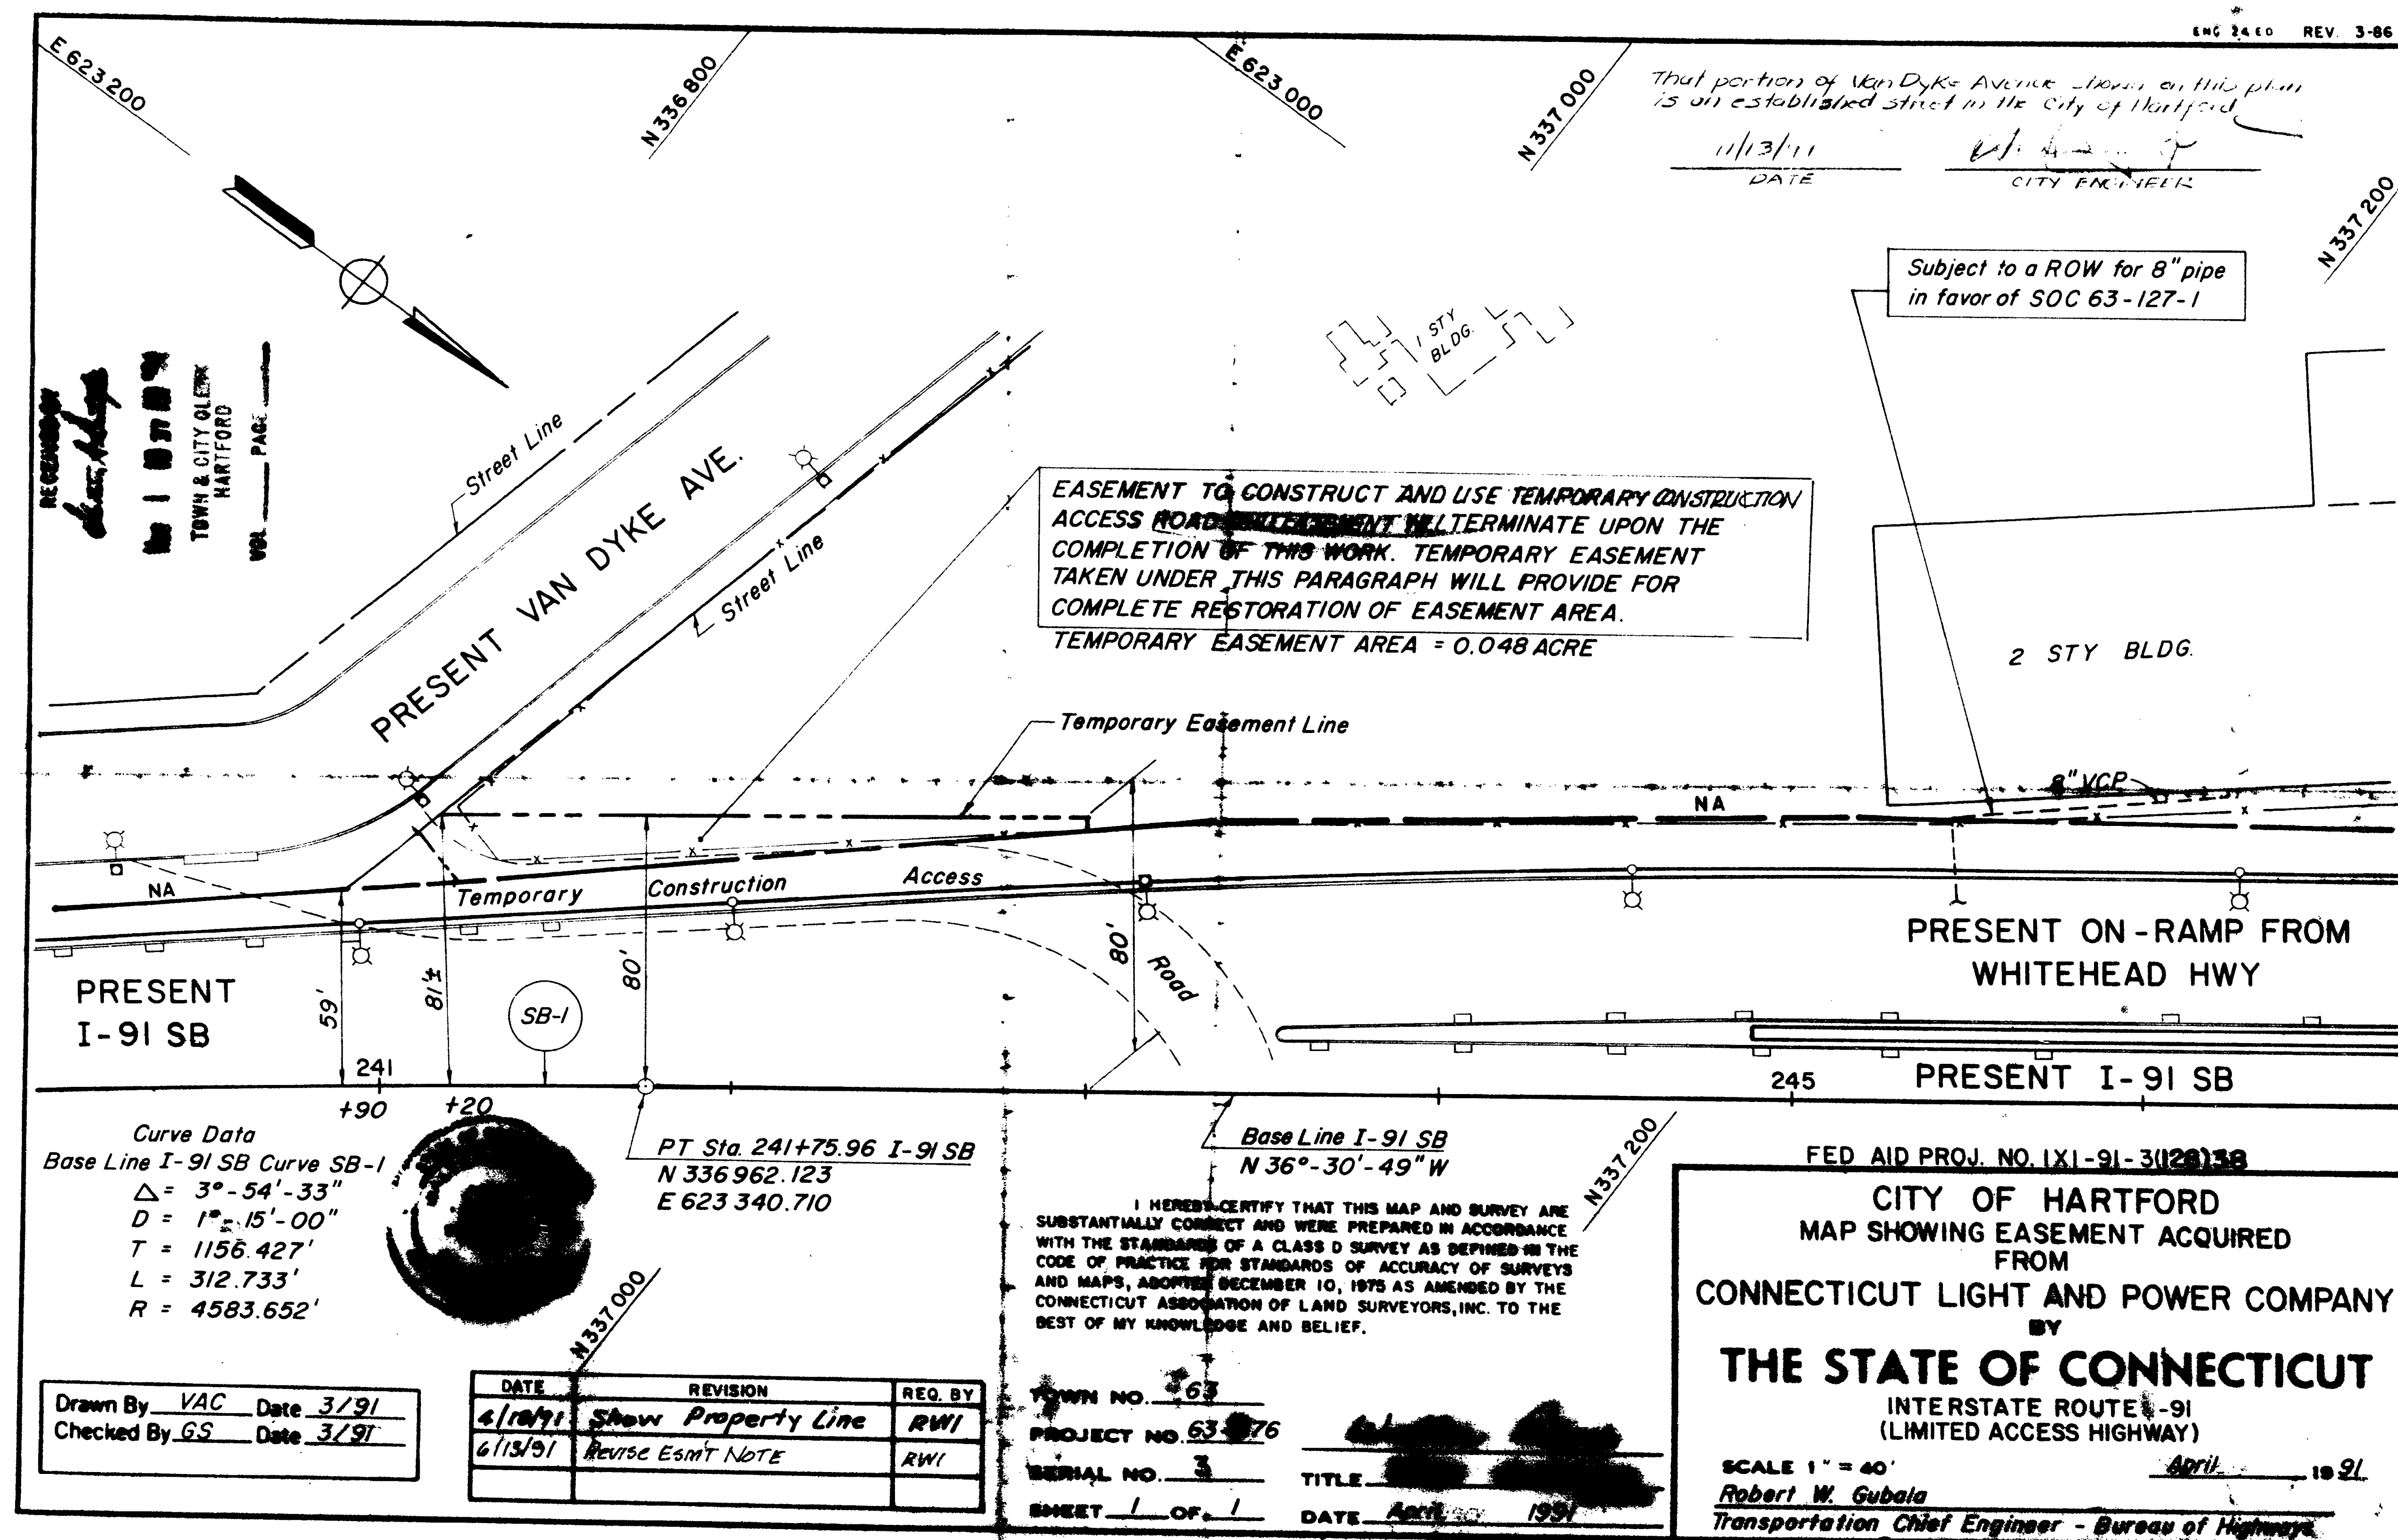

0 INCHES 1 2 3 4