


EASI FILE CORP. IRVINE, CA EFM 34
2041

ENG. 24-10 REV. 10-86

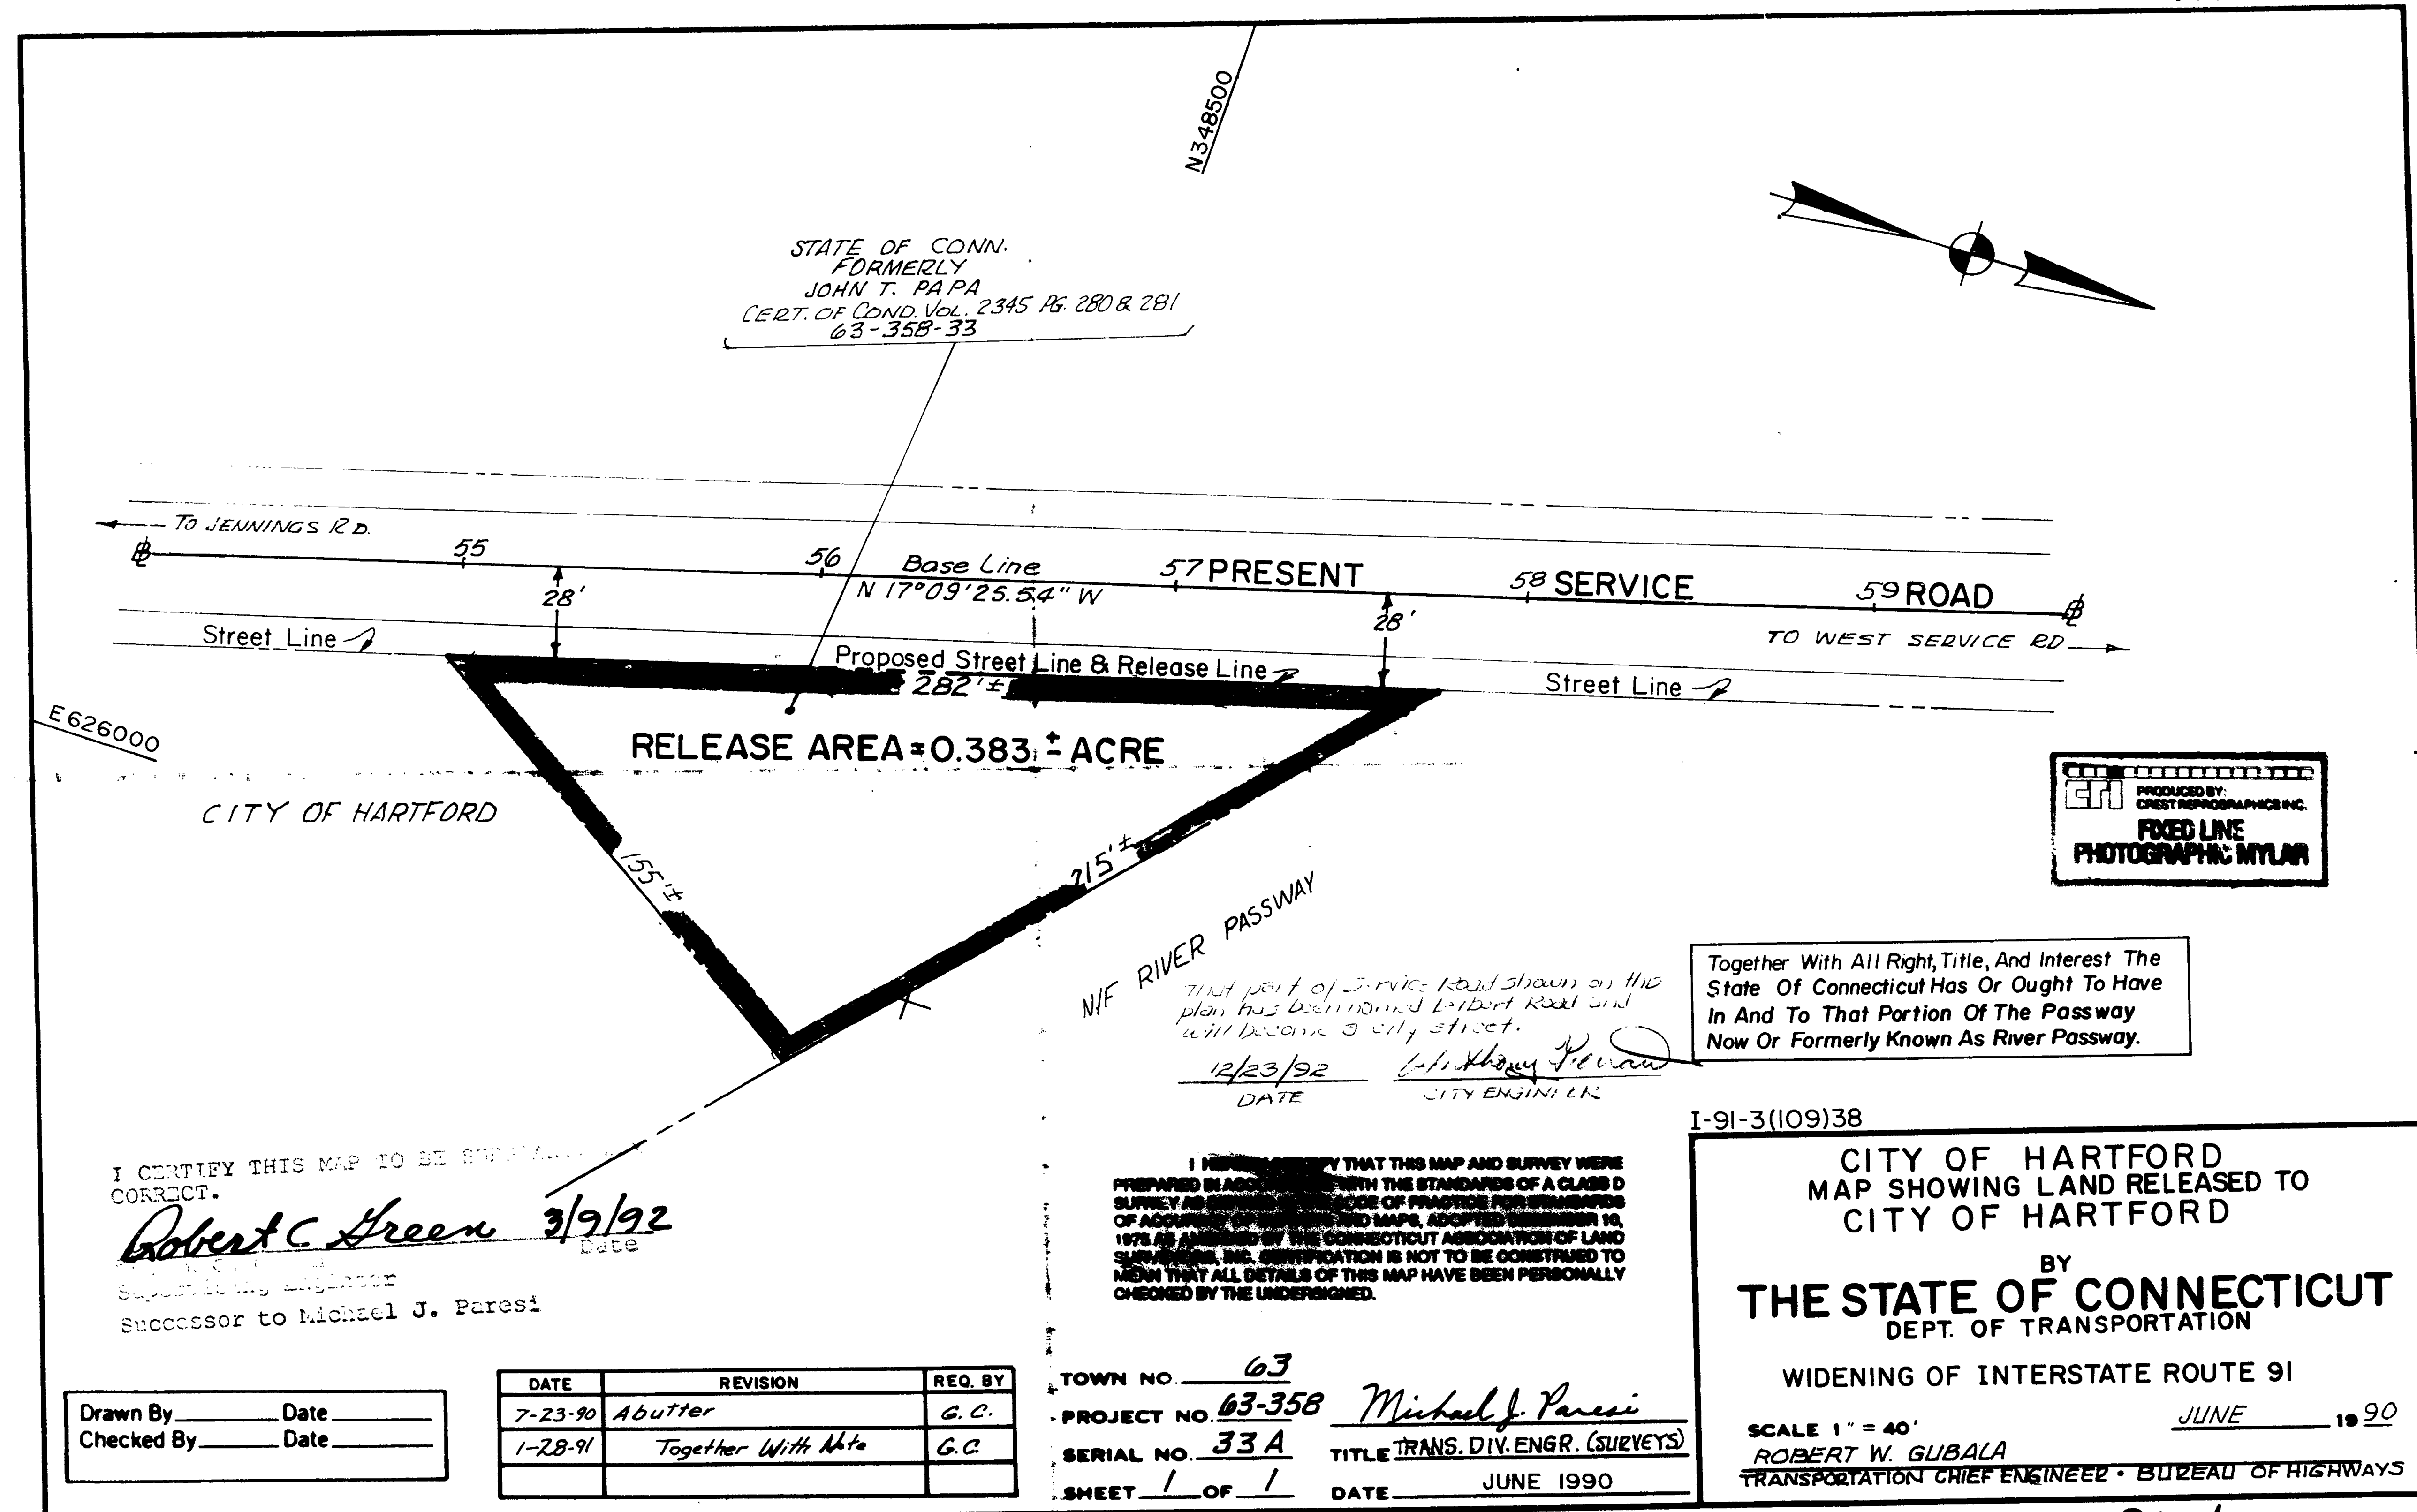

0 INCHES 1 2 3 4

2041

61