


RECEIVED BY
D. J. Casey

JUN 8 2 30 PM '93

TOWN & C. L. B. L. K. HARTFORD

VOL. 1052

KIBBE ST

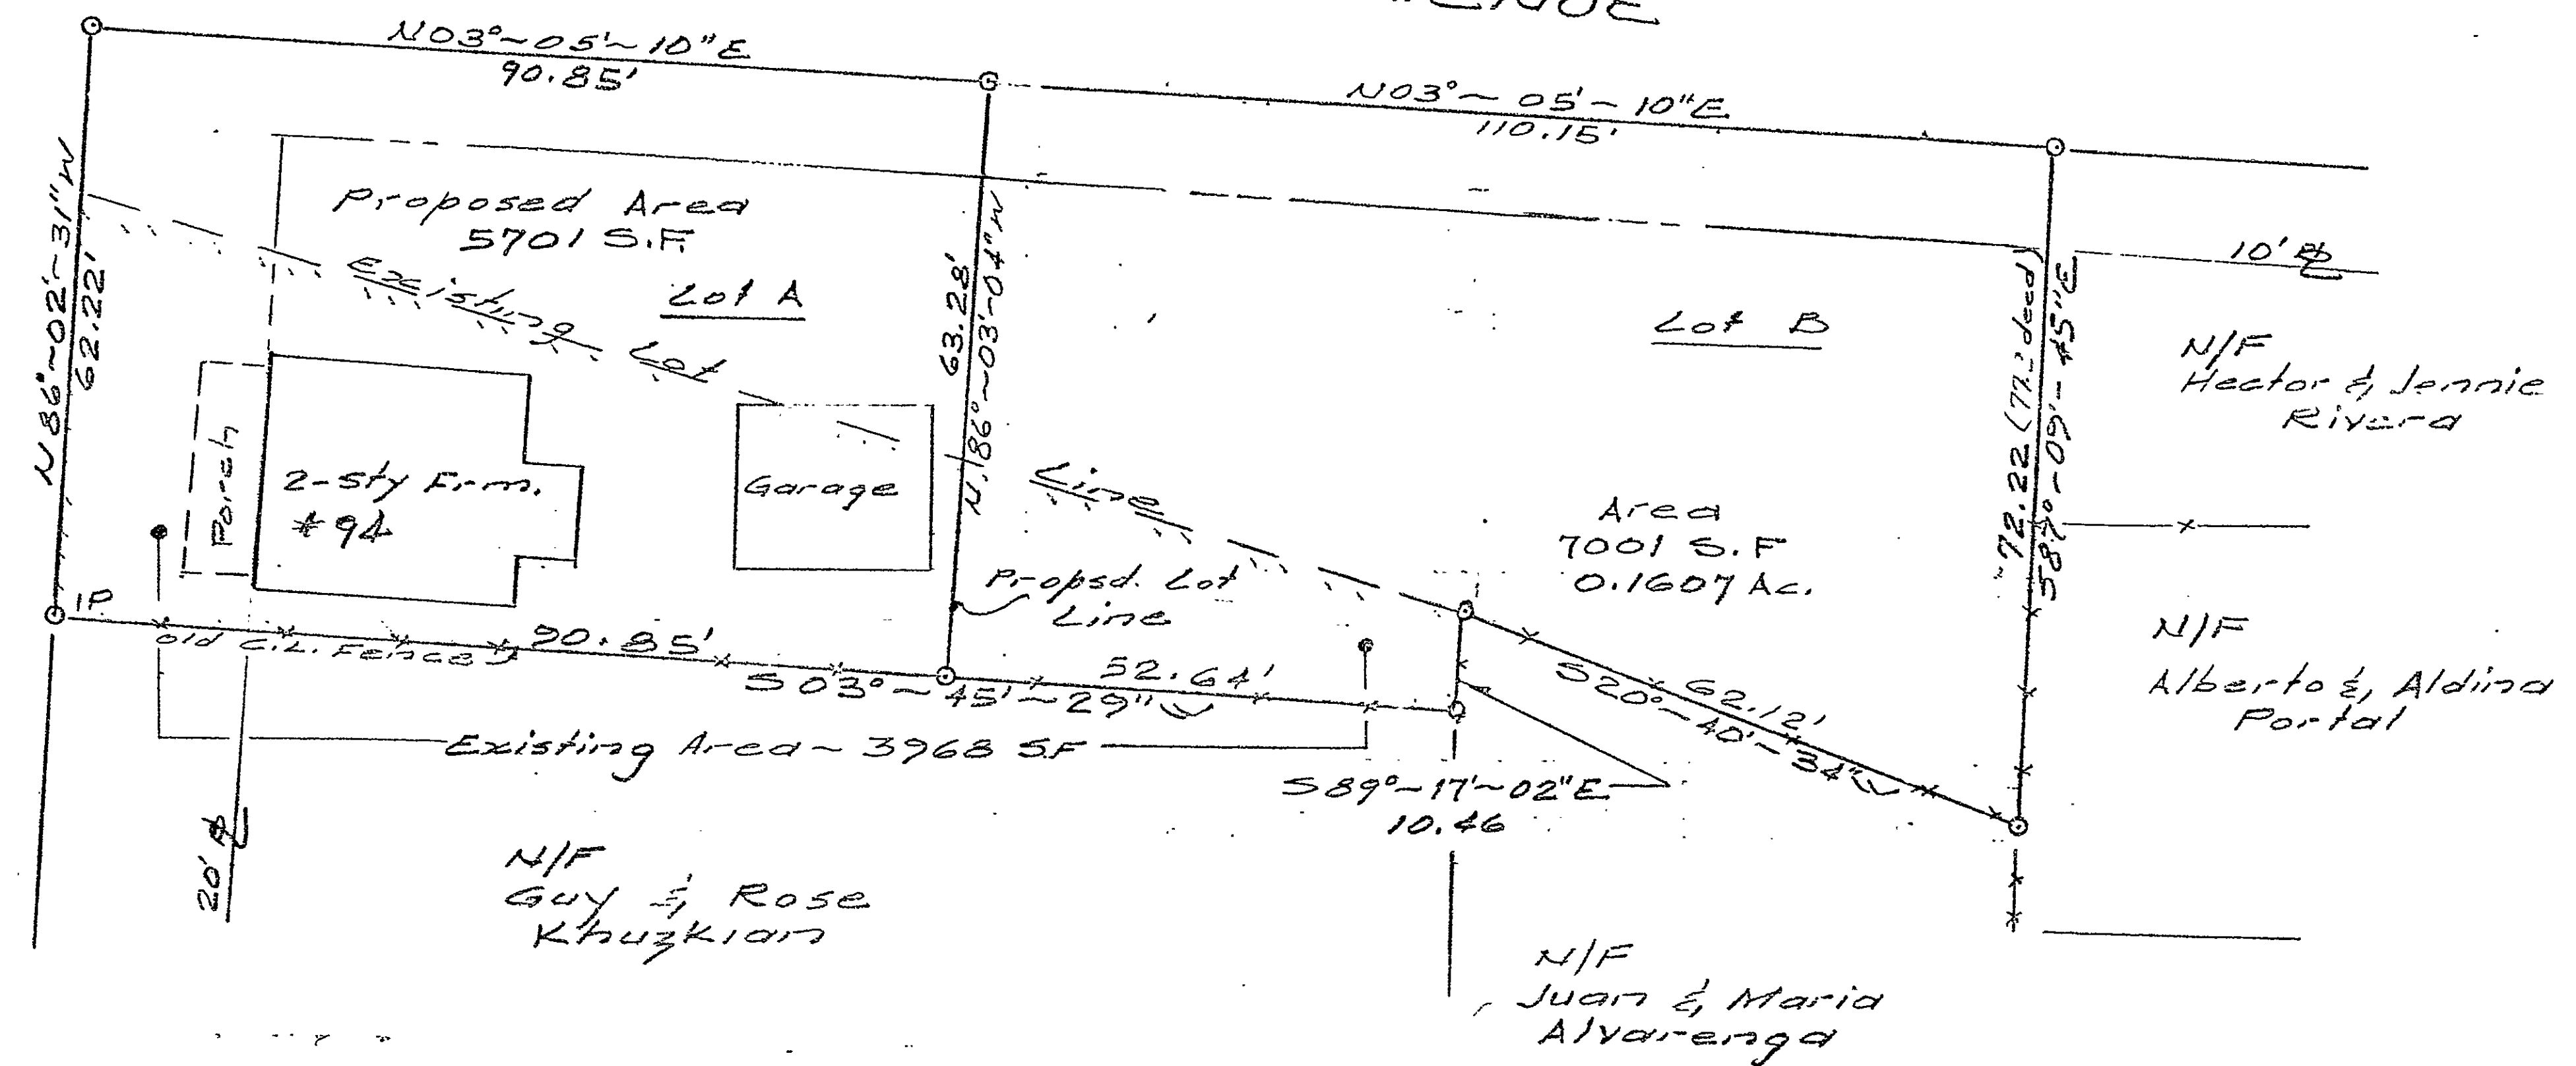

2053

Certified substantially correct
and in conformance with
CLASS A-Z surveys as defined
by C.A.L.F.

PLAN SHOWING
PROPOSED REVISION
TWO LOTS
ON BULKELEY AVENUE
HARTFORD, CONN.
SCALE: 1"=80' DATE: 3-10-92
Property of Jose Pina

