


2056

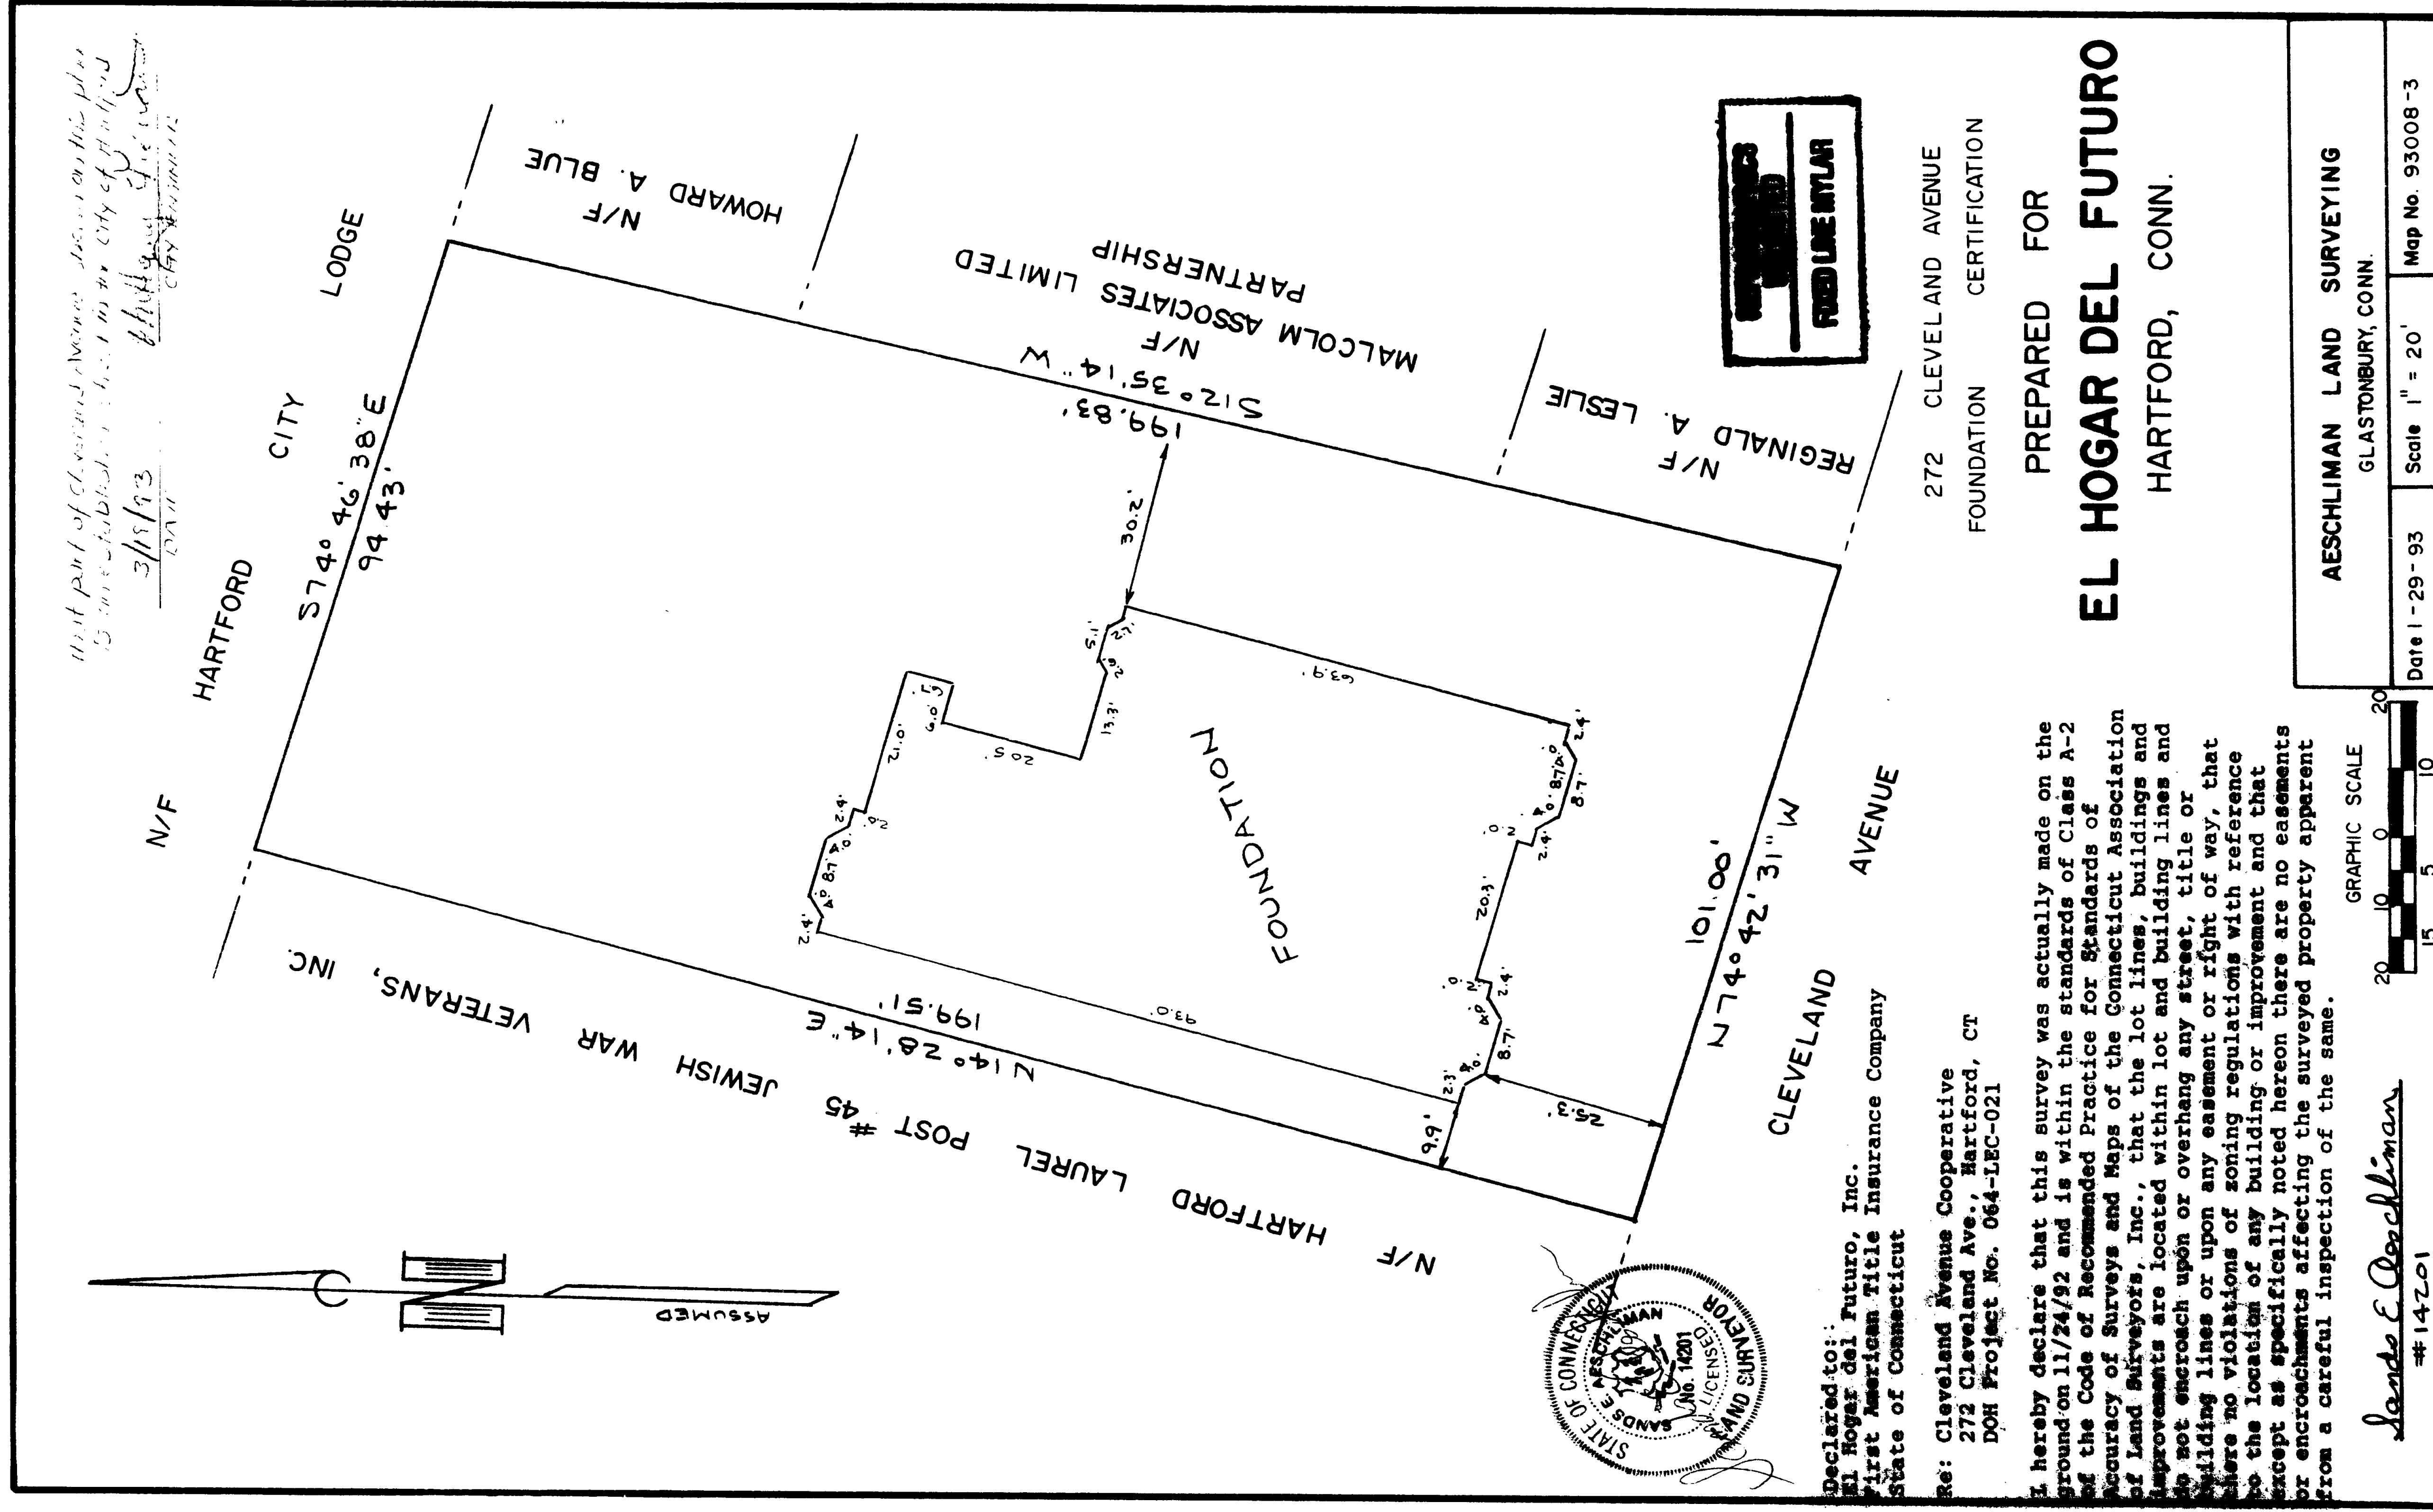

Sando E. Q.
#14201

#14201

GRAPHIC SCALE



Date 1 - 29 - 93

Scale 1" = 20'

Map No. 93008-3

2056

76