


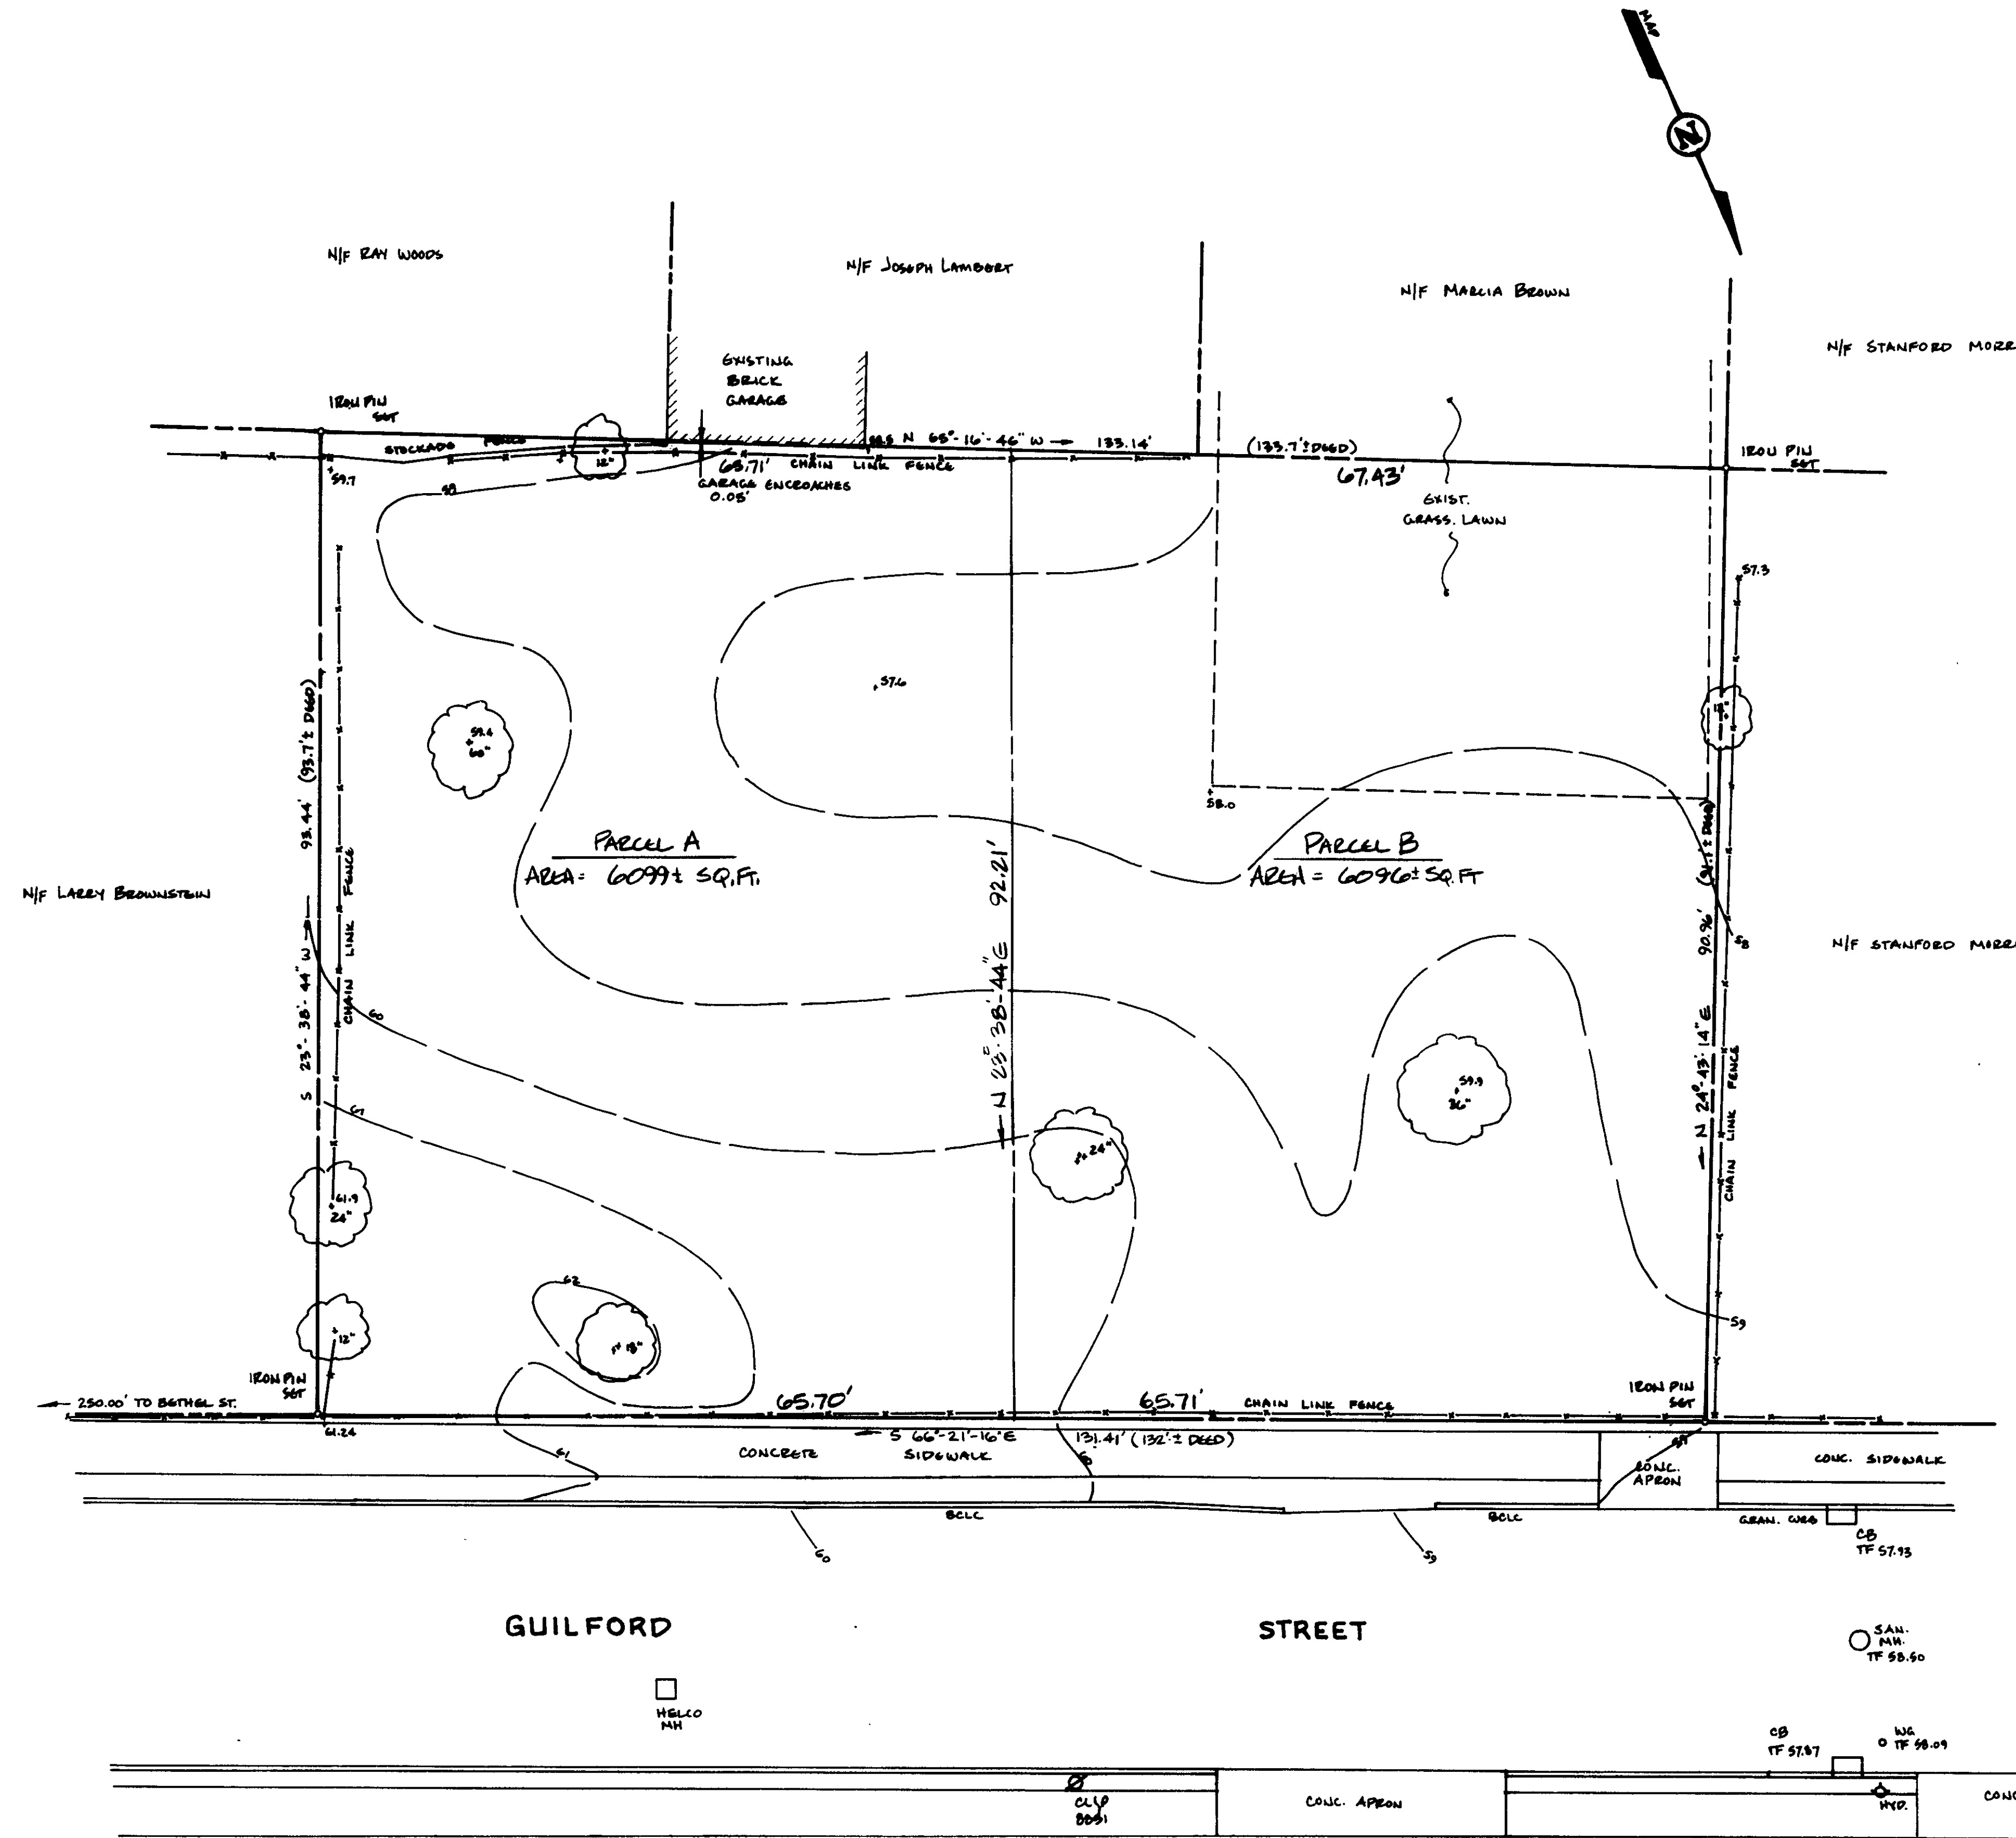

NOTES:  
1. TOPOGRAPHY SHOWN IS FROM AN ACTUAL FIELD SURVEY AND IS BASED ON AN ASSUMED DATUM.



REPROGRAPHIC  
UNLIMITED  
GRID LINE MYLAR

BOUNDARY SURVEY  
PREPARED FOR  
HABITAT FOR HUMANITY  
GUILFORD STREET HARTFORD, CT  
20 JAN 1992 1"=10' 91025

MALINOSKI ASSOCIATES  
5880 OAK DR. ASHFORD, CT 06278

REV. 14 AUG 93 - CREATED PARCELS A & B

REFERENCE MAP

MAP No. 2, OF LOTS OWNED BY WALTER S. MATTHEE.  
HARTFORD CONN. SCALE 50 FEET TO AN INCH  
AUG. 1897.

NO CERTIFICATION IS EXPRESSED OR IMPLIED AN ORIGINAL OR  
ANY DUPLICATE OF THIS MAP UNLESS IT BEARS THE ORIGINAL  
SIGNATURE AND IMPRESSION THE SEAL OF THE SURVEYOR WHOSE  
SIGNATURE APPEARS HEREON.

I HEREBY DECLARE THAT THIS MAP IS SUBSTANTIALLY CORRECT. THIS MAP,  
AND SURVEY WERE PREPARED IN ACCORDANCE WITH THE STANDARDS OF  
A CLASS A-2 SURVEY AS DEFINED IN THE RECOMMENDED STANDARDS FOR  
SURVEYS AND MAPS PREPARED IN THE STATE OF CONNECTICUT AS PREPARED  
AND APPROVED BY THE CONNECTICUT ASSOCIATION OF LAND SURVEYORS INC.  
ON SEPTEMBER 15, 1984. EXCEPT FOR MONUMENTATION.

DAVID A. MALINOSKI JR. #15046

The portion of Guilford Street shown on  
this map is an established public Street  
of the City of Hartford.

By *[Signature]*  
City Map Records/Survey Supervisor

2081