

100

282

The portion of Cleveland Avenue shown on this Plan, is an established public Street of the City of Hartford.

D. Blunt, Mgr. Maps & Records / Survey Supervisor

D. Blunt, Mgr. Maps & Records / Survey Supervisor -

ART-

HARTFORD

N/F HARTFORD
 LAUREL
 POST #45
 JEWISH WAR
 VETERANS, INC

HARTFORD

CITY
S74° 46' 38" E
99.43.


38" - LODGE

38" - LODGE

HOWARD A. BLUE
N/F

MALCOLM ASSOCIATES PARTNERSHIP
N/F
29 14 "W

RECEIVED BY
Dail M. Carey
FEB 28 2 23 PM '94
TOWN & CITY CLERK
HARTFORD
VOL _____ PAGE _____

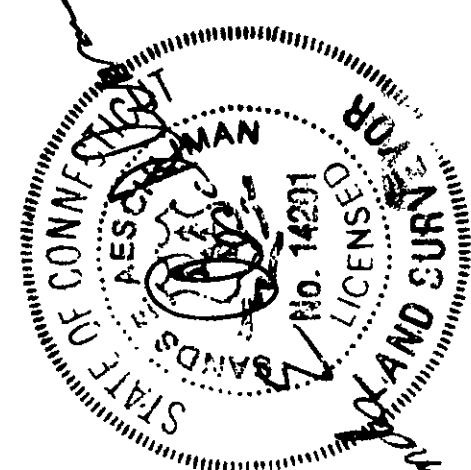

Declared to: El Hogar del Futuro, Inc.
First American Title Insurance Company
State of Connecticut

Re: Cleveland Avenue Cooperative
272 Cleveland Ave., Hartford, CT
DOH Project No. 064-LEC-021

I hereby declare that this survey was actually made on the ground on 1-14-94 and is within the standards of Class A-2 of the Code of Recommended Practice for Standards of Accuracy of Surveys and Maps of the Connecticut Association of Land Surveyors, Inc., that the lot lines, buildings and improvements are located within lot and building lines and do not encroach upon or overhang any street, title or building lines or upon any easement or right of way, that there are no violations of zoning regulations with reference to the location of any building or improvement and that except as specifically noted hereon there are no easements or encroachments affecting the surveyed property apparent from a careful inspection of the same.

272 CLEVELAND AVENUE
FOUNDATION CERTIFICATION

PREPARED FOR
EL HOGAR DEL FUTURO
HARTFORD, CONN.

REV 1-14-94 BLOK RECEIPT.

AESCHLIMAN LAND SURVEYING
GLASTONBURY, CONN.

#14201

10 5 10

Date | - 29 - 93

Map No. 93008-3

109

2089