


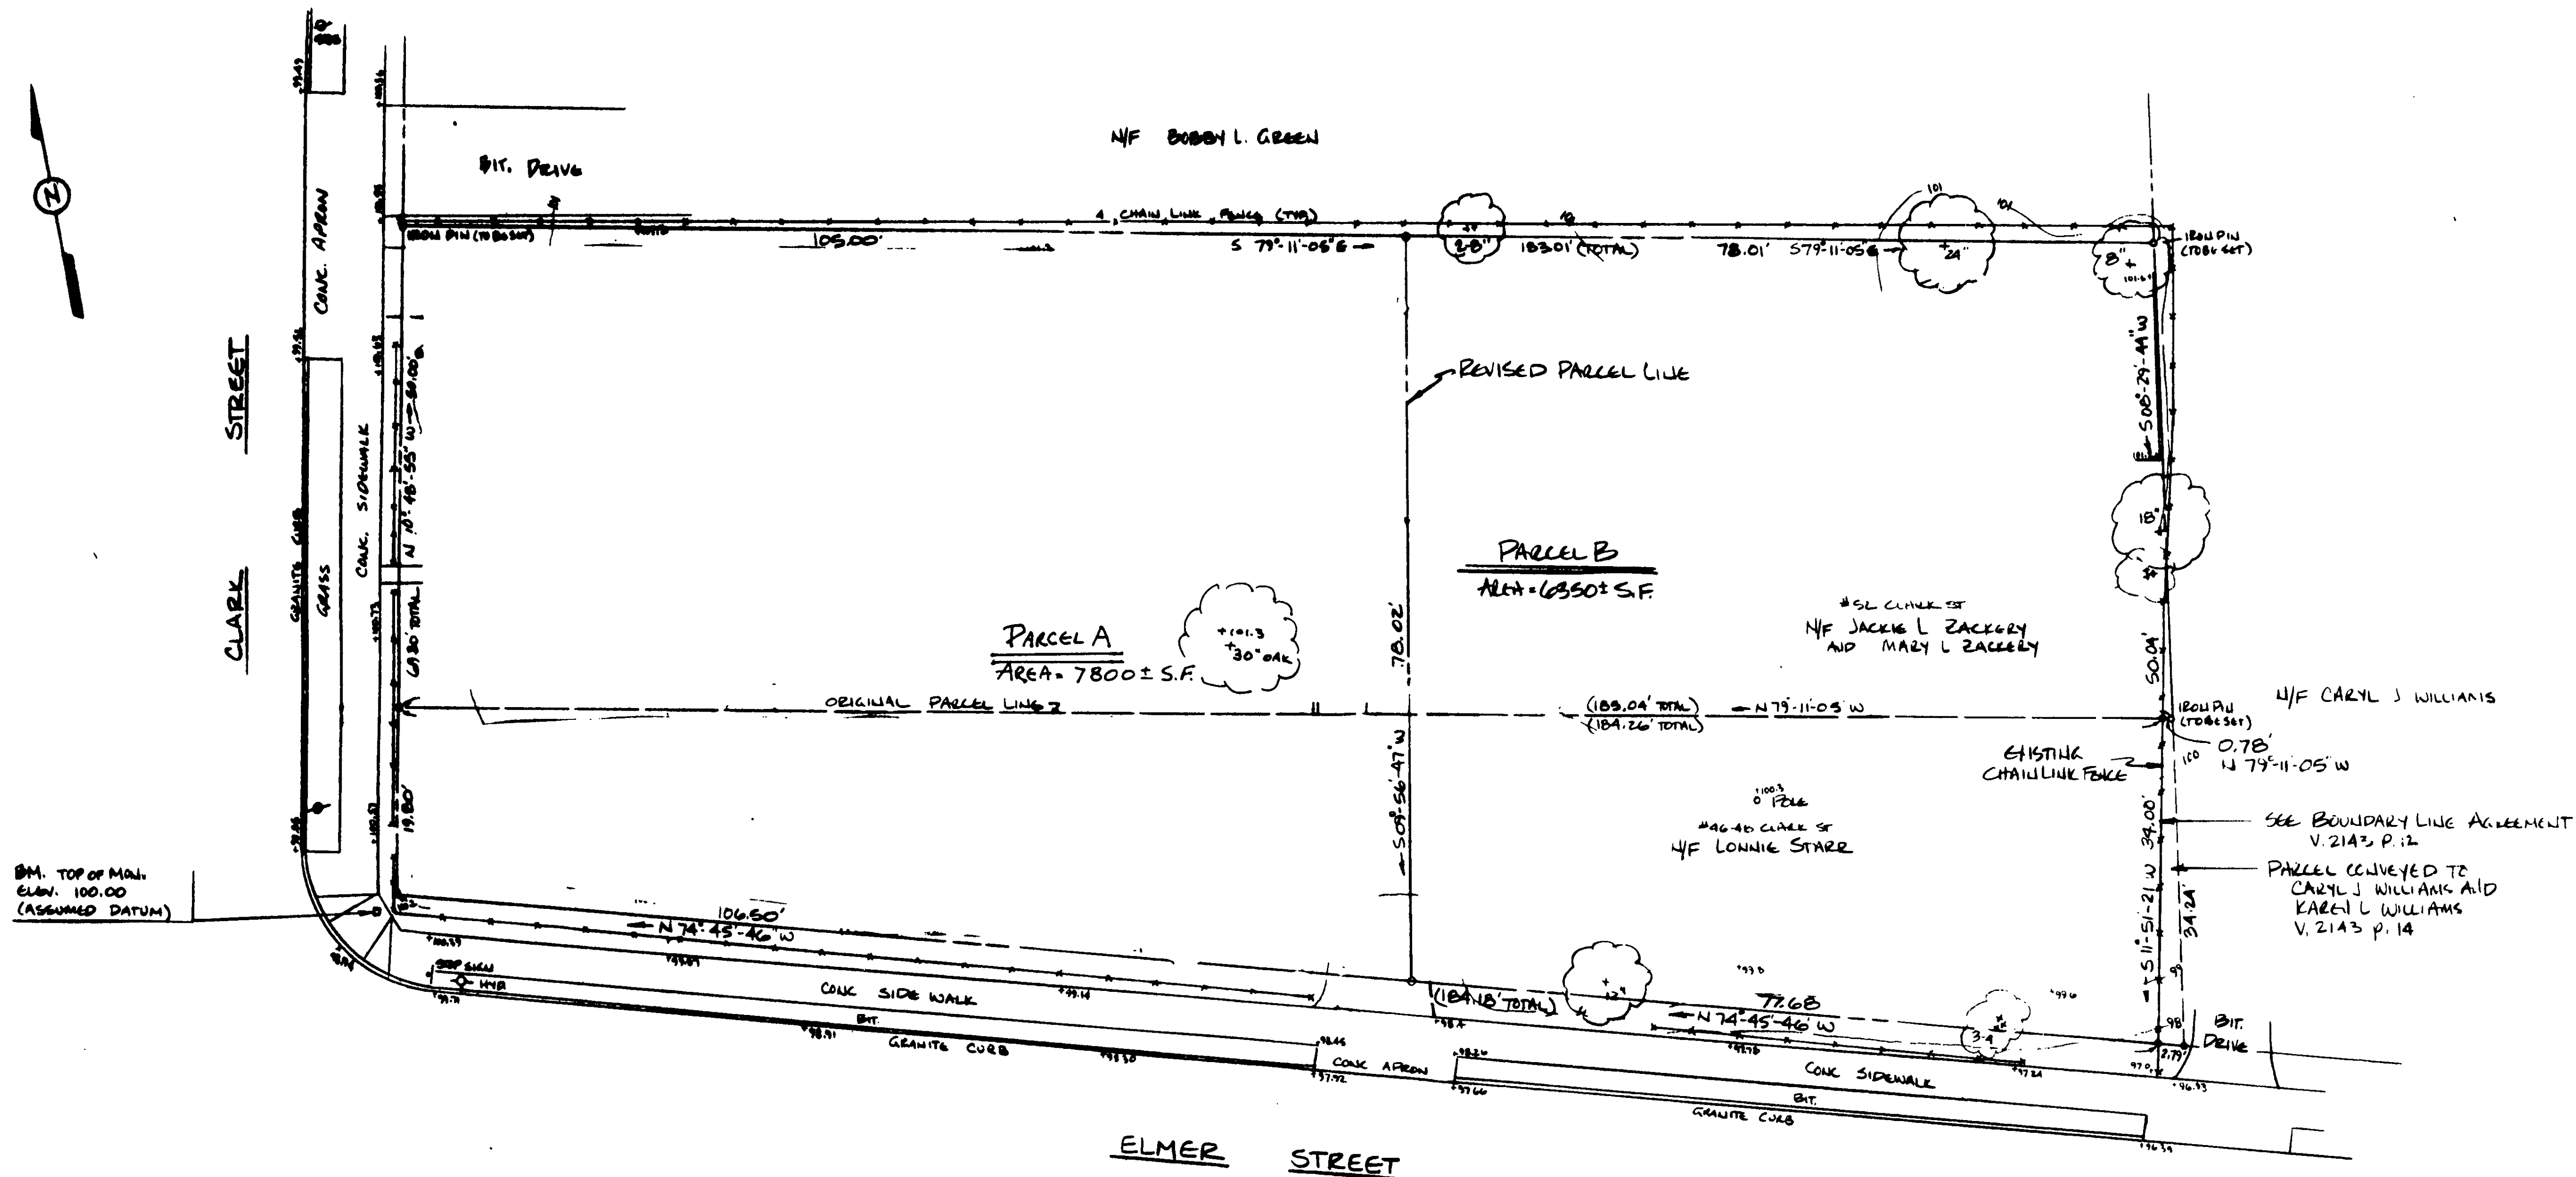

B.M. TOP OF MAIL
CLAW: 100.00
(ASSUMED DATUM)

ELMER STREET

CREST HERPGRAPHICS
FIXED LINE MYLAR

0 5 10 20 30

REVISED - 27 APRIL 1994
EXISTING STRUCTURES
REMOVED FROM MAP
INDICATING HAHFH'S
INTENTION TO DEMOLISH
ALL STRUCTURES PRIOR TO
NEW CONSTRUCTION
BOUNDARY SURVEY
PREPARED FOR
HARTFORD AREA
HABITAT FOR HUMANITY
52 CLARK STREET HARTFORD, CONN.
5 DEC 1992 1"=10' 92029
REV 30 APR 1994 PARCEL BOUNDARY

I HEREBY DECLARE THAT THIS MAP IS SUBSTANTIALLY CORRECT.
THIS MAP AND SURVEY WERE PREPARED IN ACCORDANCE WITH
THE STANDARDS OF A CLASS A-2 SURVEY AS DEFINED IN THE
"RECOMMENDED STANDARDS FOR SURVEYS AND MAPS IN THE
STATE OF CONNECTICUT" AS PREPARED AND ADOPTED BY THE
CONNECTICUT ASSOCIATION OF LAND SURVEYORS, INC. ON
SEPTEMBER 19, 1984.

DAVID A. MALINOSKI JR. #13046

TOPOGRAPHIC FEATURES DEPICTED HEREON WERE PREPARED IN
ACCORDANCE WITH CLASS T-2.

Malinoski *Malinoski*

MALINOSKI ASSOCIATES
5 BEACON DRIVE, ASHFORD, CT 06018

The portions of Clark and Elmer
Streets shown on this map, are
established public streets of the
City of Hartford.
David A. Malinoski Jr.
Professional Survey Supervisor

2094

0 INCHES 1 2 3 4

2094