


P-424

2097

The portion of Jefferson Street shown on this map is an established public street of the City of Hartford.
Robert Blinn
Hartford Blinn Survey Supervisor

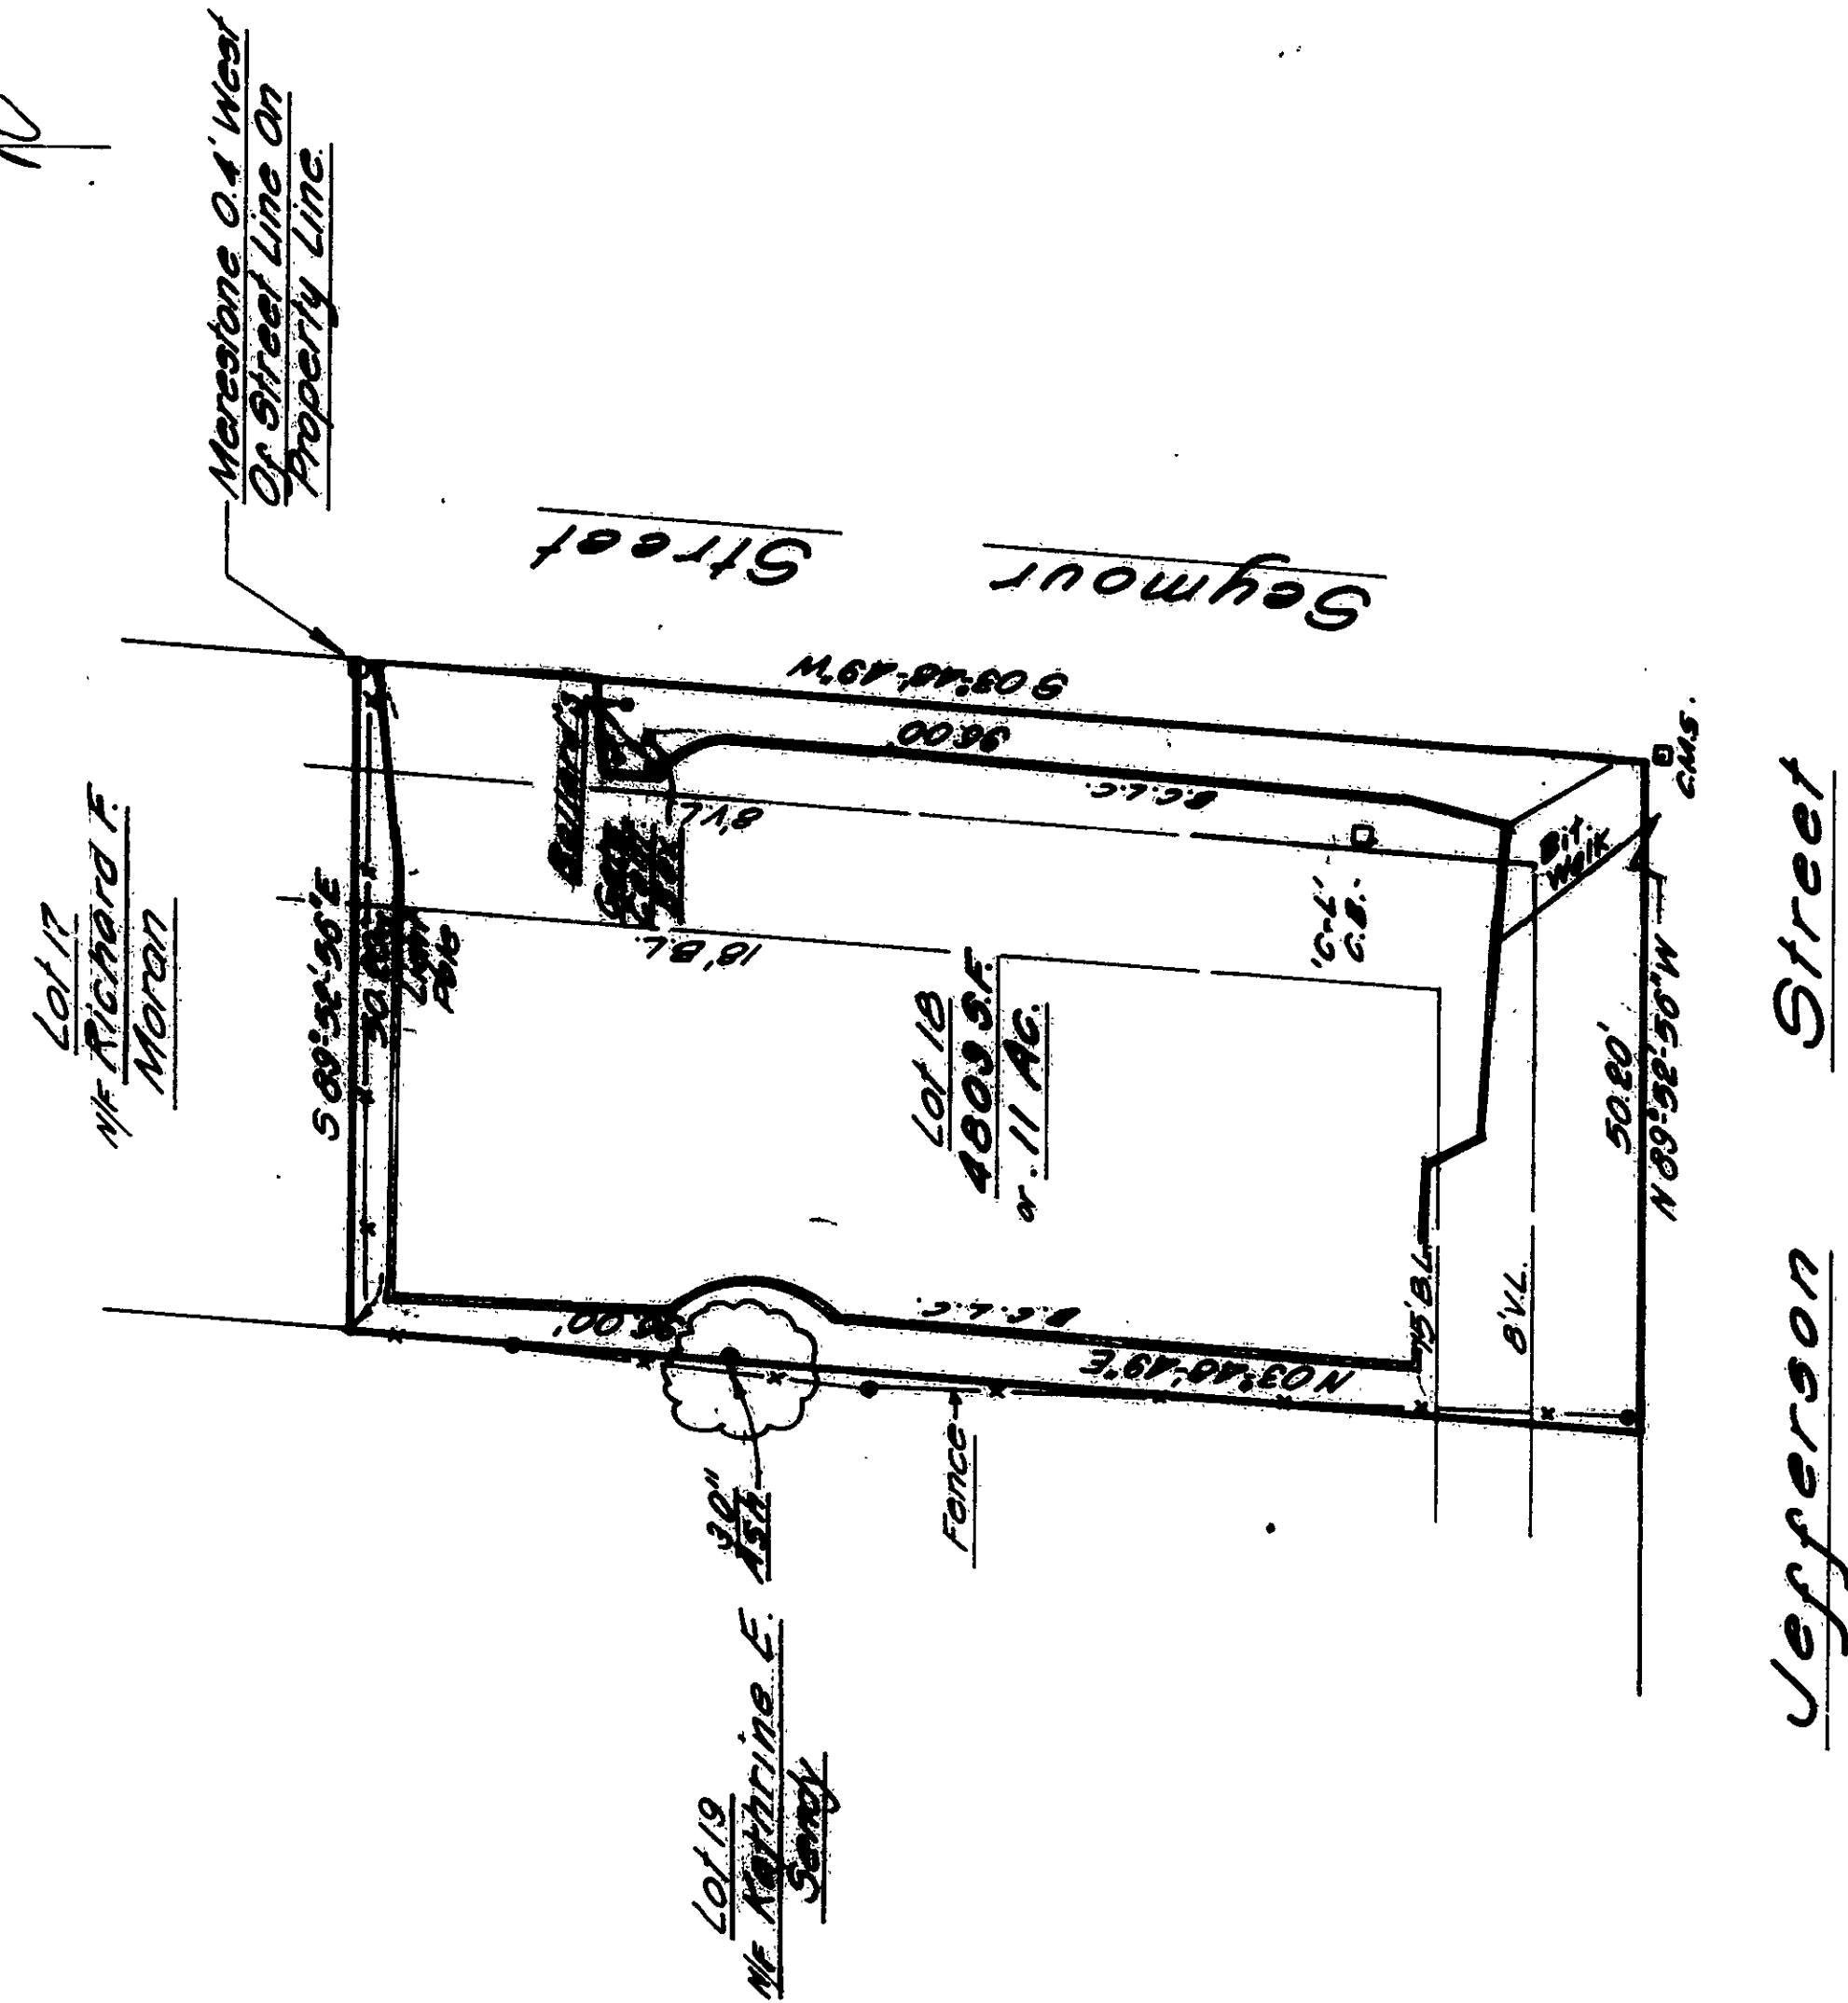


I hereby certify to
that this survey was actually made upon the ground on
and that it and the bounds and measurements shown are correct within the
standards of a Class "A" survey as defined in the "Recommended
Standards for Surveys and Maps in the State of Connecticut" as prepared and
adopted by the Connecticut Association of Land Surveyors, Inc.,
September 13, 1984 and that, unless otherwise shown, deed lines and lines of
actual possession are the same, buildings are located as shown and do not
encroach over, or upon the street, dealer building lines, there are no violations of
zoning regulations with reference to the location of said buildings, and there are
no easements or encroachments affecting this property apparent from a careful
inspection of the same, other than those noted and depicted hereon.
CLOSE, JENSEN & MILLER, P.C.
Civil Engineers & Land Surveyors
By Robert J. Miller

RECEIVED BY
D. J. Miller
JUL 27 9 50 AM '94

Note:
Property not located in a special Flood Hazard Zone
Per FEMA Flood Community Panel 050502D 0005B
MID Revised December 4, 1986

OLIVER CORPORATION
FIXED LINE PHOTOGRAPHIC

No.	Date	Description
1	7/6/94	Updated
Revisions		

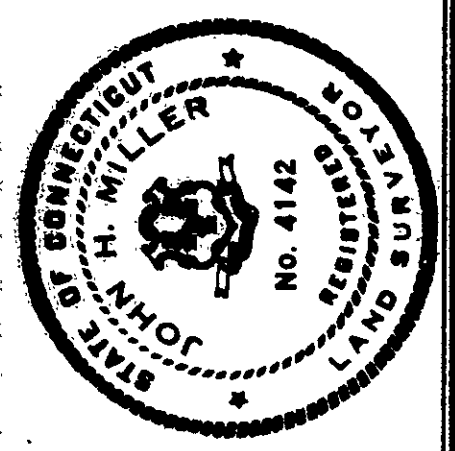

C. J. M.
Blase, Jensen & Miller, P.C.
Consulting Engineers, Land Planners & Surveyors
449 Silas Deane Highway Wethersfield, Connecticut 06093

Property of:
"EIGHTY JEFFERSON STREET, LLC"
80 Jefferson Street
Seymour Street
Hartford Connecticut

Designed	Drawn	Checked	Scale	Date
	R.B.B.	J.F.W.	1"=20'	May 13, 1993
Sheet No.	One	Of	One	
Job No.	34102	File No.	P-424	

P-424



EASH FILE CORP. IRVING, CA 874 34
2099

2099

6602