

2130

RECEIVED BY

Dail M. Carey

DEC 20 12 06 PM '94

TOWN CLERK
HARTFORD

VOL _____

Lot numbers from
reference map

Note


Map not valid without
live signature and embossed
seal

Reference Map

Goodwin Park Lawn
Hartford, Conn.
Managed by S.I. Ward & Co
Scale 1"=100 feet August 1924
L.W. Burt & Son Civil Engineers

This survey was conducted on the ground
on March 6, 1994

This survey and map conforms to the standards
of a "A-2" Survey as adopted by the Connecticut
Association of Land Surveyors Inc on September 24,
1992

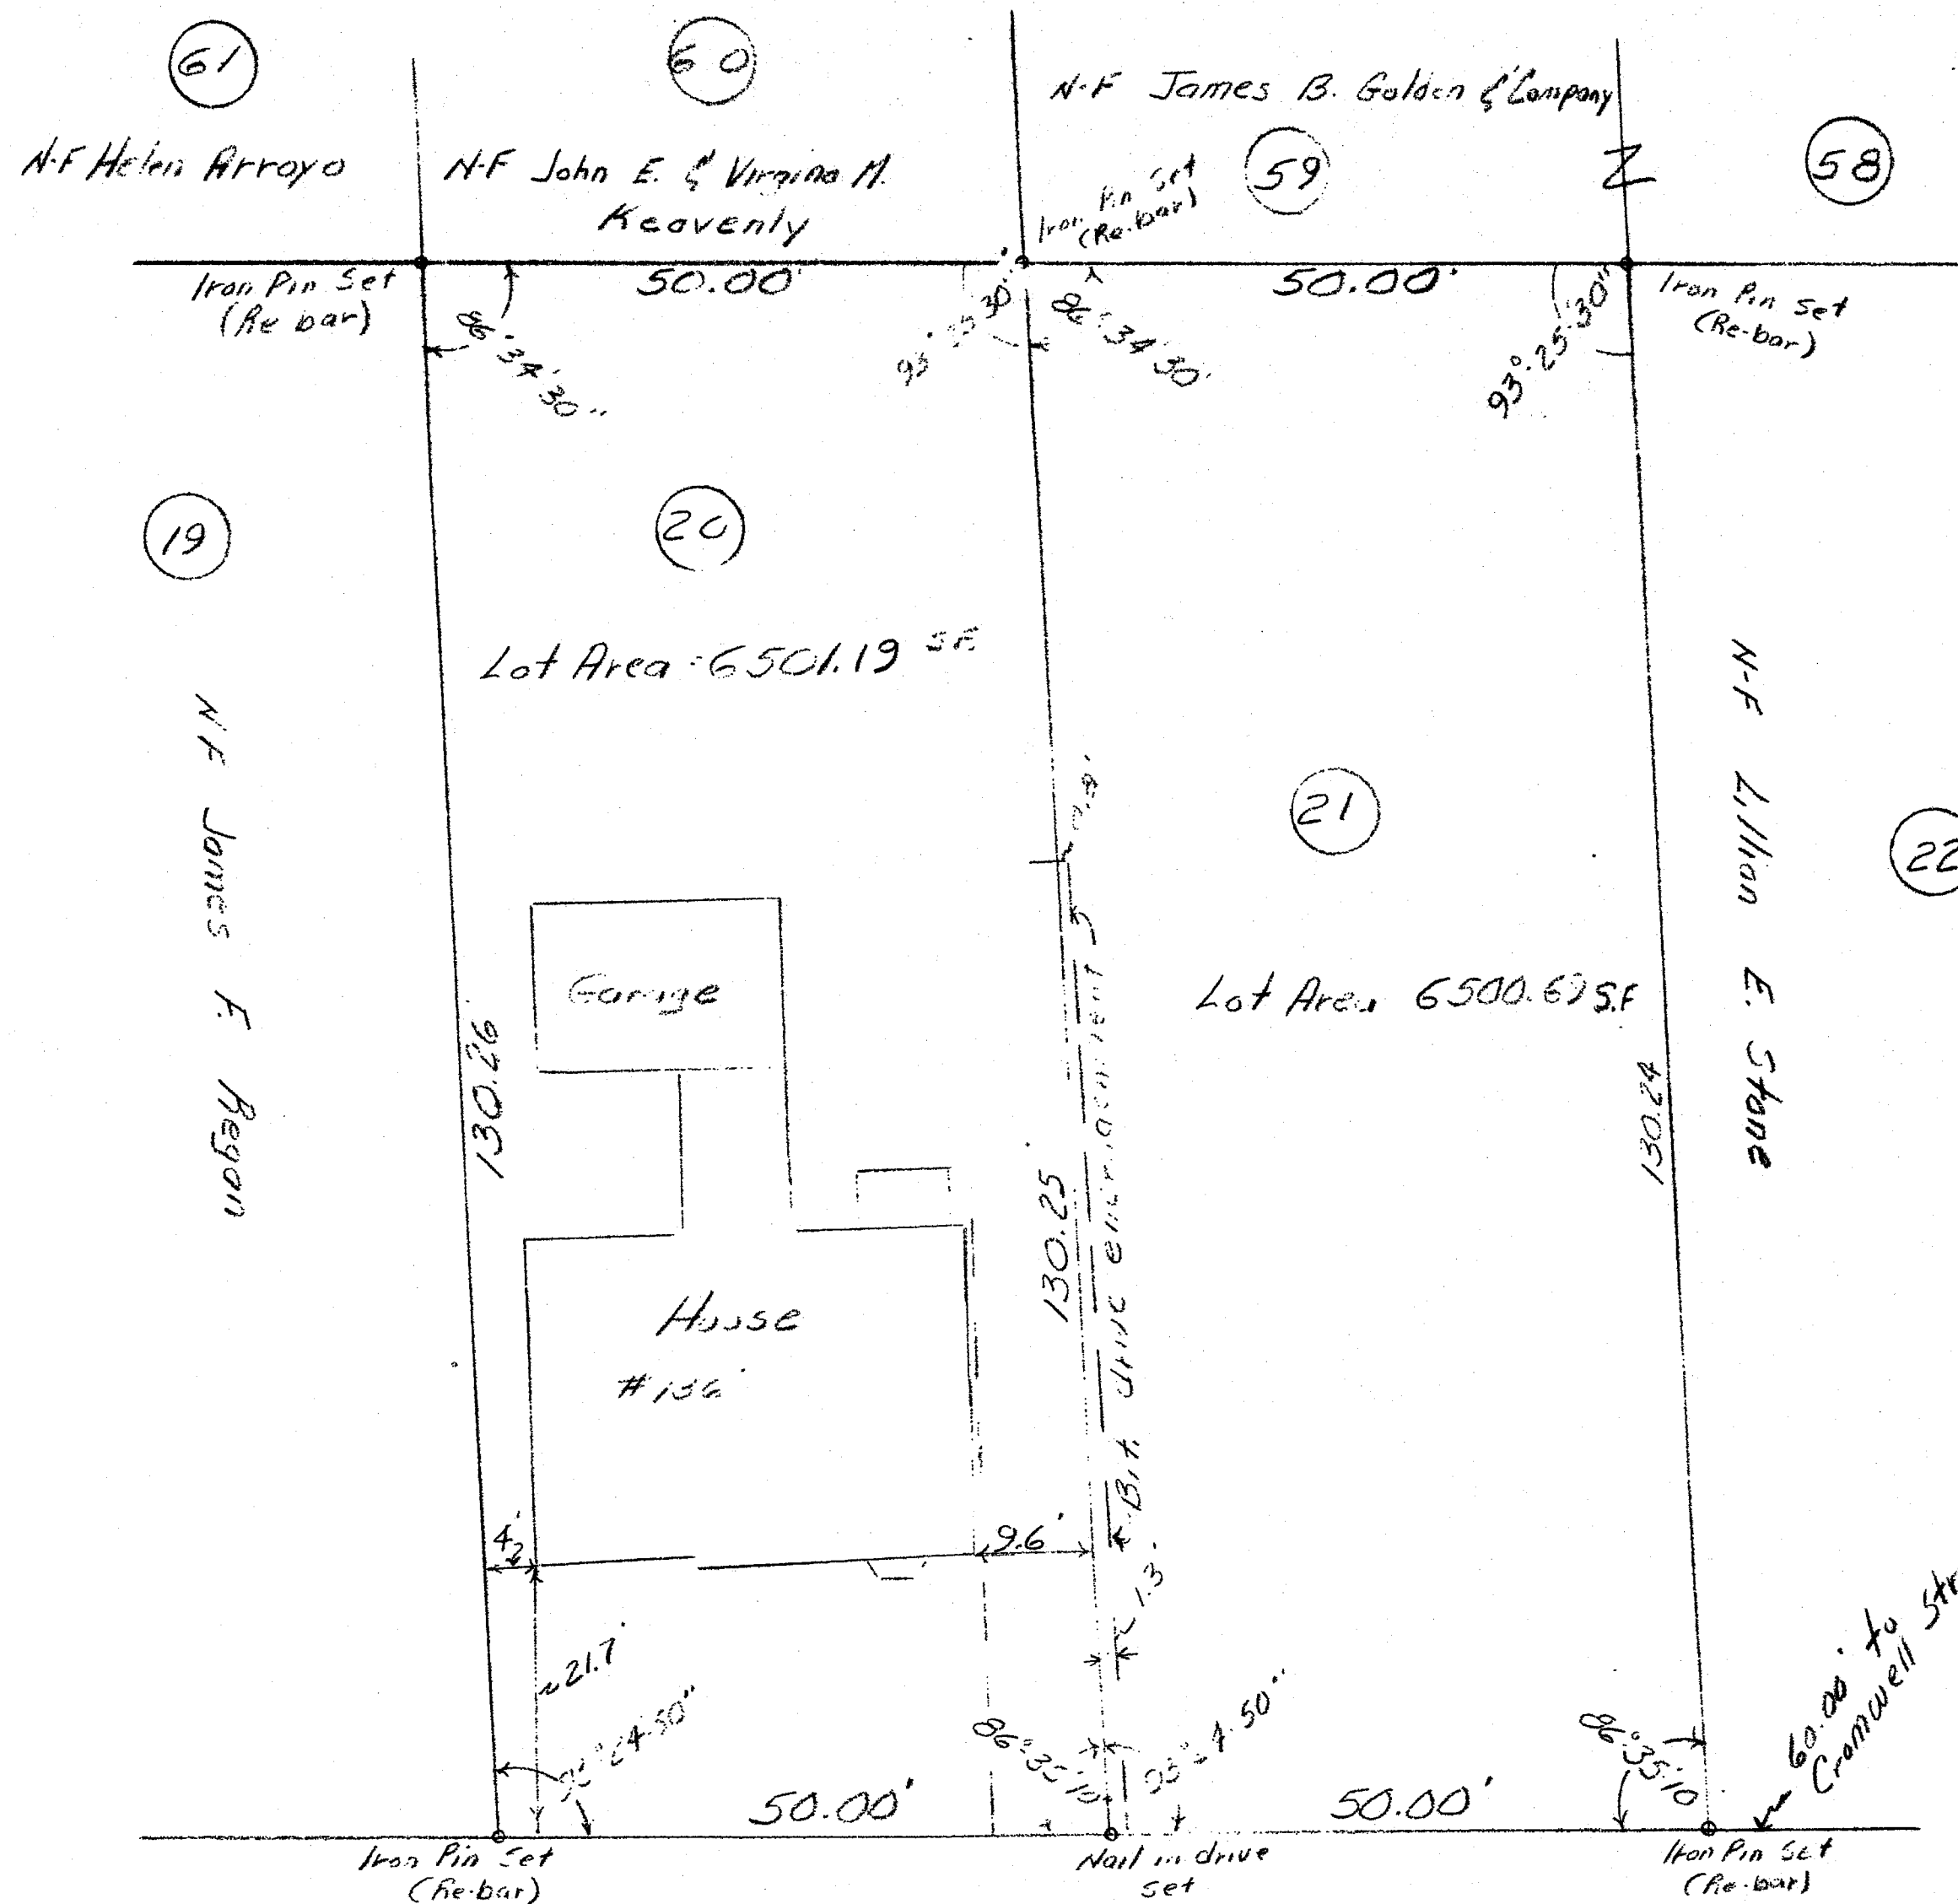

HUBBARD ROAD

Patricia C. Kelly
#10039

This drawing reproduced in
accordance with state filing
regulations. Process used:
☐ Wash-off ☒ Fixed-line photo
Joseph Merritt & Company

Revisions April, 1994

Lot #20

1.) Lot Area Revised from
6501.43 S.F. To 6501.19 SF
Lot #21

2.) Southerly property line from
130.26 to 130.24

3.) Lot Area Revised from
6501.43 SF to 6500.62 SF
Lot 20 & 21

4.) Common Property Line Revised
from 130.26 to 130.25



The portion of Hubbard Road
shown on this map is an
established public street
of the City of Hartford.

O. Blunt
Survey Supervisor

Map

Property of

MARY F. ARMENTANO

136-140 Hubbard Road

Hartford Connecticut

Scale 1"=20' March, 1994

1"=20' 0 10 20 40
Scale Feet

2130

2130

