


OSWALD R. BLUNT, ASSOC.
ORIGINAL INK DRAWING
ON MYLAR.

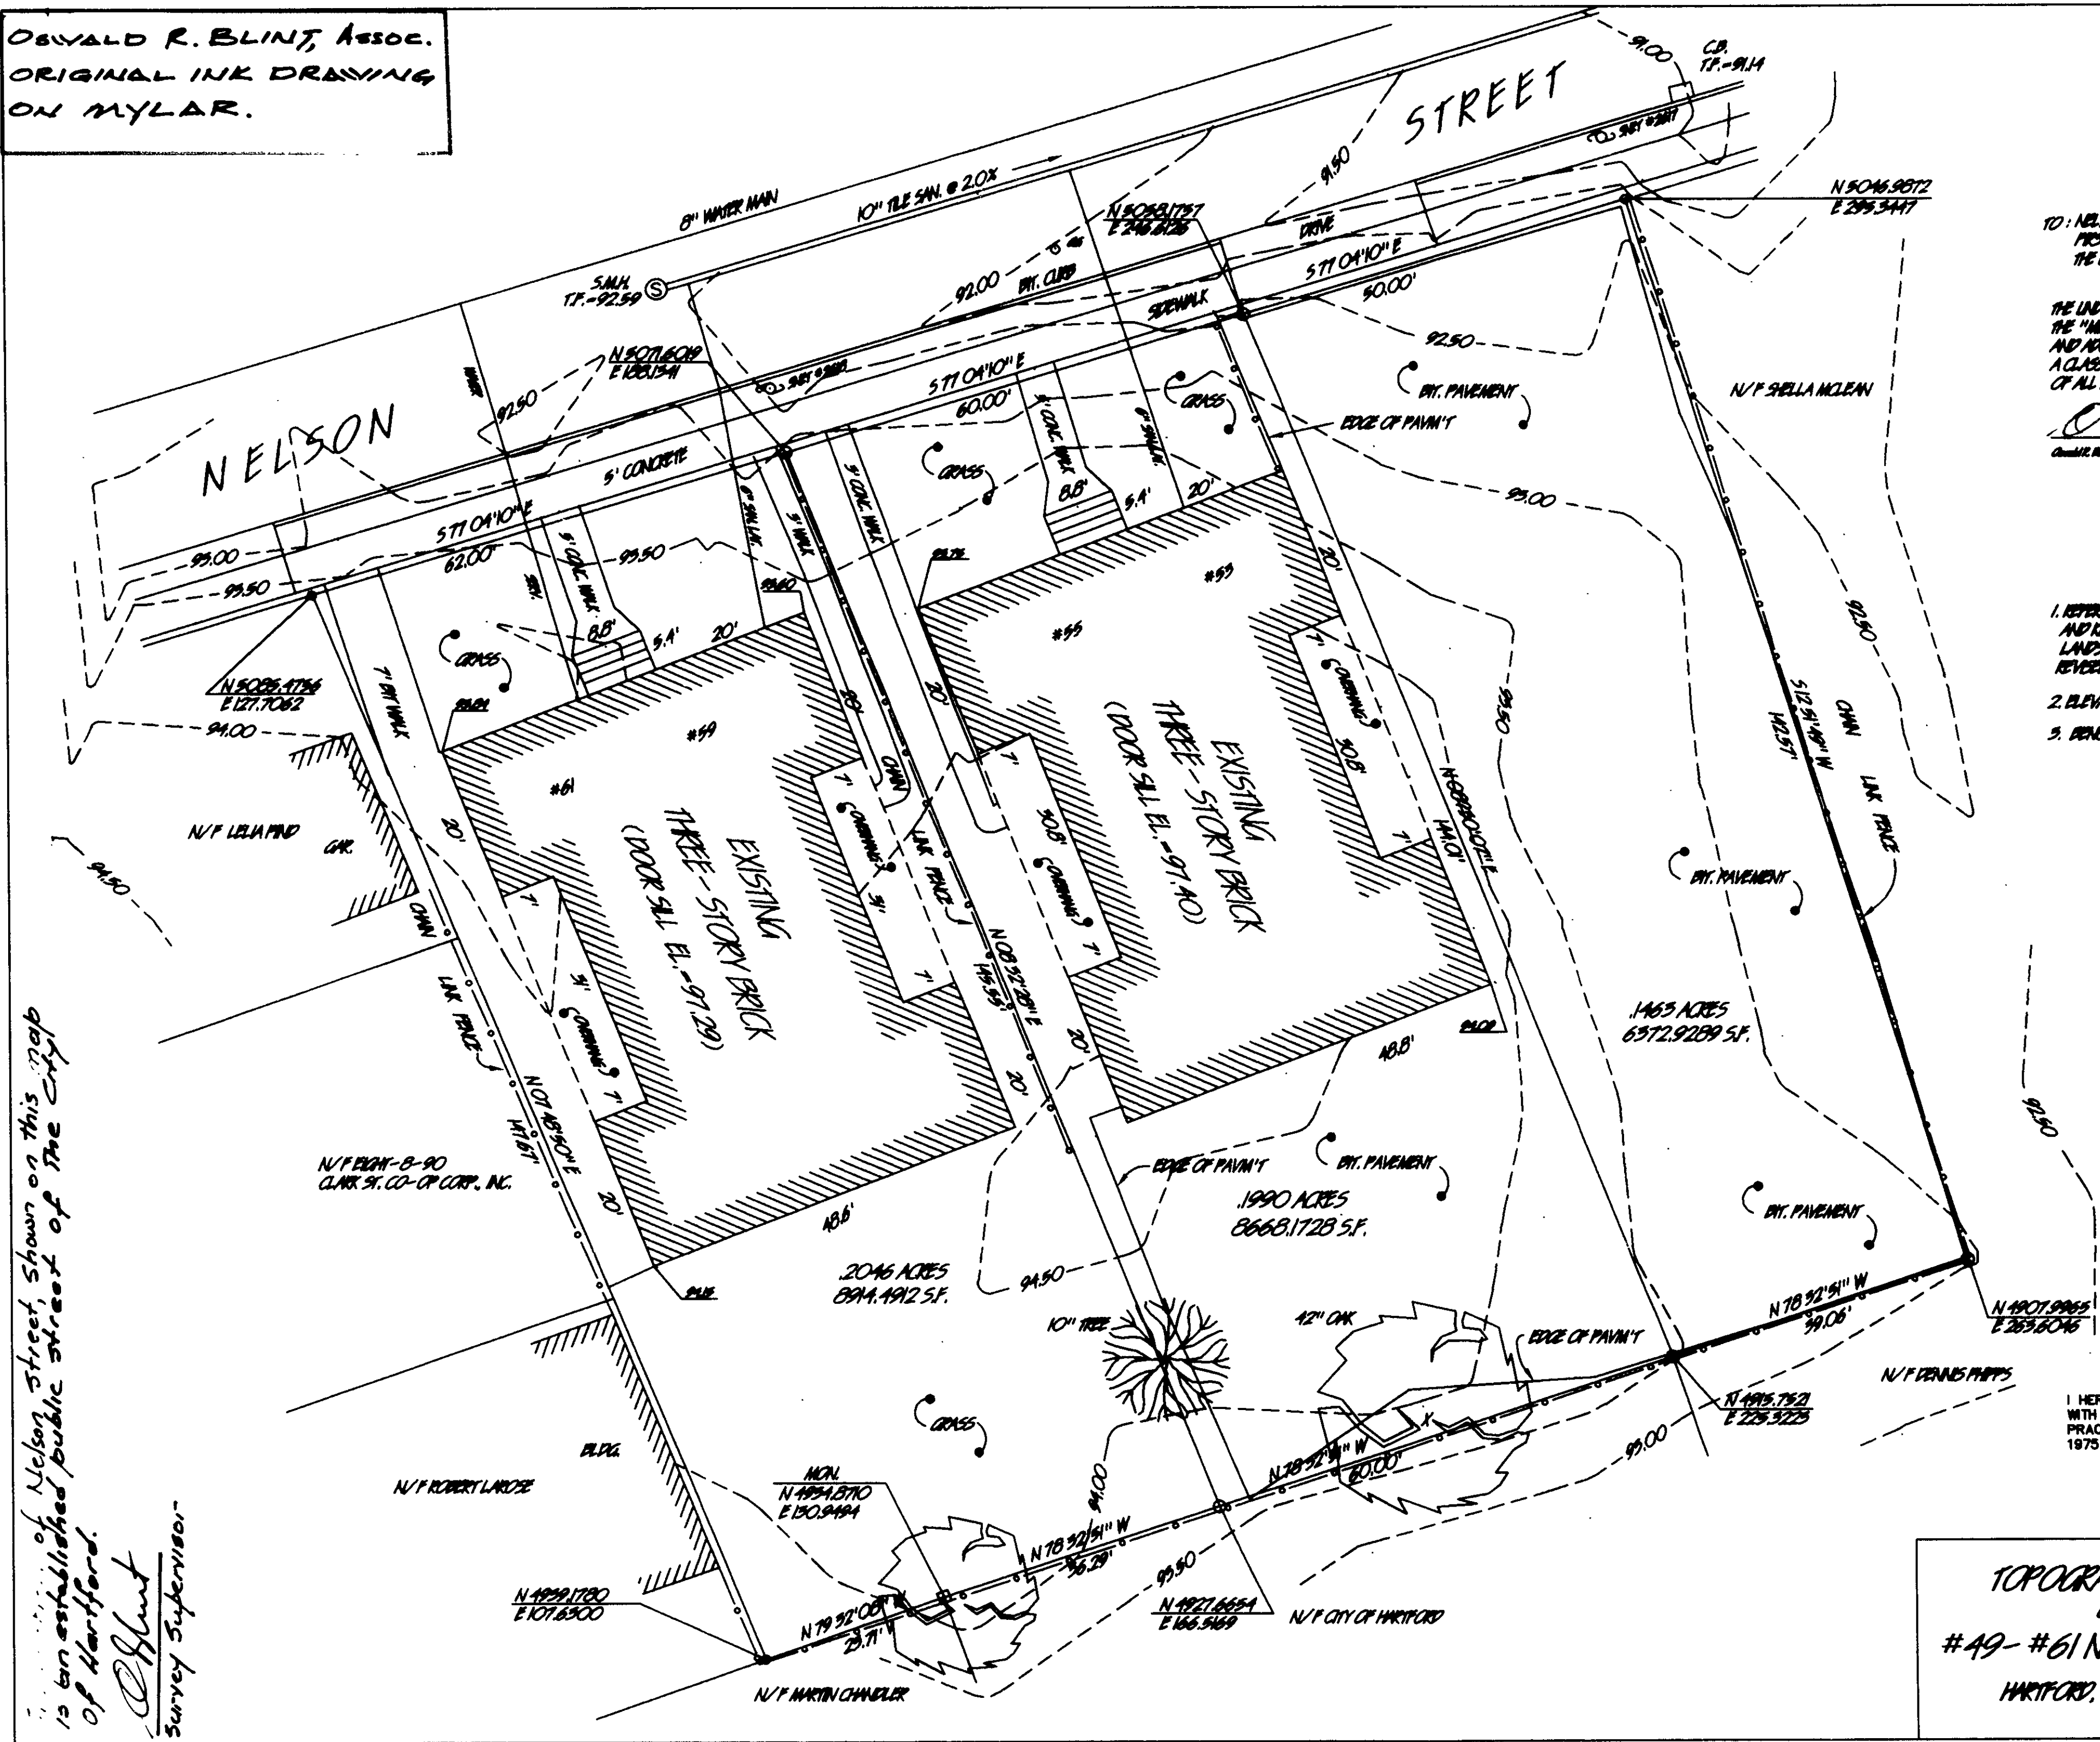

TO: NELSON STREET LIMITED PARTNERSHIP
FROM: AMERICAN TITLE INSURANCE COMPANY
THE CITY OF HARTFORD

THE UNDERSIGNED DOES HEREBY CERTIFY THAT THIS SURVEY WAS MADE IN ACCORDANCE WITH THE "MINIMUM FEEL REQUIREMENTS FOR ALTA/ACSM LAND TITLE SURVEYS" FORMALLY ESTABLISHED AND ADOPTED BY ALTA AND ACSM IN 1906, AND MEETS THE ACCURACY REQUIREMENTS FOR A CLASS A-2 SURVEY AS DEFINED THEREIN, AND ALSO IN ALL RESPECTS MEETS THE REQUIREMENTS OF ALL APPLICABLE LAW.

O. Blunt
Oswald R. Blunt, Surveyor No. 10248

- MAP REFERENCES AND NOTES**
- REFERENCE IS HEREBY MADE TO A MAP ENTITLED "NEEDS, CHATHAM, GLOUCESTER, AND KERSHAW, REVERED LOT PLAN HALLMARK RENTY-HARTFORD, CT, THOMAS H. REYNOLD LANDSCAPE ARCHITECT SIMILAR, SCALE 1"=80', DRAWING NO. 6, FILE NO. REVERED LOT 20, 1900, DATED MAY 28, 1900."
 - ELEVATIONS ARE BASED ON MEANS OF THE REVERED LOT.
 - BENCHMARK ELEVATION 91.99 FT. NAD 83, COR. ACTON/NELSON STREETS.


I HEREBY CERTIFY THAT THIS MAP AND SURVEY WERE PREPARED IN ACCORDANCE WITH THE STANDARDS OF A CLASS A2 SURVEY AS DEFINED IN THE CODE OF PRACTICE FOR STANDARDS OF ACCURACY OF SURVEYS AND MAPS, ADOPTED DEC. 1975 BY THE CONNECTICUT ASSOCIATION OF LAND SURVEYORS, INC.

TOPOGRAPHIC PLAN OF #49-#61 NELSON STREET HARTFORD, CONNECTICUT	REVISIONS	
OSWALD R. BLUNT REGISTERED LAND SURVEYOR HARTFORD, CONNECTICUT SCALE: 1"=80' DATE: JULY 28, 1998		

