


2205

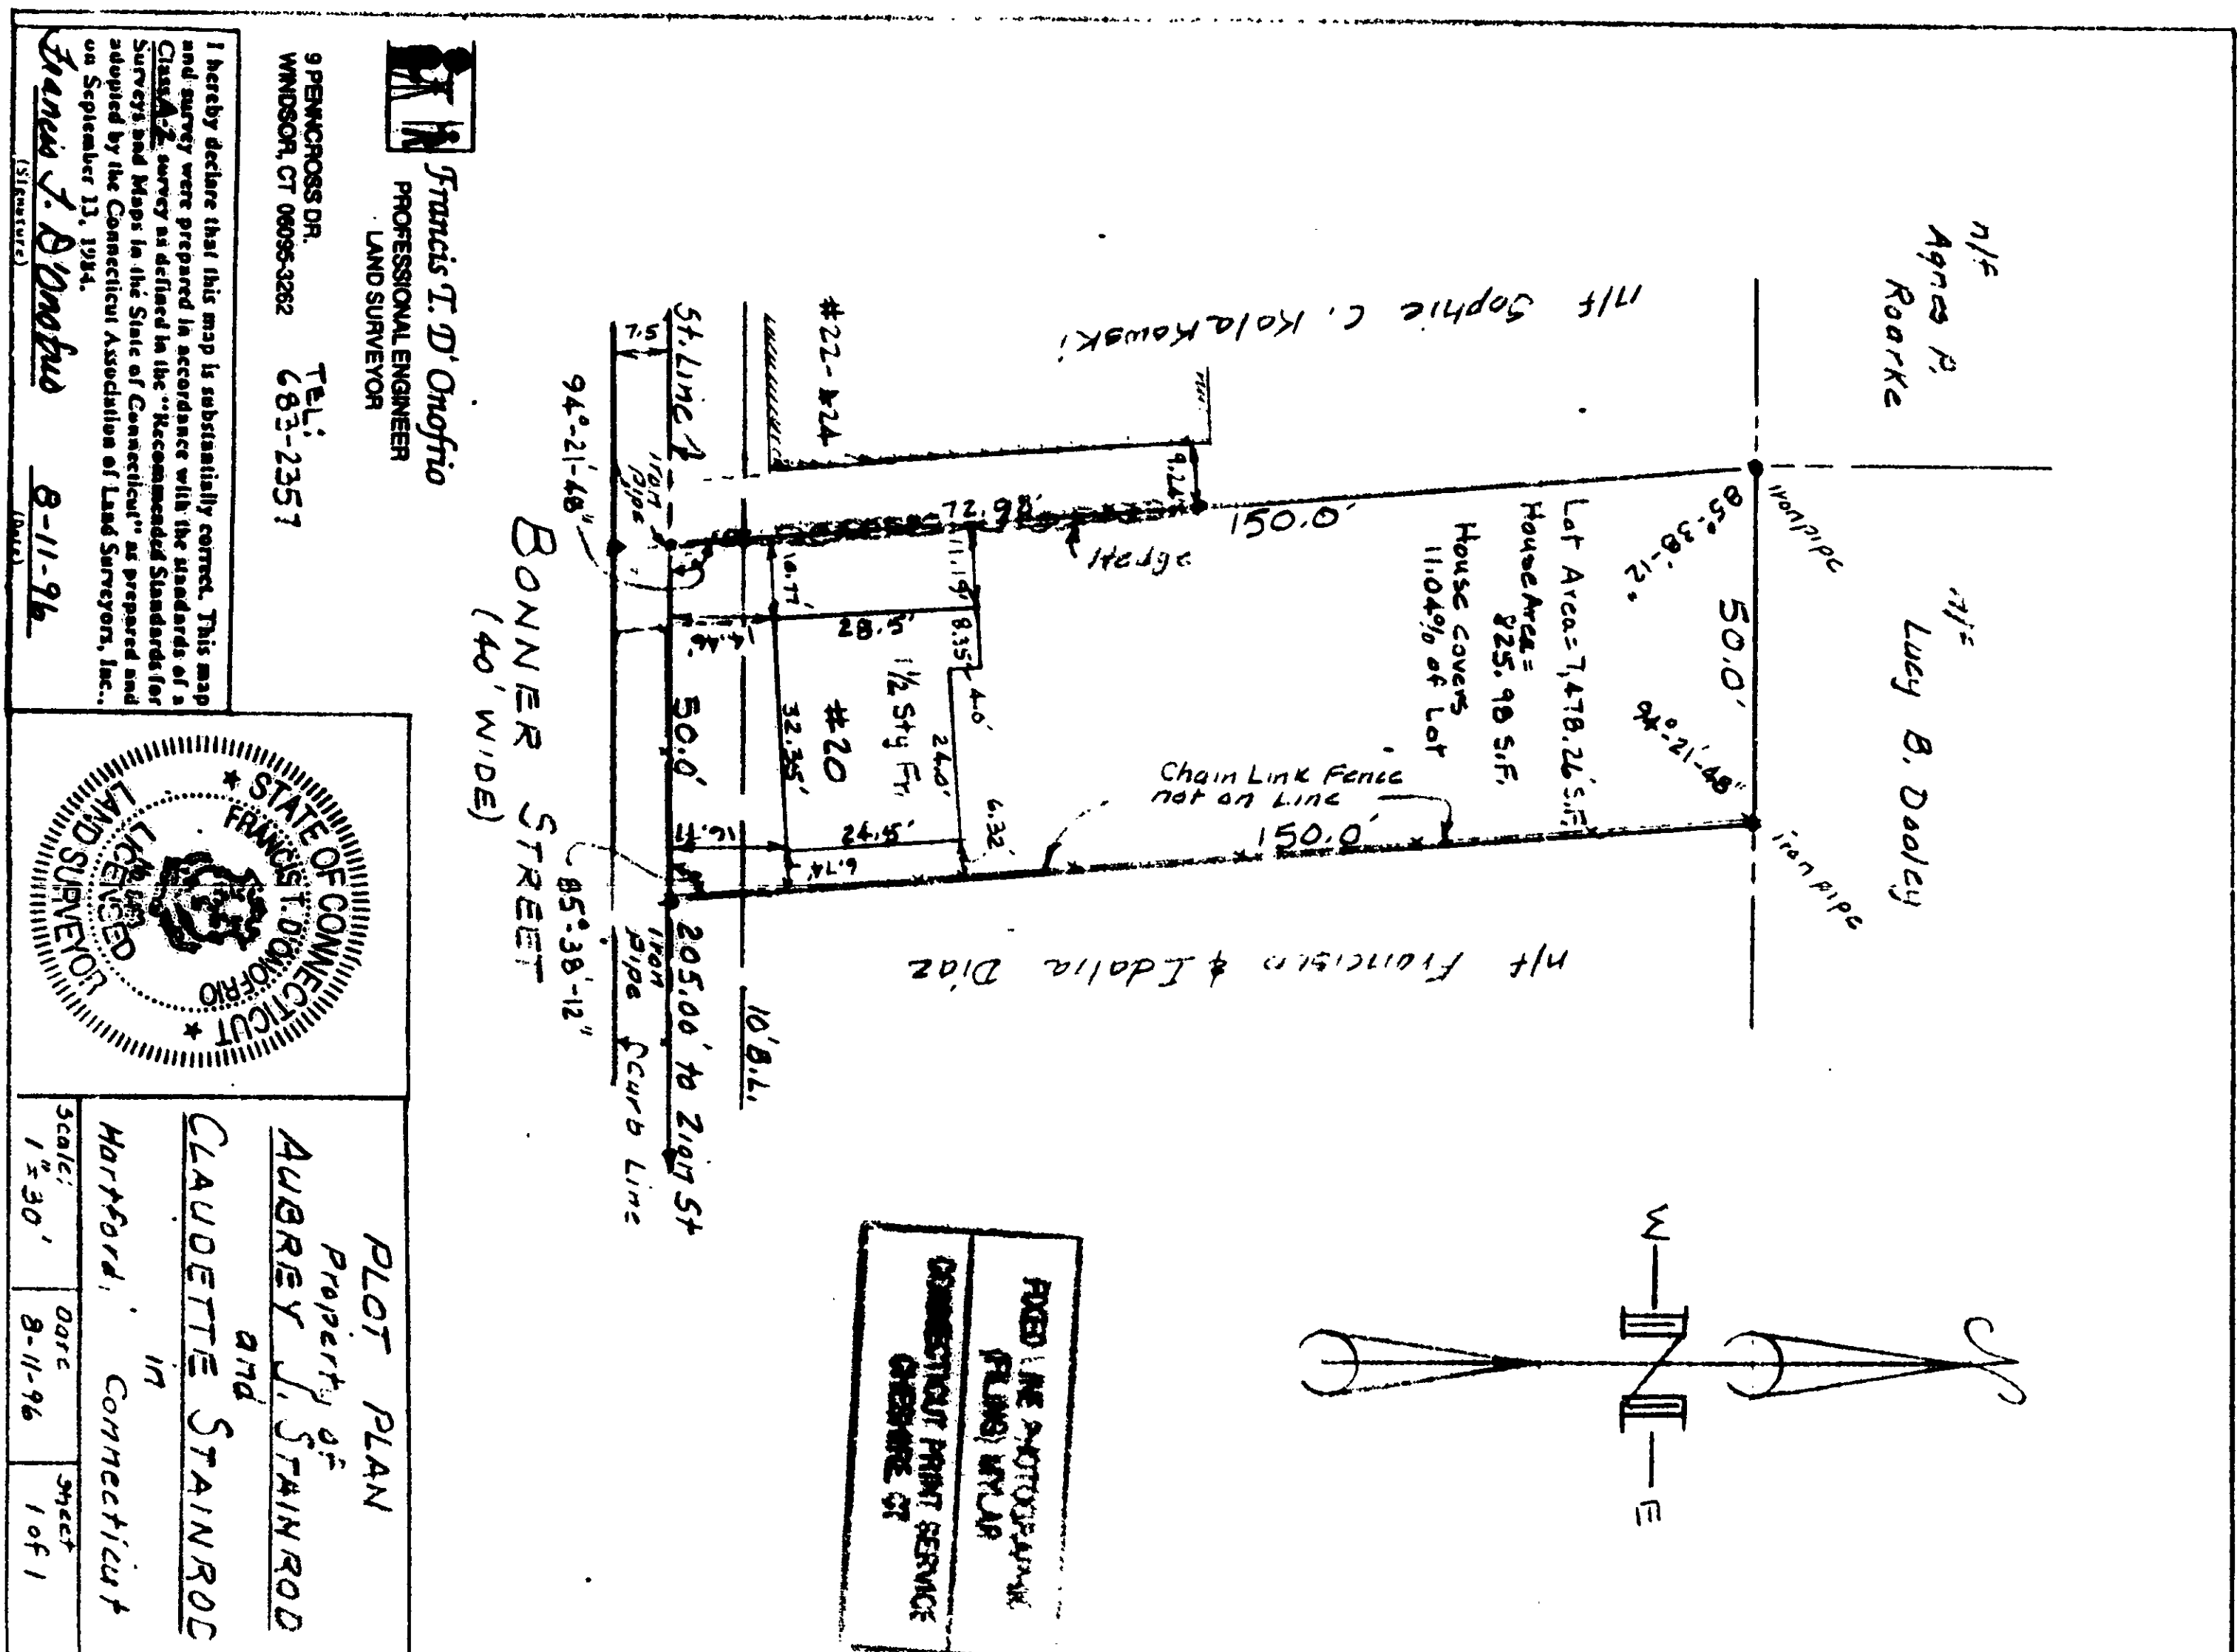







2205