


2241

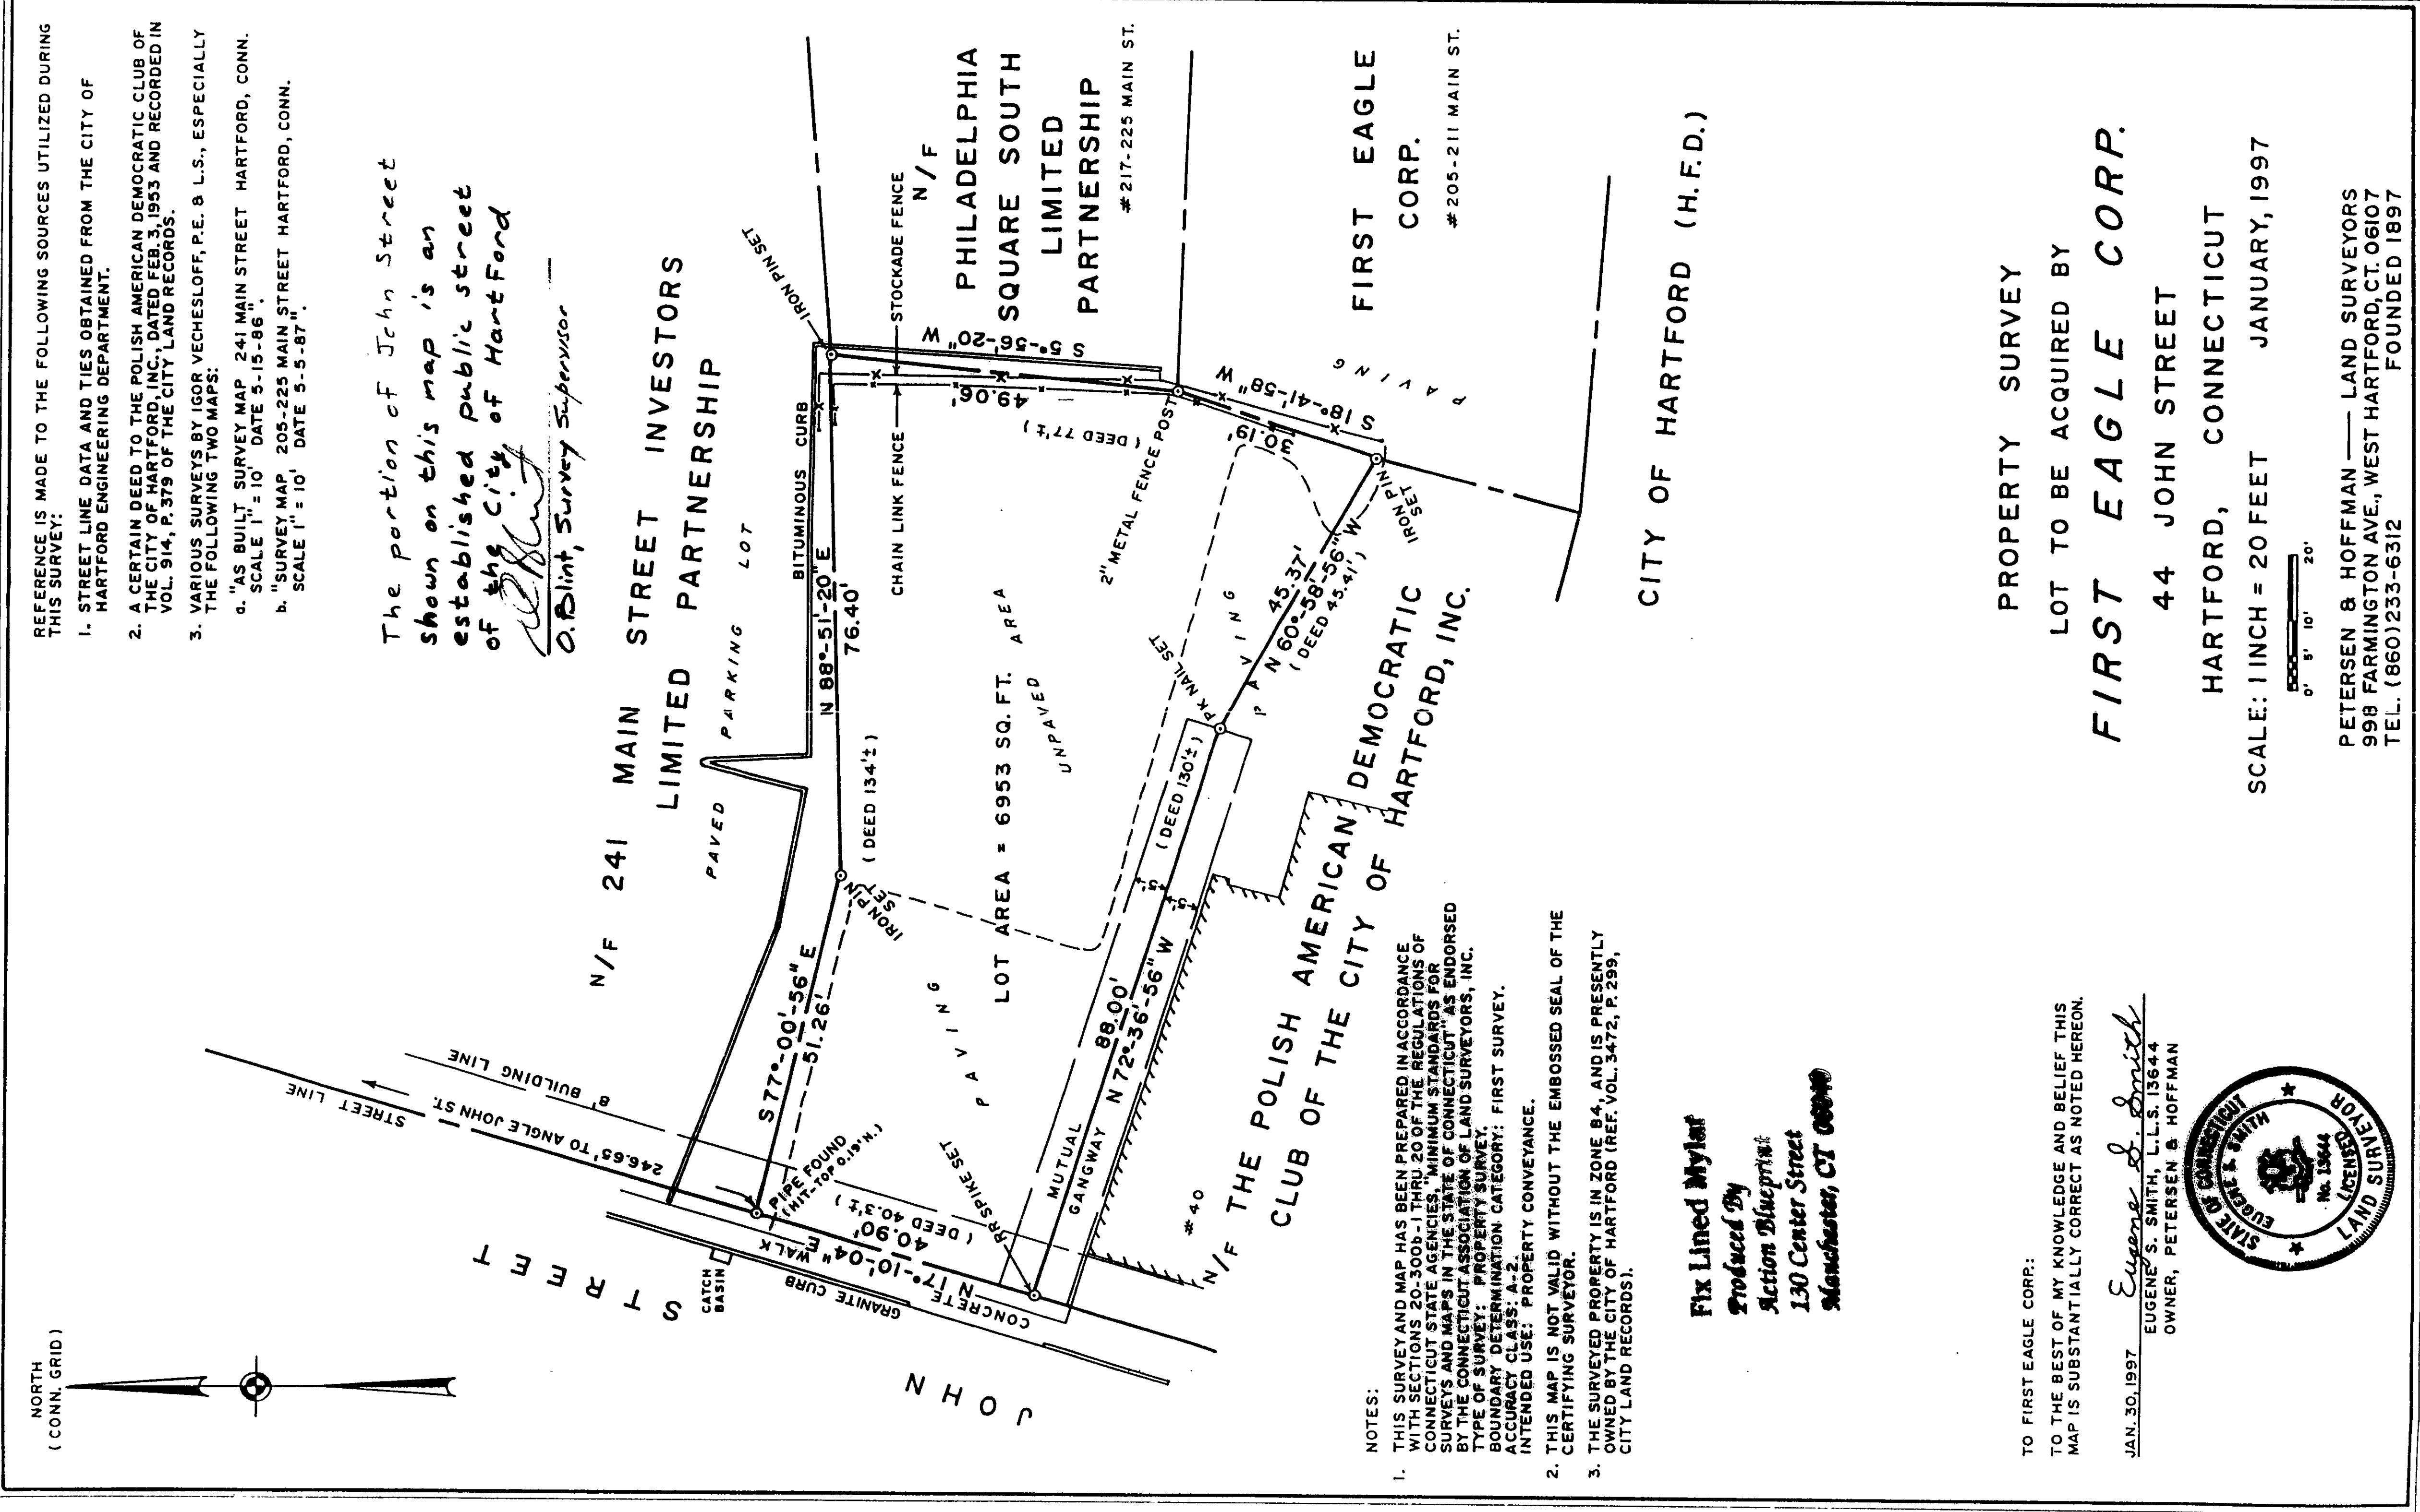


2241

EPH 36

