


The portion of Inlay Street shown on this map is an established public street of The City of Hartford

D. Hunt
C. Eng. Survey Super.

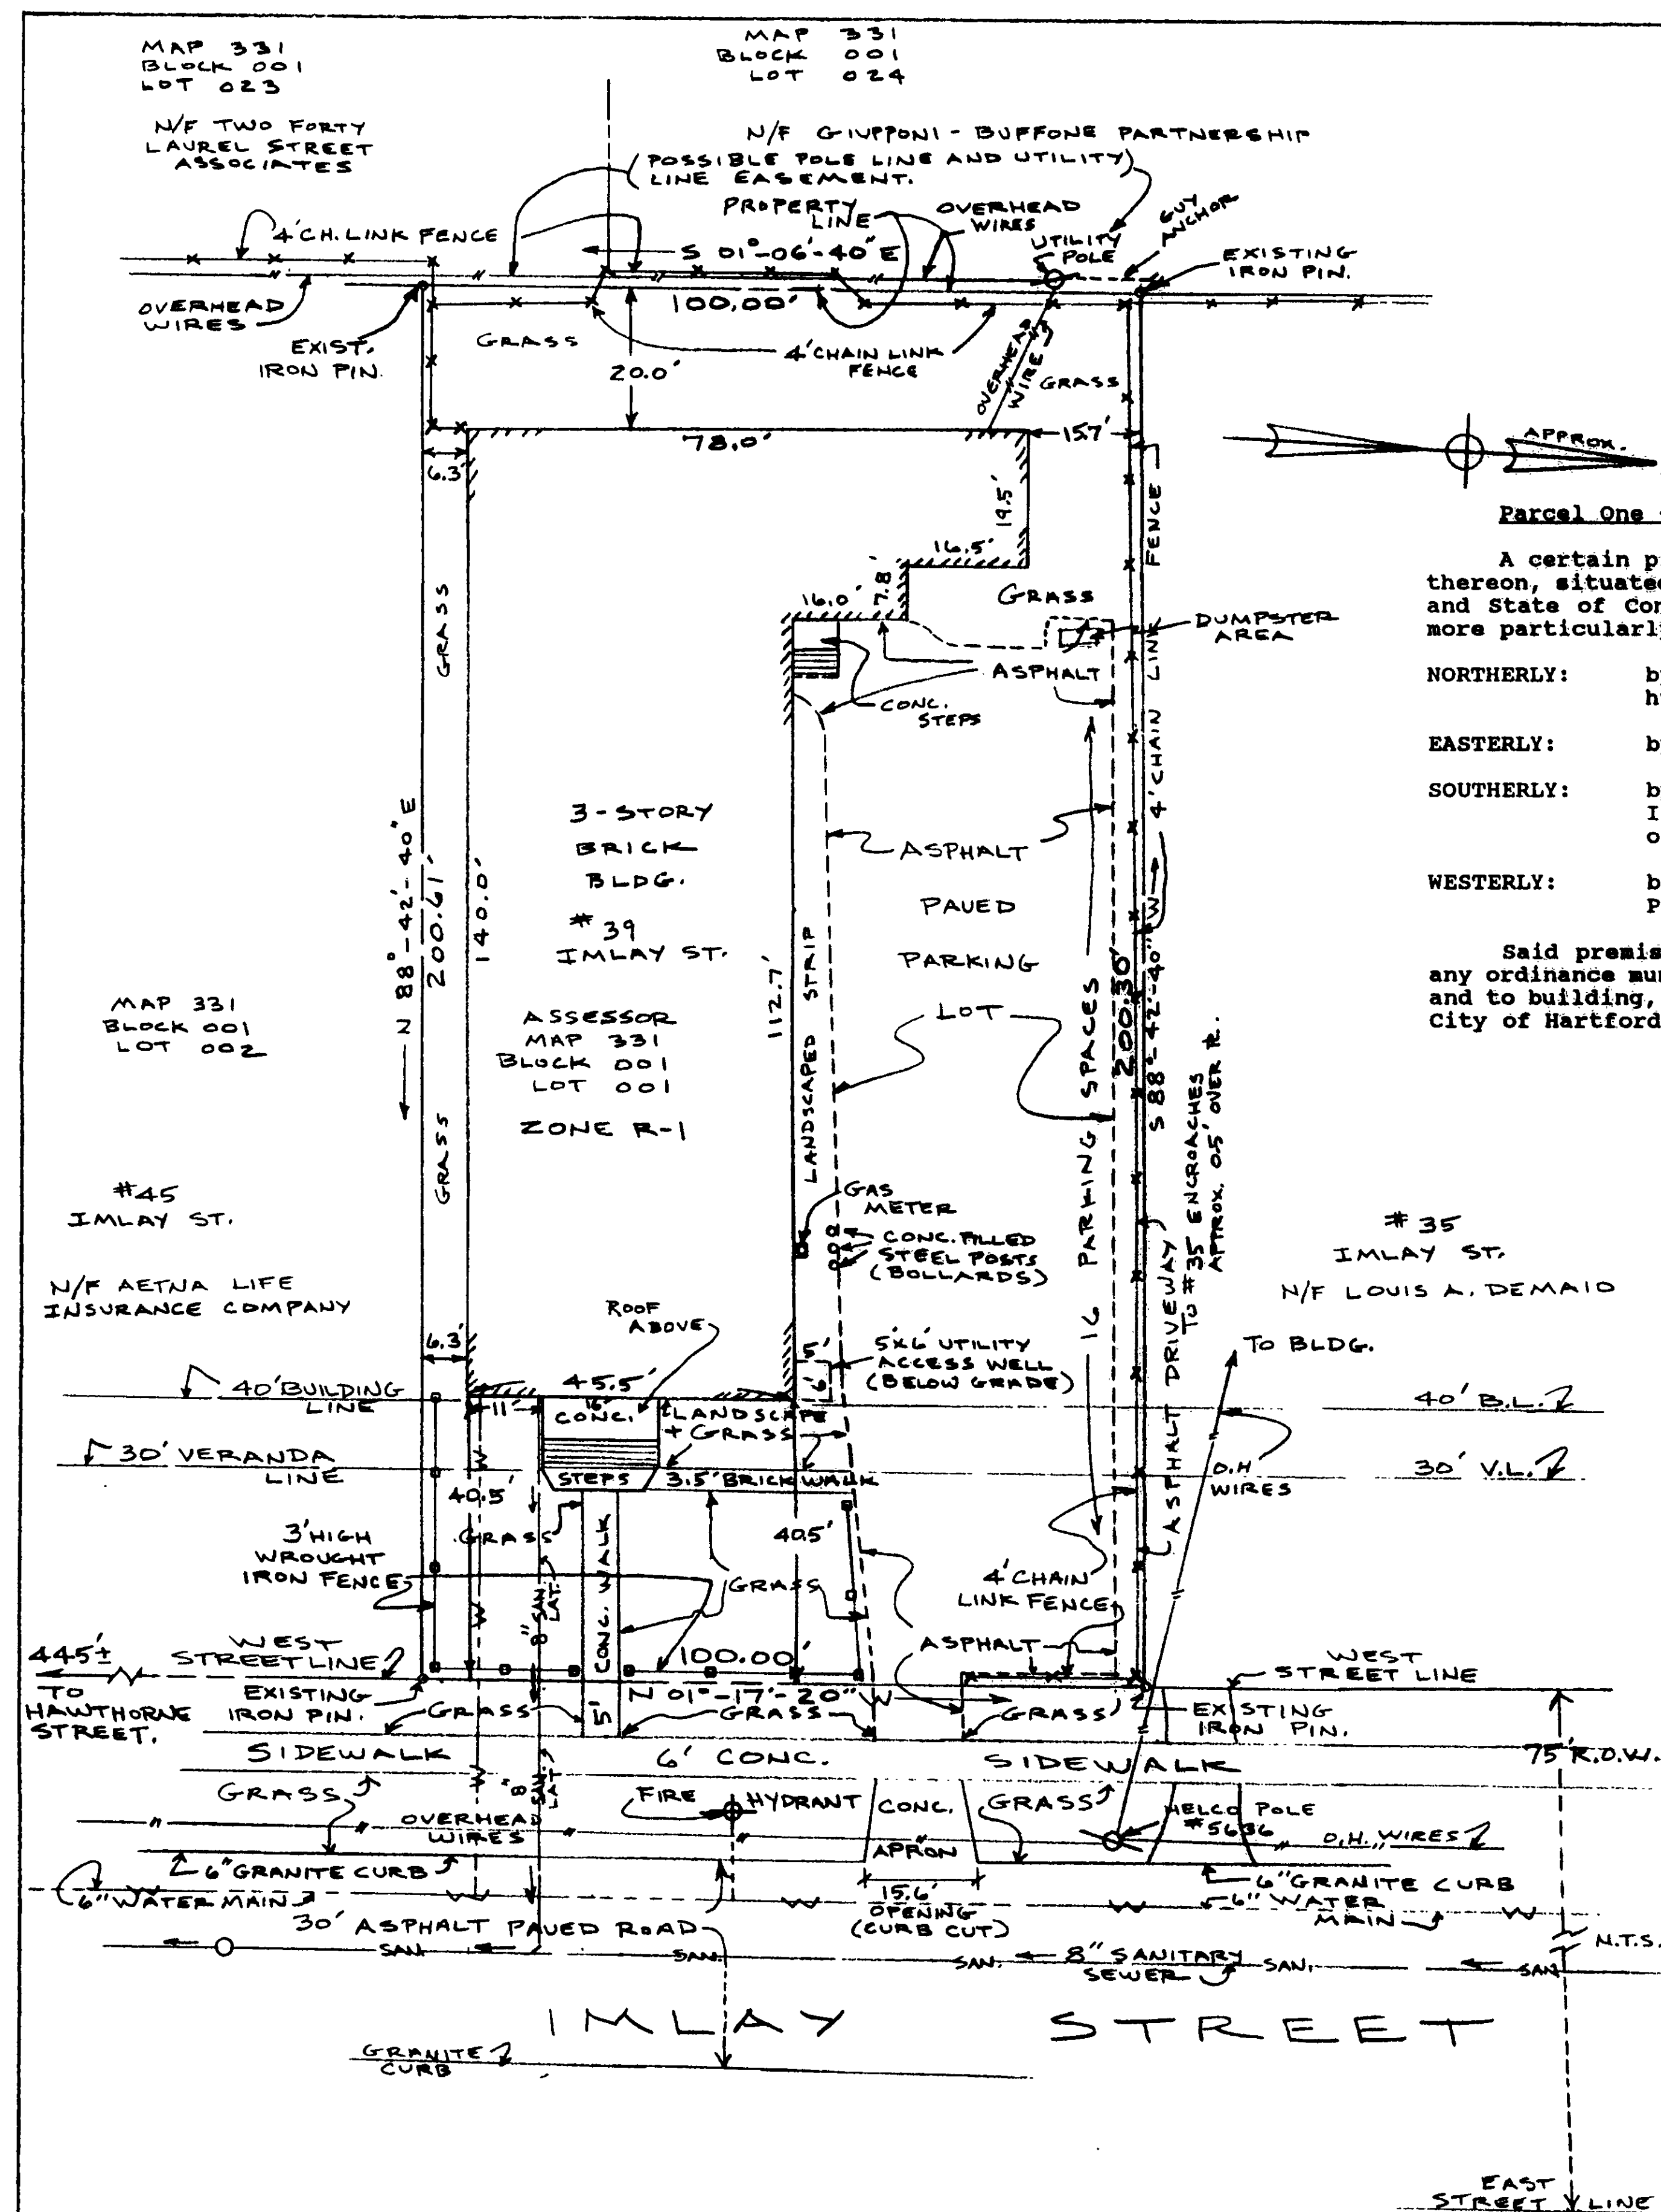

A certain piece or parcel of land with the improvements thereon, situated in the Town of Hartford, County of Hartford and State of Connecticut, known as No. 39 Imlay Street and more particularly bounded and described as follows, to wit:

NORTHERLY: by land now or formerly of Louis A. DeMaio, two hundred and three tenths (200.30) feet;

EASTERLY: by Inlay Street, one hundred (100) feet:

SOUTHERLY: by land now or formerly of Aetna Life Insurance Company, two hundred and sixty-one one-hundredths (200.61) feet; and

WESTERLY: by lands now or formerly of Giupponi-Buffone Partnership, one hundred feet (100) feet.

Said premises are subject to any and all provisions of any ordinance municipal regulation and public or private law, and to building, building line and zoning restrictions of the City of Hartford.

NOTES:

1. AREA OF PROPERTY = 20,045.40 SQ.F.
OR
0.460 AC.

2. AREA IS NOT LOCATED WITHIN THE
LIMITS OF THE 100 YEAR FLOOD.

- ### 3. LOCATION OF SHOWN UNDERGROUND

UTILITIES ARE BASED ON BEST AVAILABLE INFORMATION. OTHER UNDERGROUND UTILITIES MAY EXIST ON SITE. LOCATIONS UNKNOWN. ANYONE EXCAVATING ON THIS SITE MUST CONTACT OWNING UTILITY COMPANIES TO VERIFY LOCATIONS AND "CALL BEFORE YOU DIG."
(1-800-922-4455)


**CERTIFIED TO: THE SECRETARY OF HOUSING AND URBAN DEVELOPMENT, AND TO
MIDLAND LOAN SERVICES, L.P., AND TO ANCONA ENTERPRISES, INC.,
AND TO CONNECTICUT ATTORNEYS TITLE INSURANCE COMPANY:**

I MADE AN ON THE GROUND SURVEY PER RECORD DESCRIPTION OF THE LAND SHOWN HEREON LOCATED IN THE CITY OF HARTFORD, STATE OF CONNECTICUT, ON JULY 28, 1997 AND THAT IT AND THIS MAP WAS MADE IN ACCORDANCE WITH THE HUD SURVEY INSTRUCTIONS AND CERTIFICATE, FORM HUD-92457, AND MEET THE REQUIREMENTS FOR AN URBAN SURVEY, AS DEFINED IN THE "MINIMUM STANDARD DETAIL REQUIREMENTS FOR ALTA/ACSM LAND TITLE SURVEY," DATED 1992.

TO THE BEST OF MY KNOWLEDGE, BELIEF, AND INFORMATION, EXCEPT AS SHOWN HEREON:
THERE ARE NO ENCROACHMENTS EITHER WAY ACROSS PROPERTY LINES; TITLE LINES
AND LINES OF ACTUAL POSSESSION ARE THE SAME; AND THE PREMISES ARE FREE OF
ANY 100/500 YEAR RETURN FREQUENCY FLOOD HAZARD, AND SUCH FLOOD FREE CONDITION
IS SHOWN ON THE FEDERAL FLOOD INSURANCE RATE MAP, COMMUNITY PANEL
NO. 095000-006 B.

Peter Parizo 8-7-97
PETER PARIZO, L.S. 14653


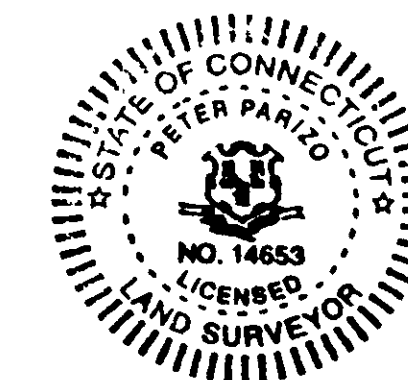

**PETER PARIZO
SURVEYING AND ENGINEERING
538 SOUTH MAIN STREET
WEST HARTFORD, CT 06110
(860) 581-0238
PETER PARIZO, P.E.L.S.**


