

NOTES

- 1) THIS SURVEY HAS BEEN PREPARED IN ACCORDANCE WITH THE REGULATIONS OF CONNECTICUT SURVEYING AGENCIES.
- 2) THIS IS A CLASS "A-2" SURVEY, AS SET FORTH IN THE MINIMUM STANDARDS FOR SURVEYS AND MADE IN THE STATE OF CONN. ENDORSED BY THE CONNECTICUT ASSOCIATION OF LAND SURVEYORS, INC.
- 3) THE BOUNDARY DETERMINATION CATEGORY IS A LOCATION IMPROVEMENT SURVEY BASED UPON THE REFERENCES NOTED HEREON.
- 4) THIS PROPERTY SURVEY CONFORMS TO CLASS "A-2" HORIZONTAL ACCURACY.

TO MY KNOWLEDGE AND BELIEF, THIS SURVEY IS SUBSTANTIALLY
CORRECT AS NOTED HEREON

Paul H. Judge

(THIS PLAN SHOULD NOT BE CONSIDERED VALID WITHOUT MY LIVE
SIGNATURE AND EMBOSSSED SEAL)

Re: Property of S. Hillman Property of J.F. Coombs
Alfred T. Delillo Freeman
 Plans for Long Basement Grantor 1
 by John Fornino
Archangel T Delillo
Theresa F Ryan
 To Grantee Ricardo L. Archangel T Delillo


N/F
Giuseppe Zimmitt.

Area 6500sq'

Area 6500sq'

5' Conc Walk

Hubbard Road

N/F
Lot #9
Sec Re. Map

N/F
Lot 8
Peter J. Champ
Sec Re. Map

N/F
Samuel Figueroa

Zone R-7

PROPERTY OF

MINISTRY CERTIFY

ALCA SURVEY ASSOCIATES

PROPERTY OF
Ricardo L. Archangeli, Dof. 116
22 N. 5th St. Road
1/2 East John Corvino
Archangeli, Dof. 116
Thomas A. Corvino
22 N. 5th St. Road
TOWN OF HARTFORD


I HEREBY CERTIFY

THAT THIS MAP & SURVEY WERE PREPARED IN
ACCORDANCE WITH THE STANDARDS OF CLASS A2
1974.

ALCA SURVEY ASSOCIATES

CARL H. JAEGER L.S. 7763
WETHERSFIELD, CONN.

SCALE: 1" = 10' SHEET
DATE 8/19/97 1 OF 2

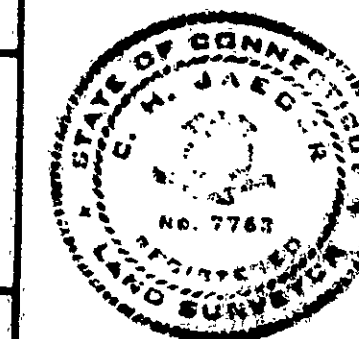

2257

INCHES 1 2 3