


The portion of Allendale Rd. shown on this map is an established public Road on the map City of Hartford, 08/11/17
Survey sponsor:

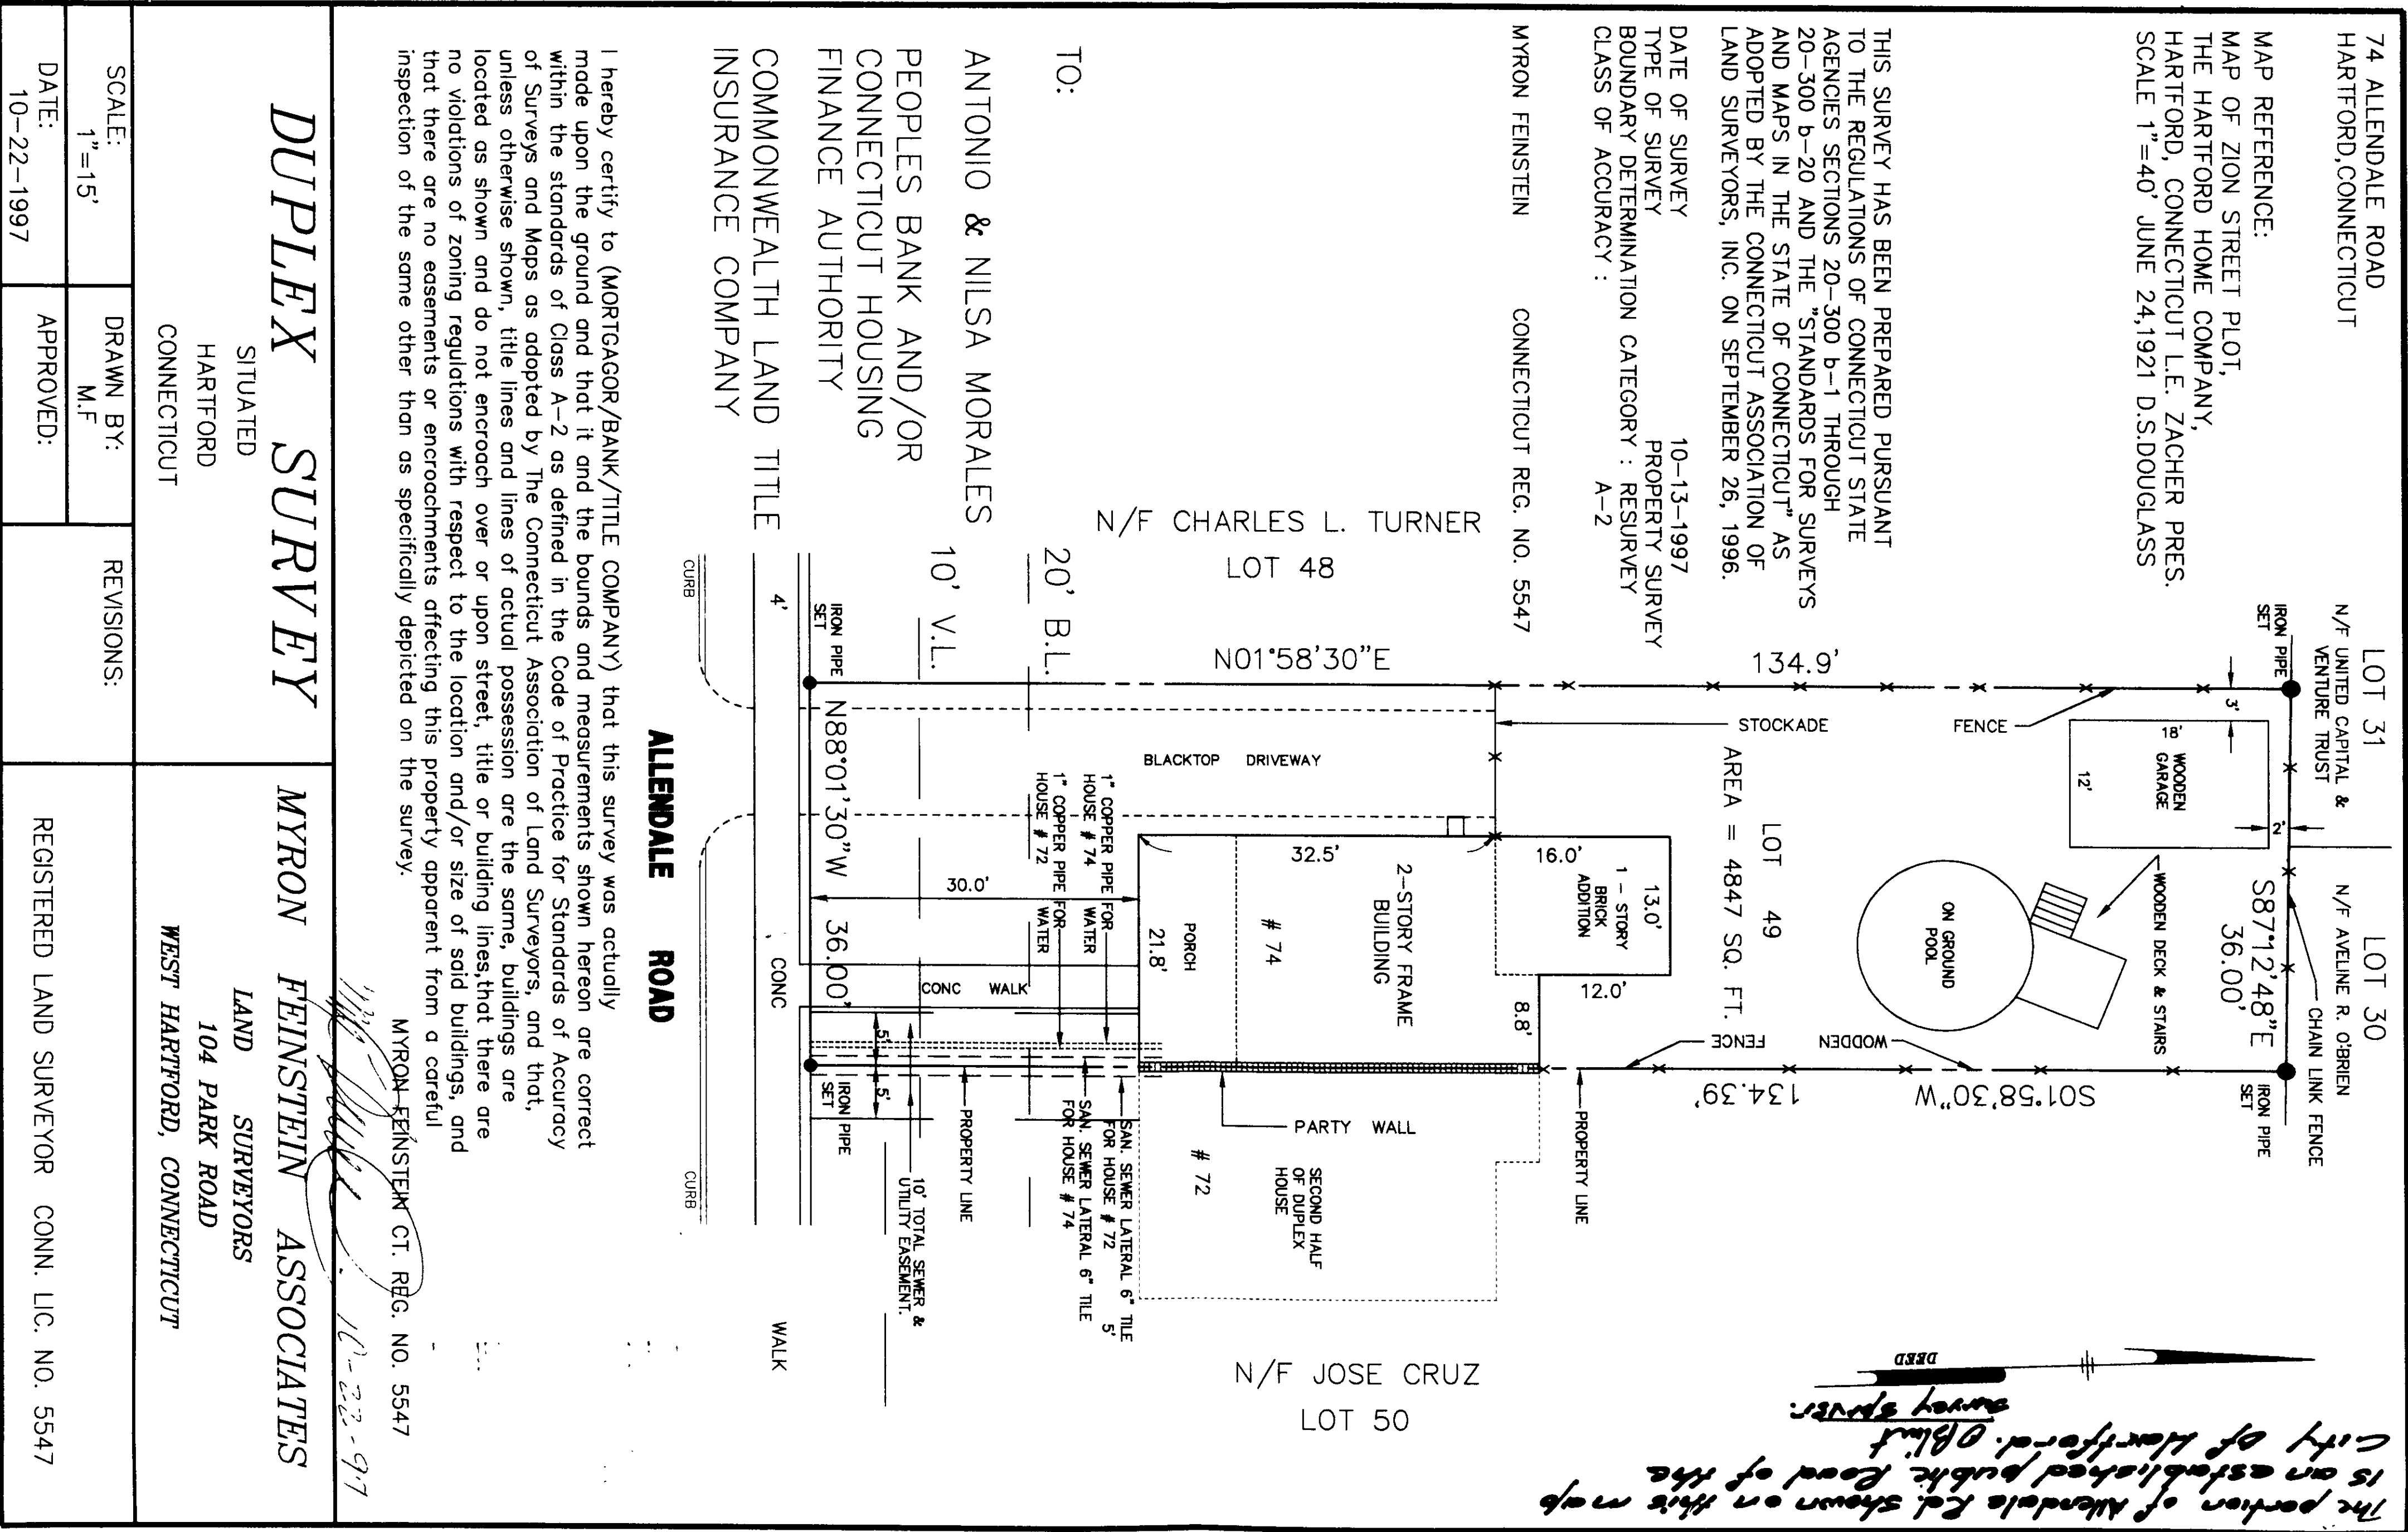

2260
EPH 54