

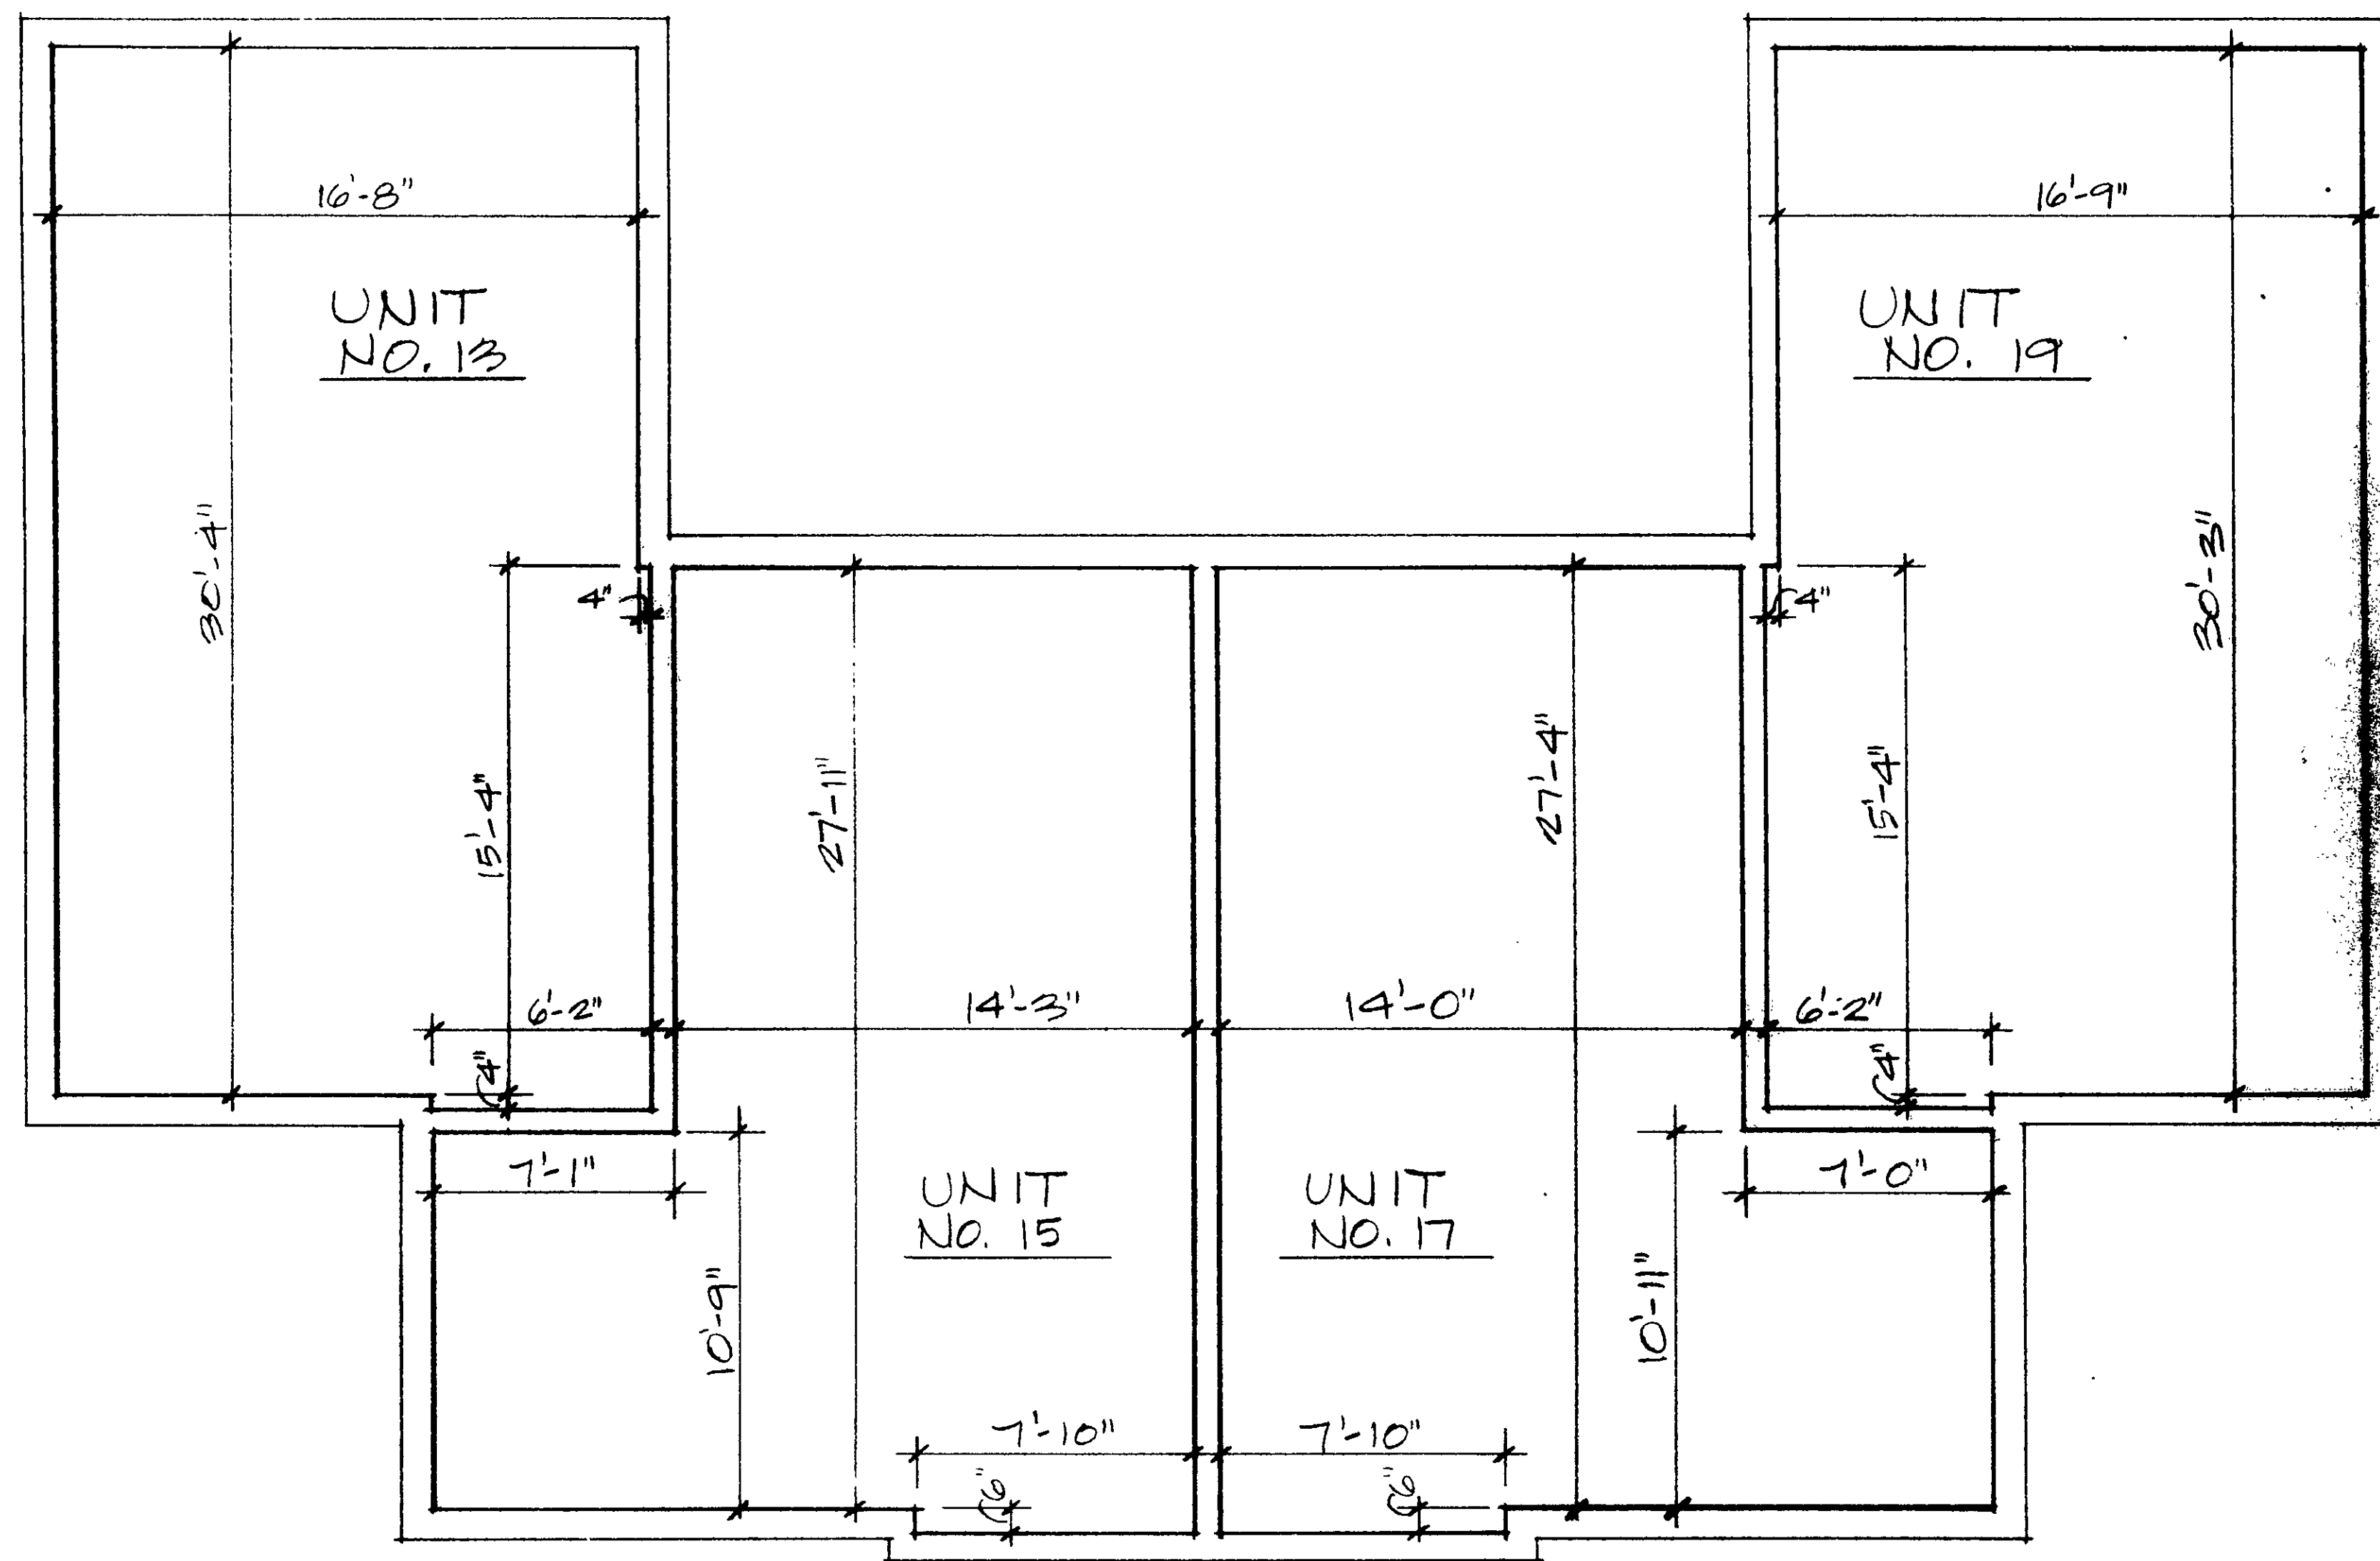


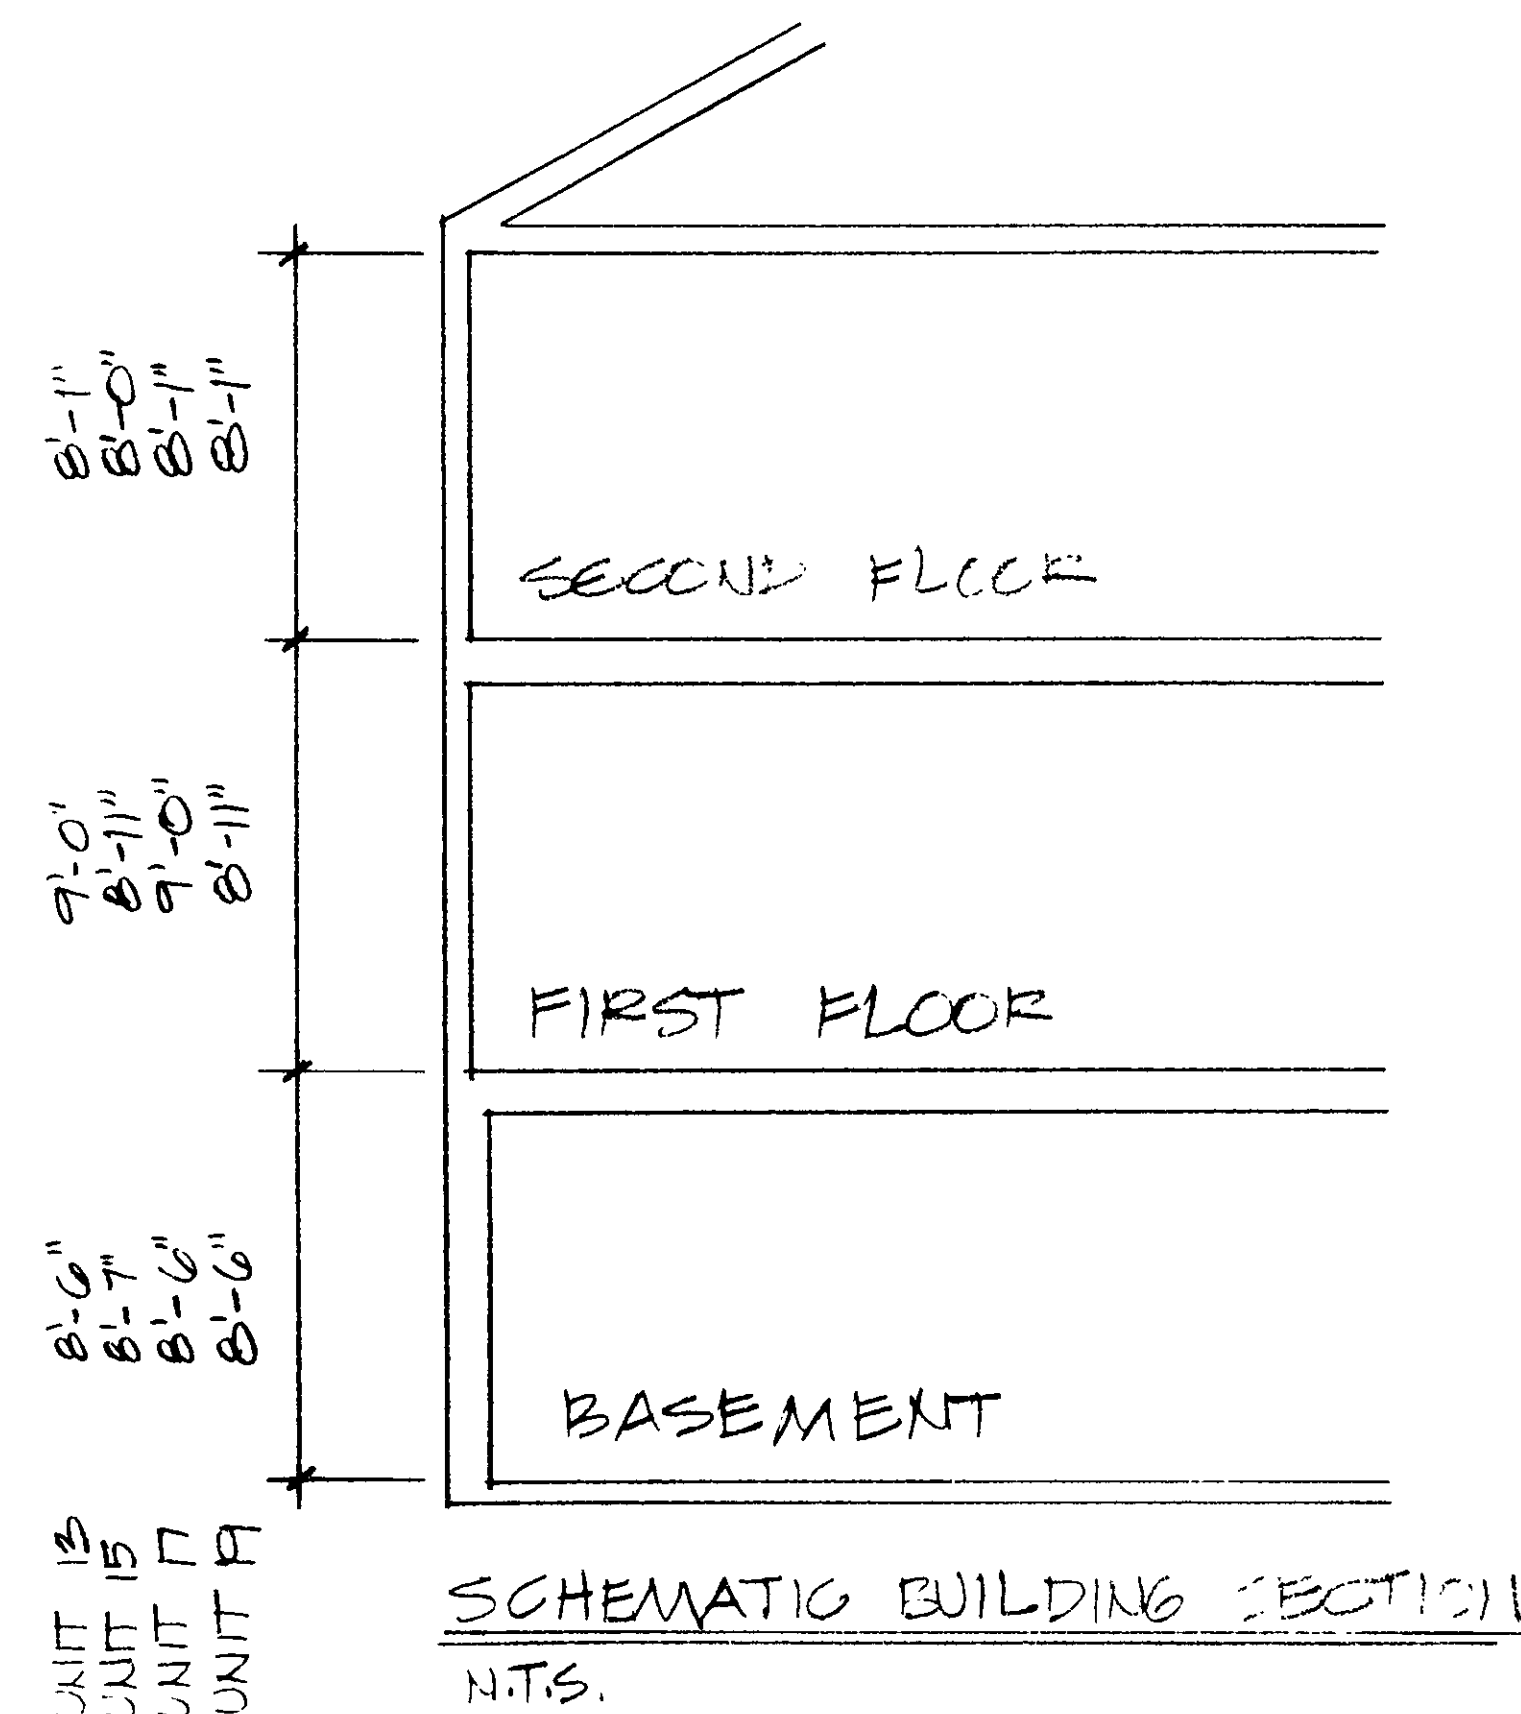

SCHEMATIC BASEMENT PLAN
1/4"=1'-0"

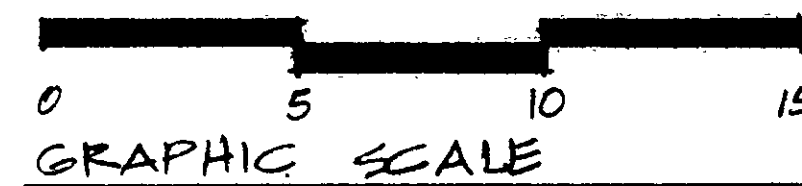

SCHEMATIC BUILDING SECTION
N.T.S.

CERTIFICATE


I HEREBY CERTIFY THAT THESE PLANS CONTAIN ALL OF THE INFORMATION REQUIRED IN ACCORDANCE WITH CONNECTICUT GENERAL STATUTES SECTION 47-228(D) OF THE COMMON INTEREST OWNERSHIP ACT.

Richard Abrahams
RICHARD ABRAHAMS, A.I.A.
ARCHITECT

4551
REGISTRATION NO.

THE WORD CERTIFY IS AN EXPRESSION OF PROFESSIONAL OPINION WHICH IS BASED UPON MY BEST KNOWLEDGE, INFORMATION, AND BELIEF, AND AS SUCH IT CONSTITUTES NEITHER A GUARANTEE NOR A WARRANTY EXPRESSED OR IMPLIED

SCHEDULE A-4

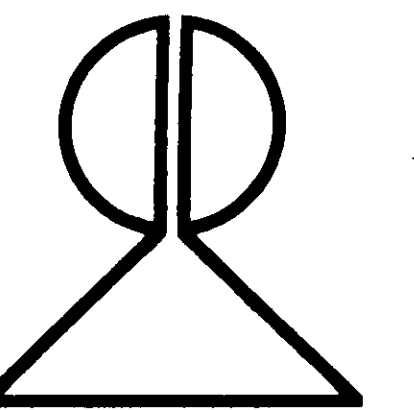

RICHARD ABRAHAMS
A.I.A.
ARCHITECT

232 Indian Hill Trail
Glastonbury, CT 06033
(860) 646-0798

DATE
12 NOV. 1992
SCALE
NOTED
DESIGNED BY
RWA
CHECKED BY
SWA.
REV.

BUFIELD STREET CO-OPERATIVE ASSOCIATION
15, 17, 19 BUFIELD ST. HARTFORD, CT.
HARTFORD AREA HARTFORD FOR HUMANITY

**A
i**