


2290

2290-2

#2290-2

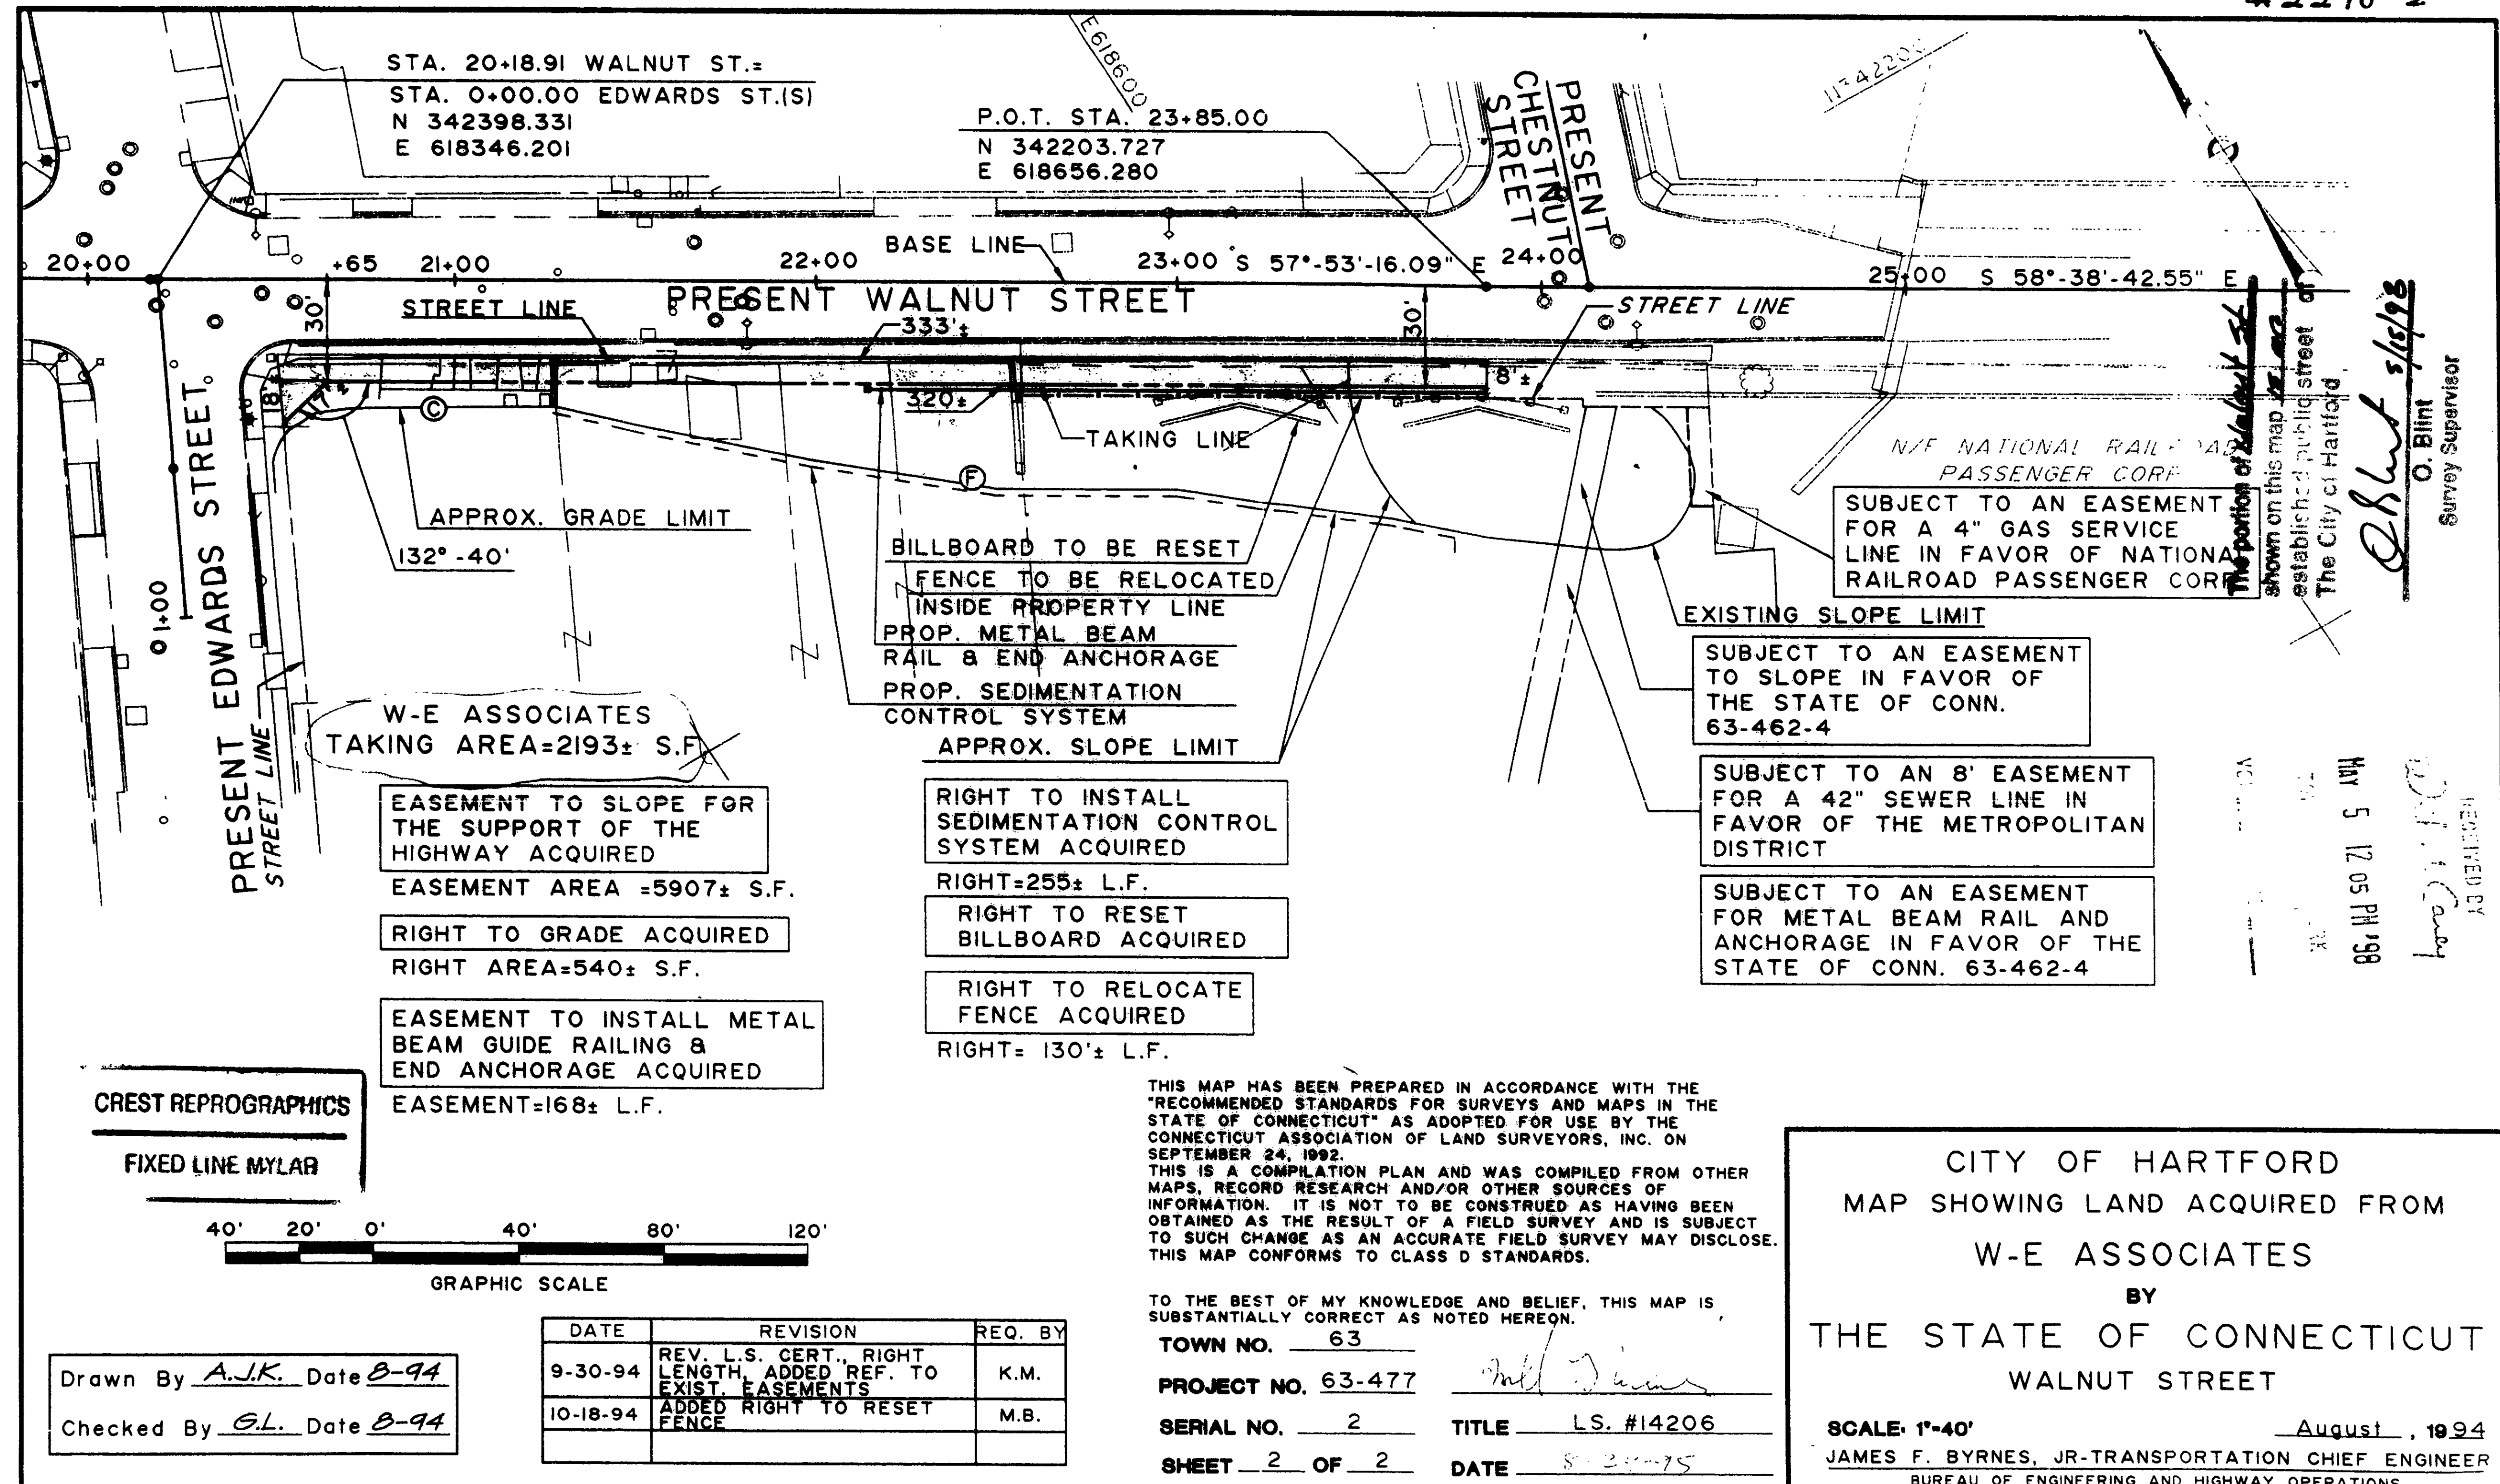

2290-2

0 INCHES 1 2 3 4