
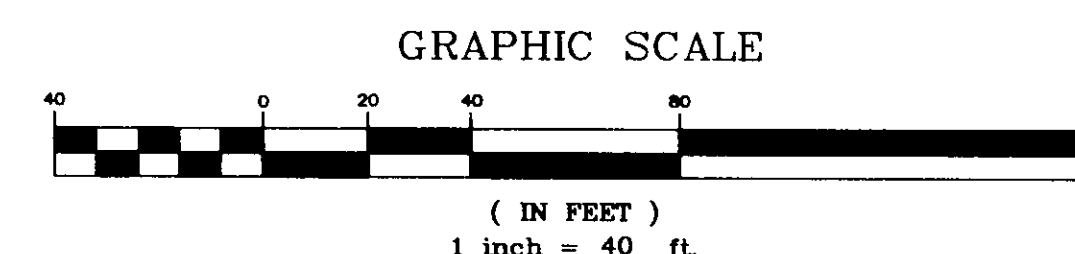


#2306

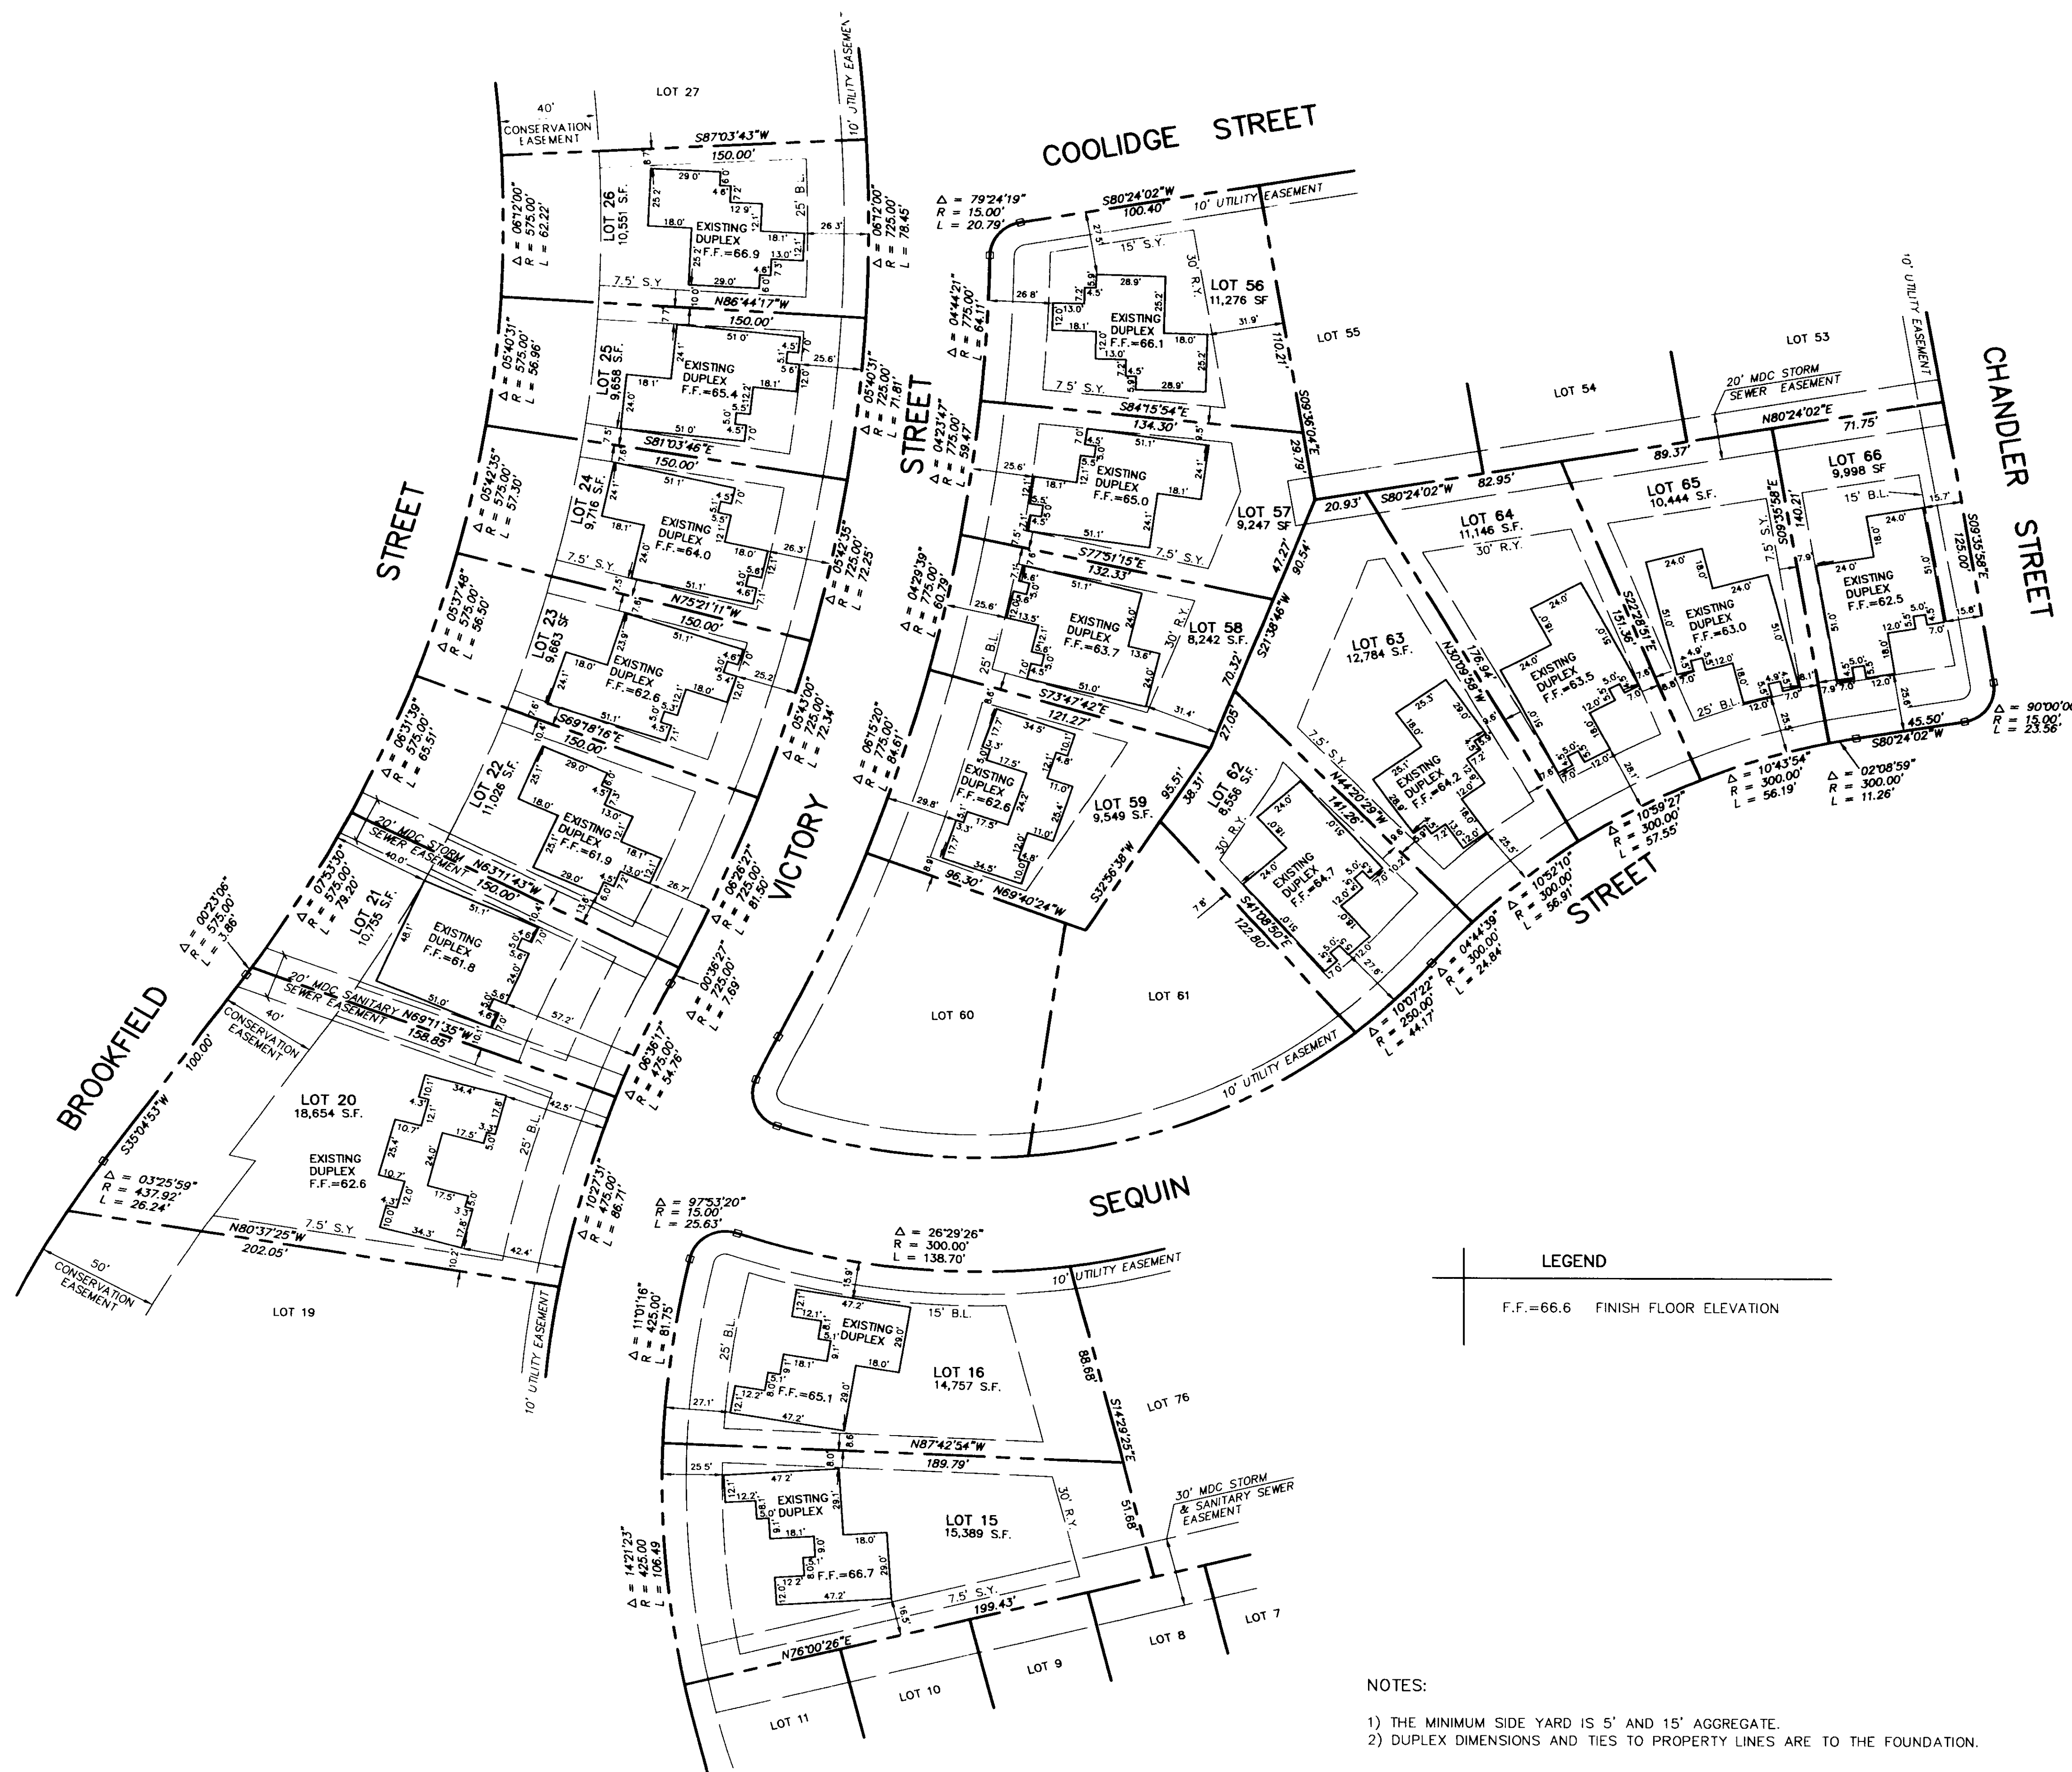

LEGEND
F.F.=66.6 FINISH FLOOR ELEVATION

NOTES:

- 1) THE MINIMUM SIDE YARD IS 5' AND 15' AGGREGATE.
- 2) DUPLEX DIMENSIONS AND TIES TO PROPERTY LINES ARE TO THE FOUNDATION.

MAP REFERENCE:

1) REDEVELOPMENT OF CHARTER OAK TERRACE- D SECTION FOR THE HOUSING AUTHORITY OF THE CITY OF HARTFORD, CONTRACT NO. 1280-97, ZONING CONFORMANCE, PLOT LAYOUT PLAN, SCALE 1"=40', DATE JULY 30, 1997, REVISED 10-29-97, SHEET C-1, TORRES ENGINEERING, INC., MILTON, LEWIS, HOWARD ASSOCIATES, INC."

THIS MAP IS VALID ONLY IF IT BEARS THE ORIGINAL SIGNATURE AND EMBOSSED SEAL OF THE SURVEYOR.

THIS SURVEY AND MAP HAS BEEN PREPARED IN ACCORDANCE WITH SECTIONS 20-300b-1 THROUGH 20-300b-20 OF THE REGULATIONS OF CONNECTICUT STATE AGENCIES- "STANDARDS FOR SURVEYS AND MAPS IN THE STATE OF CONNECTICUT" AS ENDORSED BY THE CONNECTICUT ASSOCIATION OF LAND SURVEYORS, INC. IT IS AN EXISTING BUILDING SURVEY BASED ON A DEPENDENT RESURVEY CONFORMING TO HORIZONTAL ACCURACY CLASS A-2. TO MY KNOWLEDGE AND BELIEF, THIS MAP IS SUBSTANTIALLY CORRECT AS NOTED HEREON.

SURVEYOR'S SIGNATURE *S.P. 78* DATE *5-28-98* LICENSE NUMBER *14649*

PREPARED FOR
THE HOUSING AUTHORITY OF THE
CITY OF HARTFORD
CHARTER OAK TERRACE- "D" SECTION
LOTS 15, 16, 20-26, 56-59 & 62-66
SEQUIN STREET & VICTORY STREET
HARTFORD, CONNECTICUT

IMPROVEMENT
LOCATION
SURVEY

Sheet
1
of
1

97164AS2.DWG 97164

#2306

