


2	3	5	9
---	---	---	---

#2359

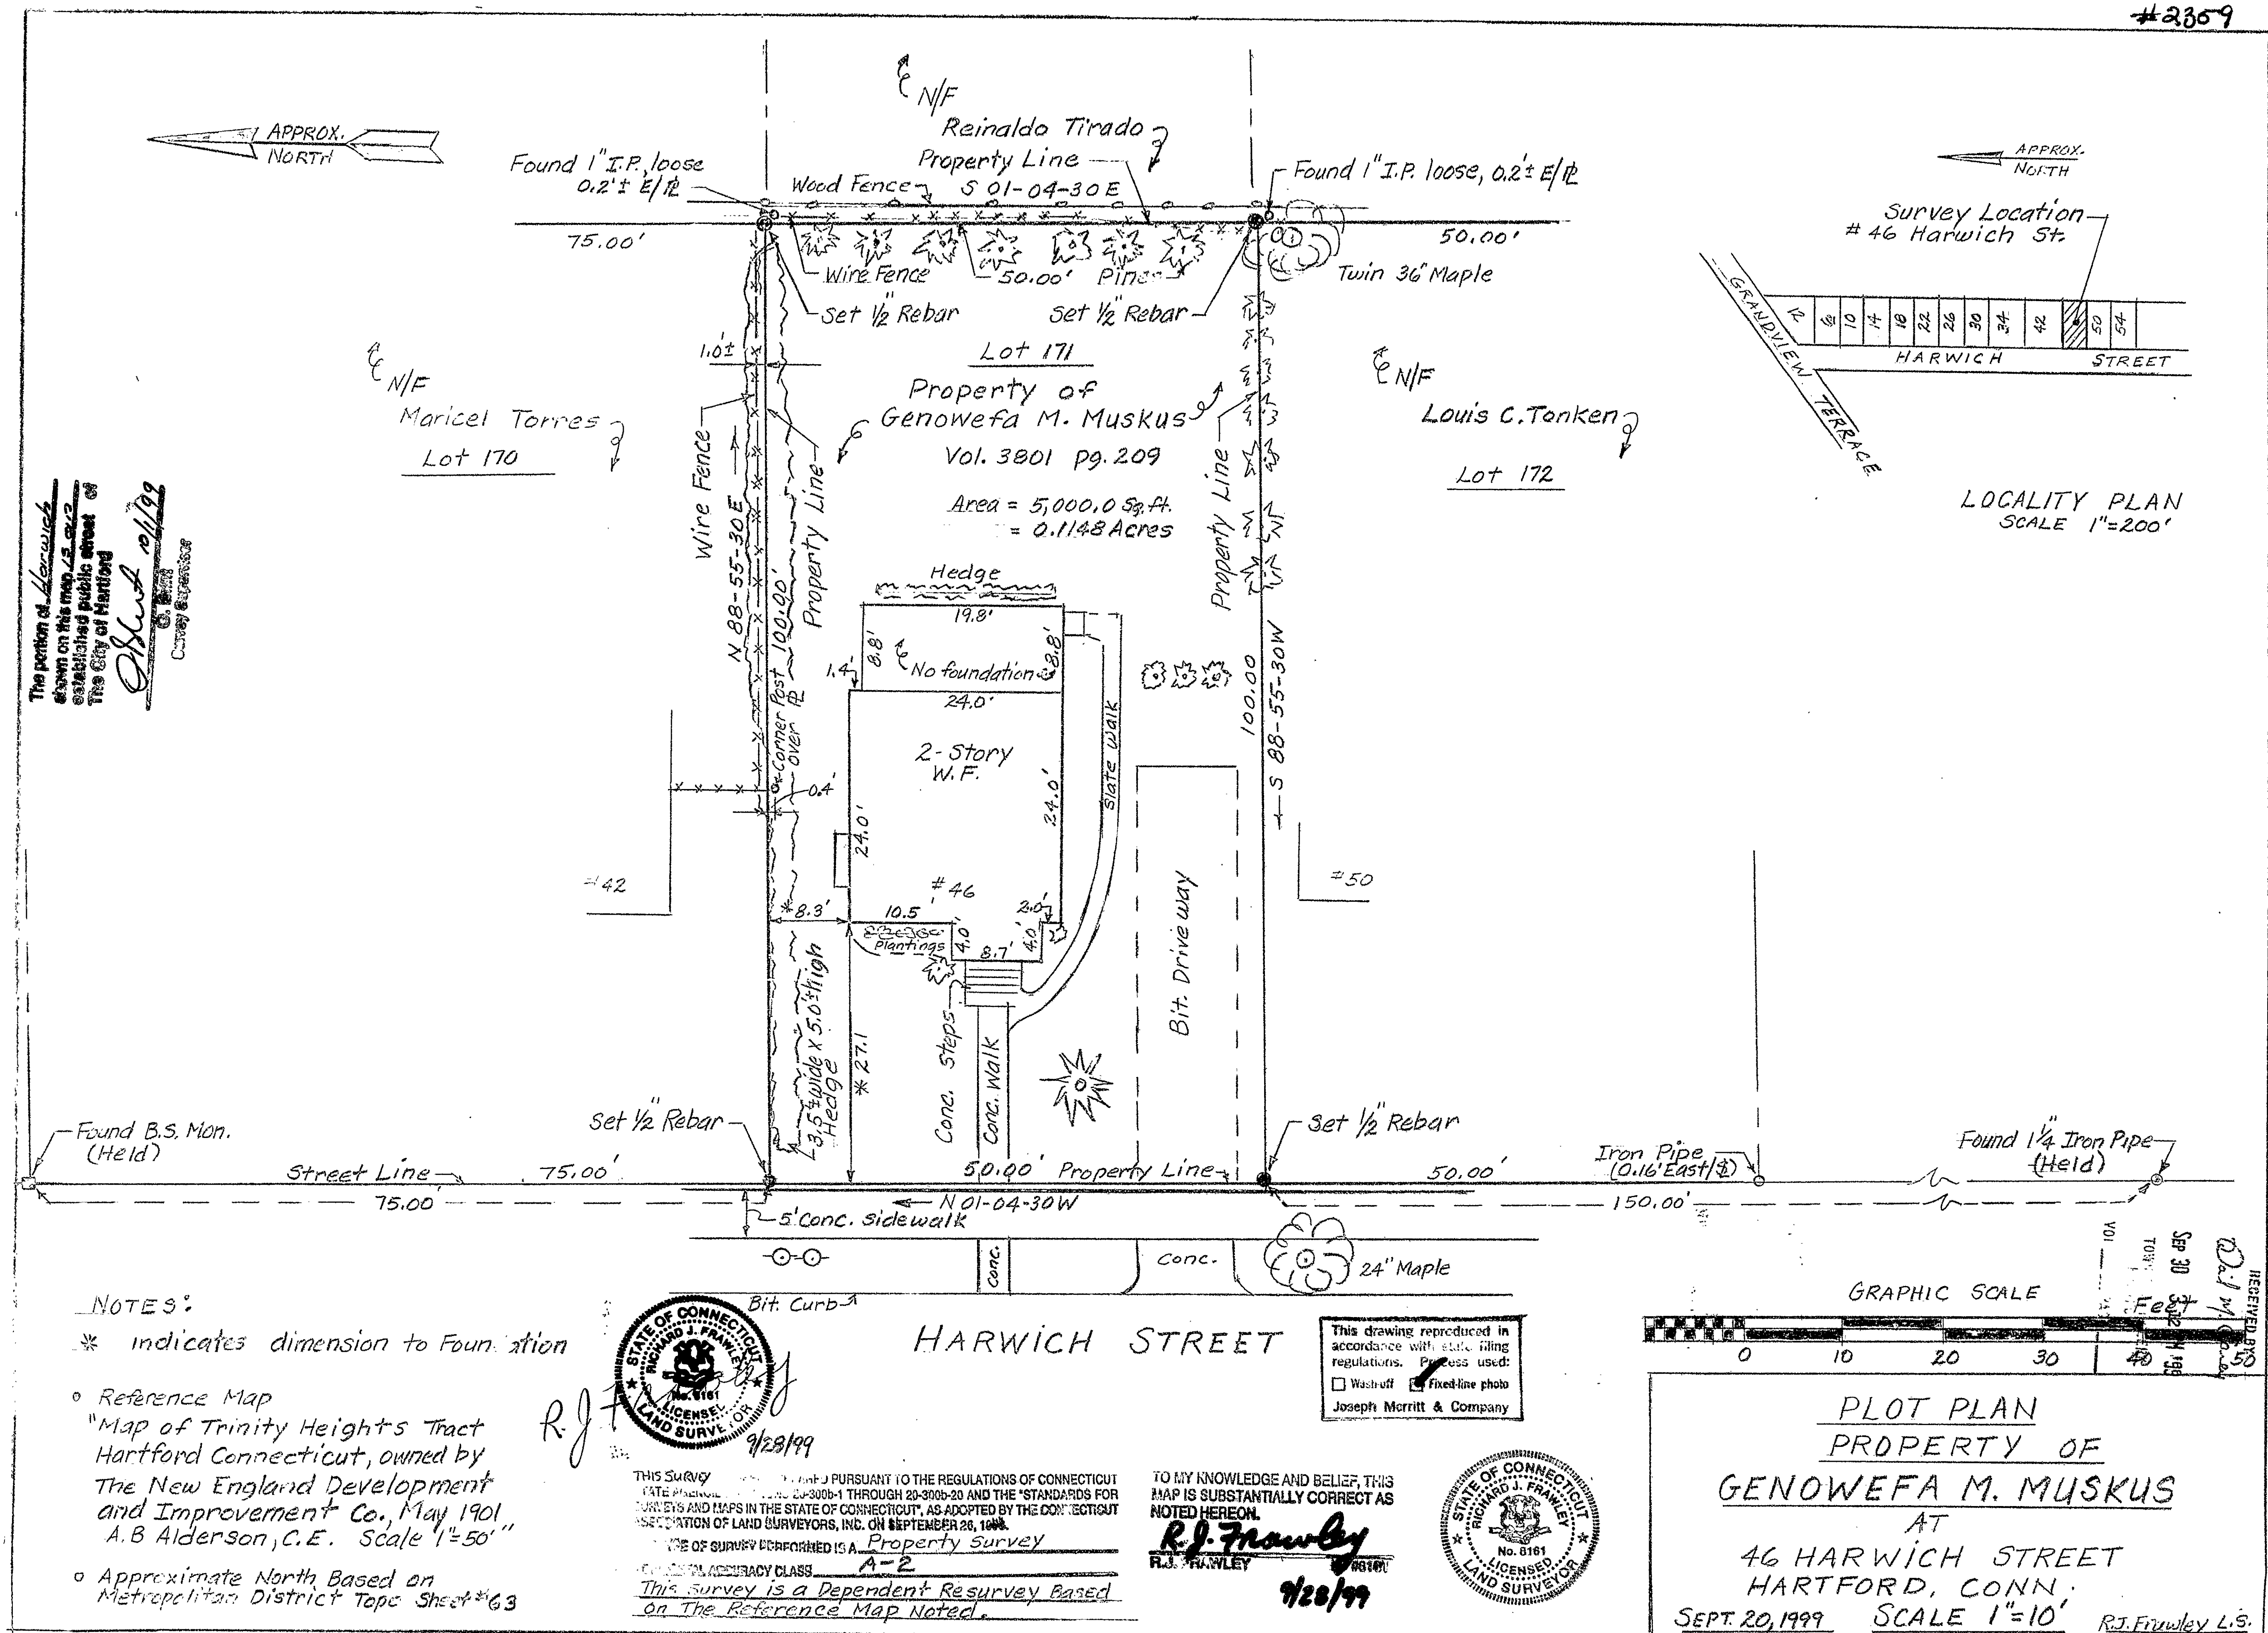

#2359

